


Survey made with 5' Theodolite and steel band

John Power
Autho Surgeon
10th Sep. 1901

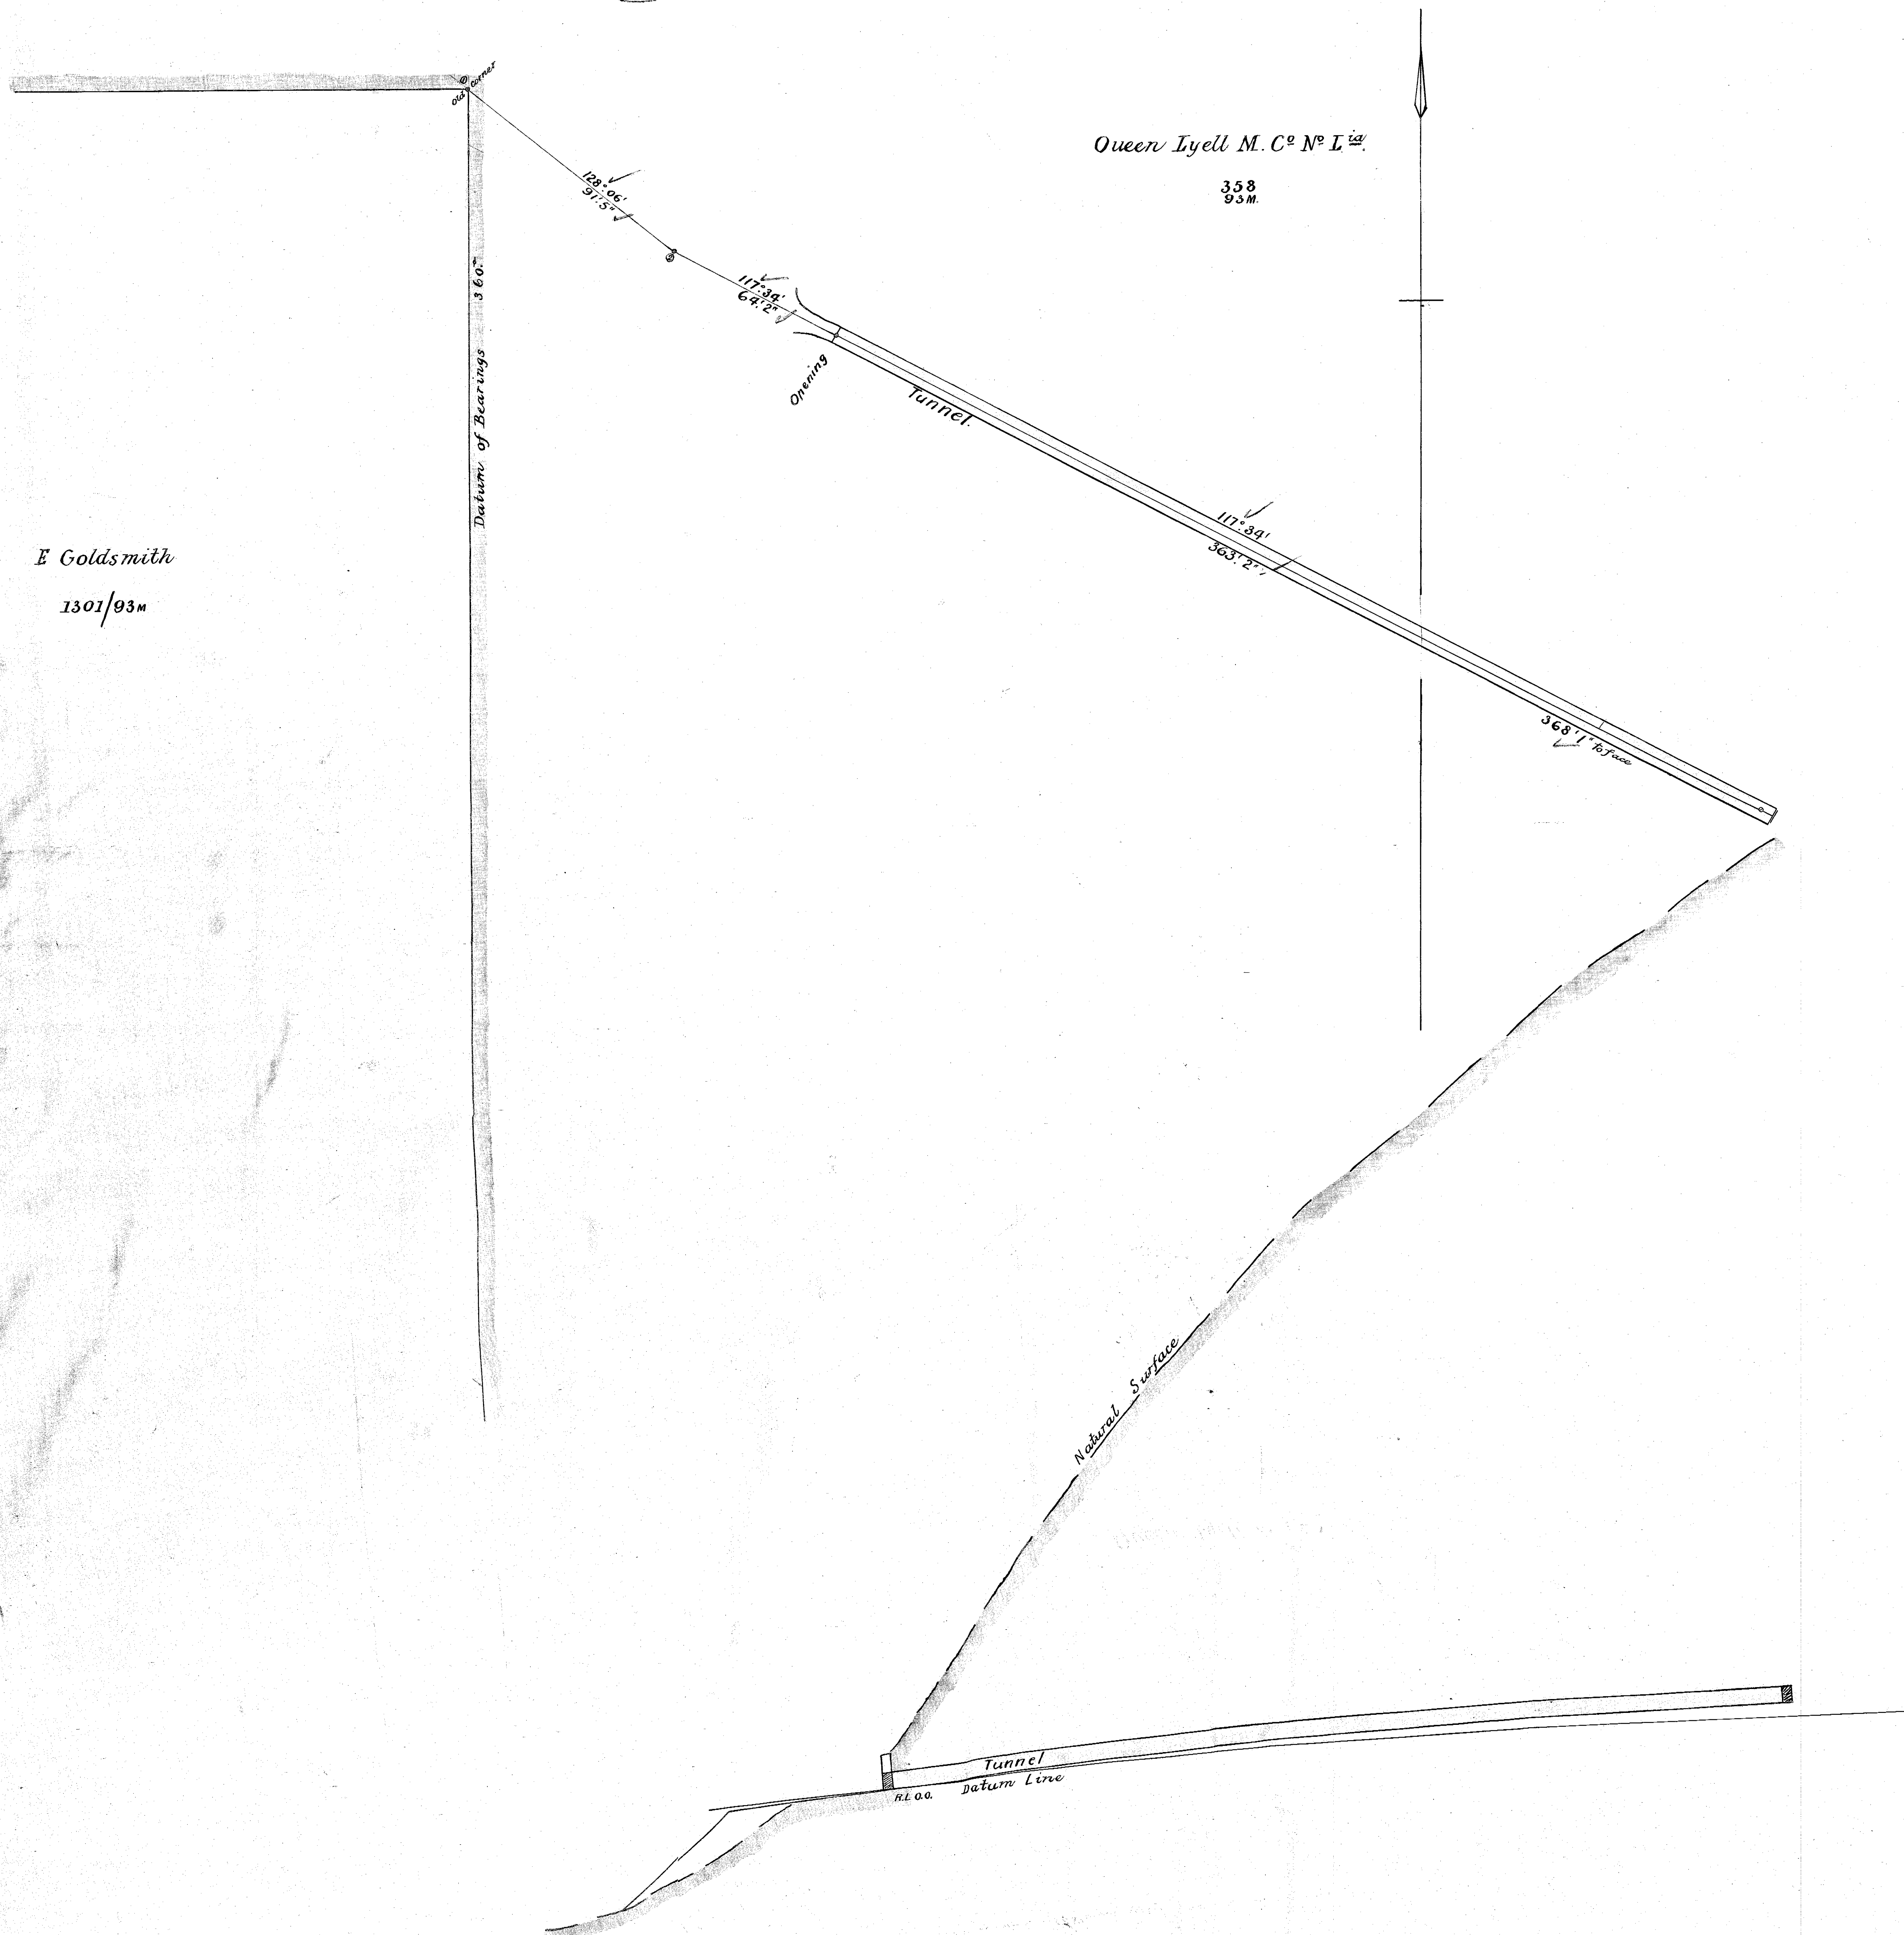

E Goldsmith

1301/93m

Queen Lyell M. C^o N^o L^{ia}.

358
93M

93M

Opening

Tunnel

117:34
36,35

363.2

368'1" to face

Natural Surface

Tunnel

naturn Linie

85

153-01

↓

10

59