


THE GREAT SOUTH COMET MINE

LONGITUDINAL SECTION

SCALE 25 FEET TO 1 INCH

No driving has been done during the 12 preceding months
The portion stoped during the 12 months is shown by hachures

W.R. Salo
Feb 18th 1903

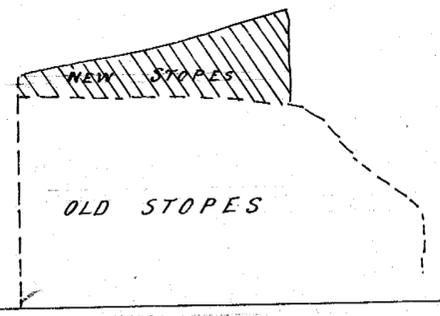

MOUTH OF ADIT

DRIVE ON LODE

WIRE STARTED

WIRE RUN DOWN 107 1/2

END OF DRIVE

Great South Comet
1903