


0154 - 006



6 SUB LEVEL

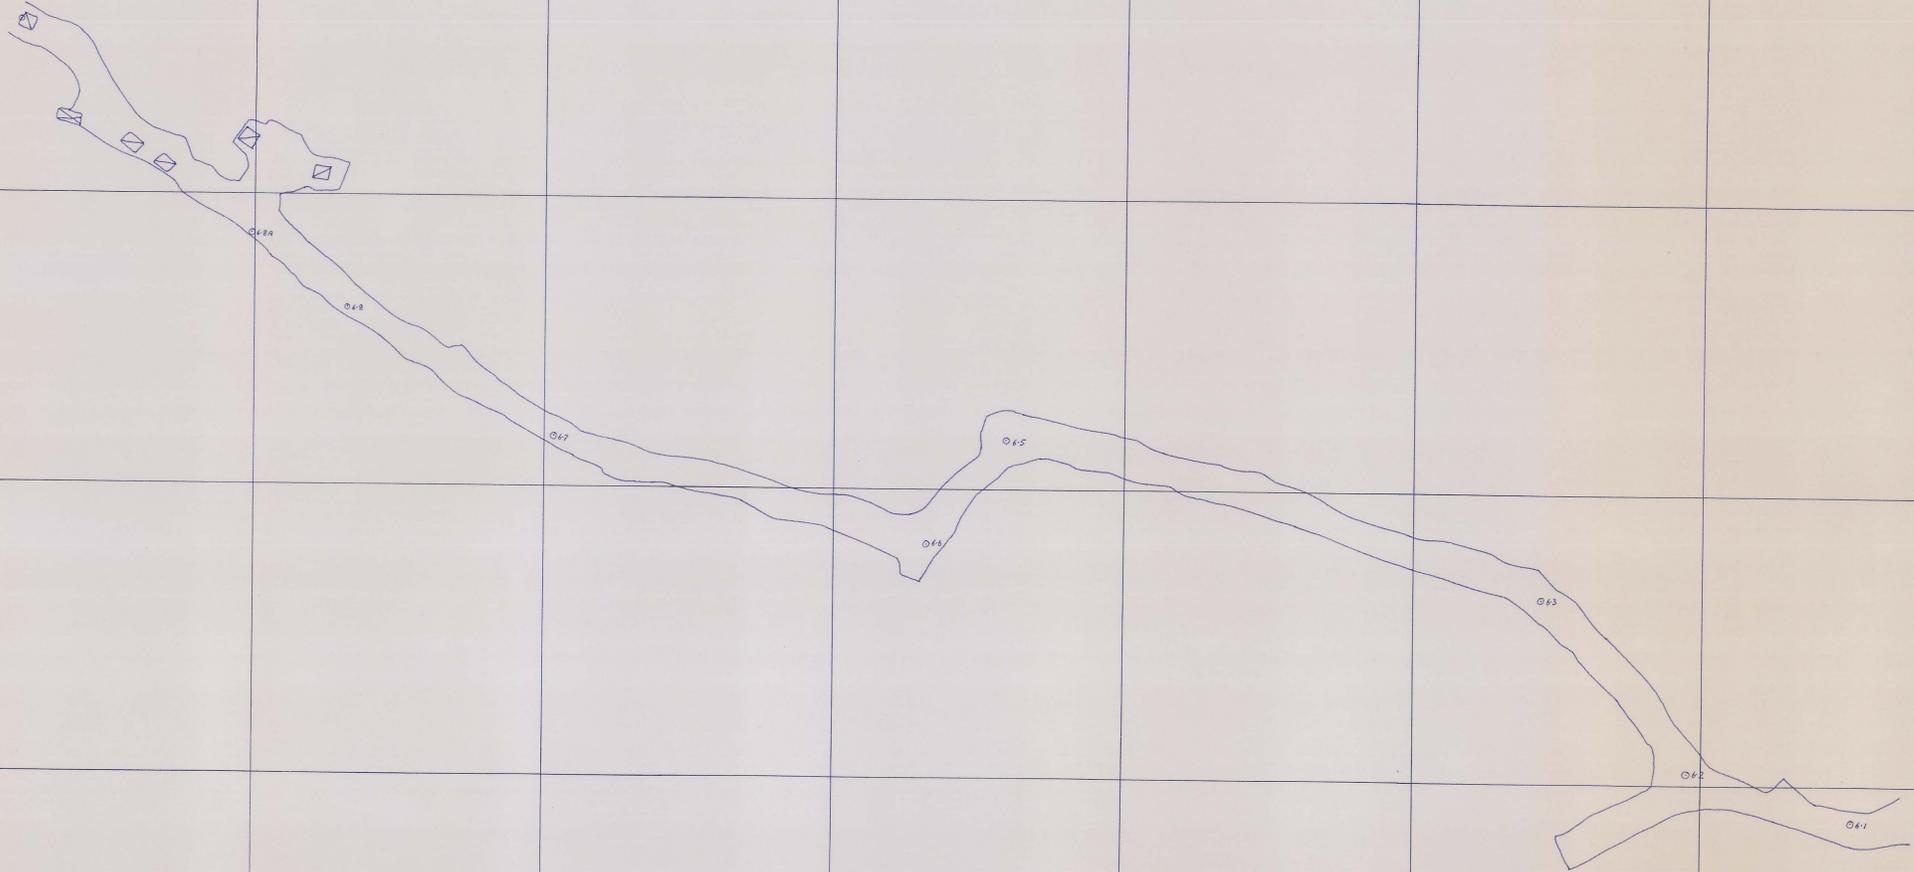

6 LEVEL



DRAWN		SOUTH COMET MINE	
TRACED		6 AND 6 SUB LEVEL	DRAWING No.
CHECKED	<i>D.J.</i>		
APPROVED		SCALE 1:250	DATE 1-1-92
		REVISION	SHEET