


0154-009

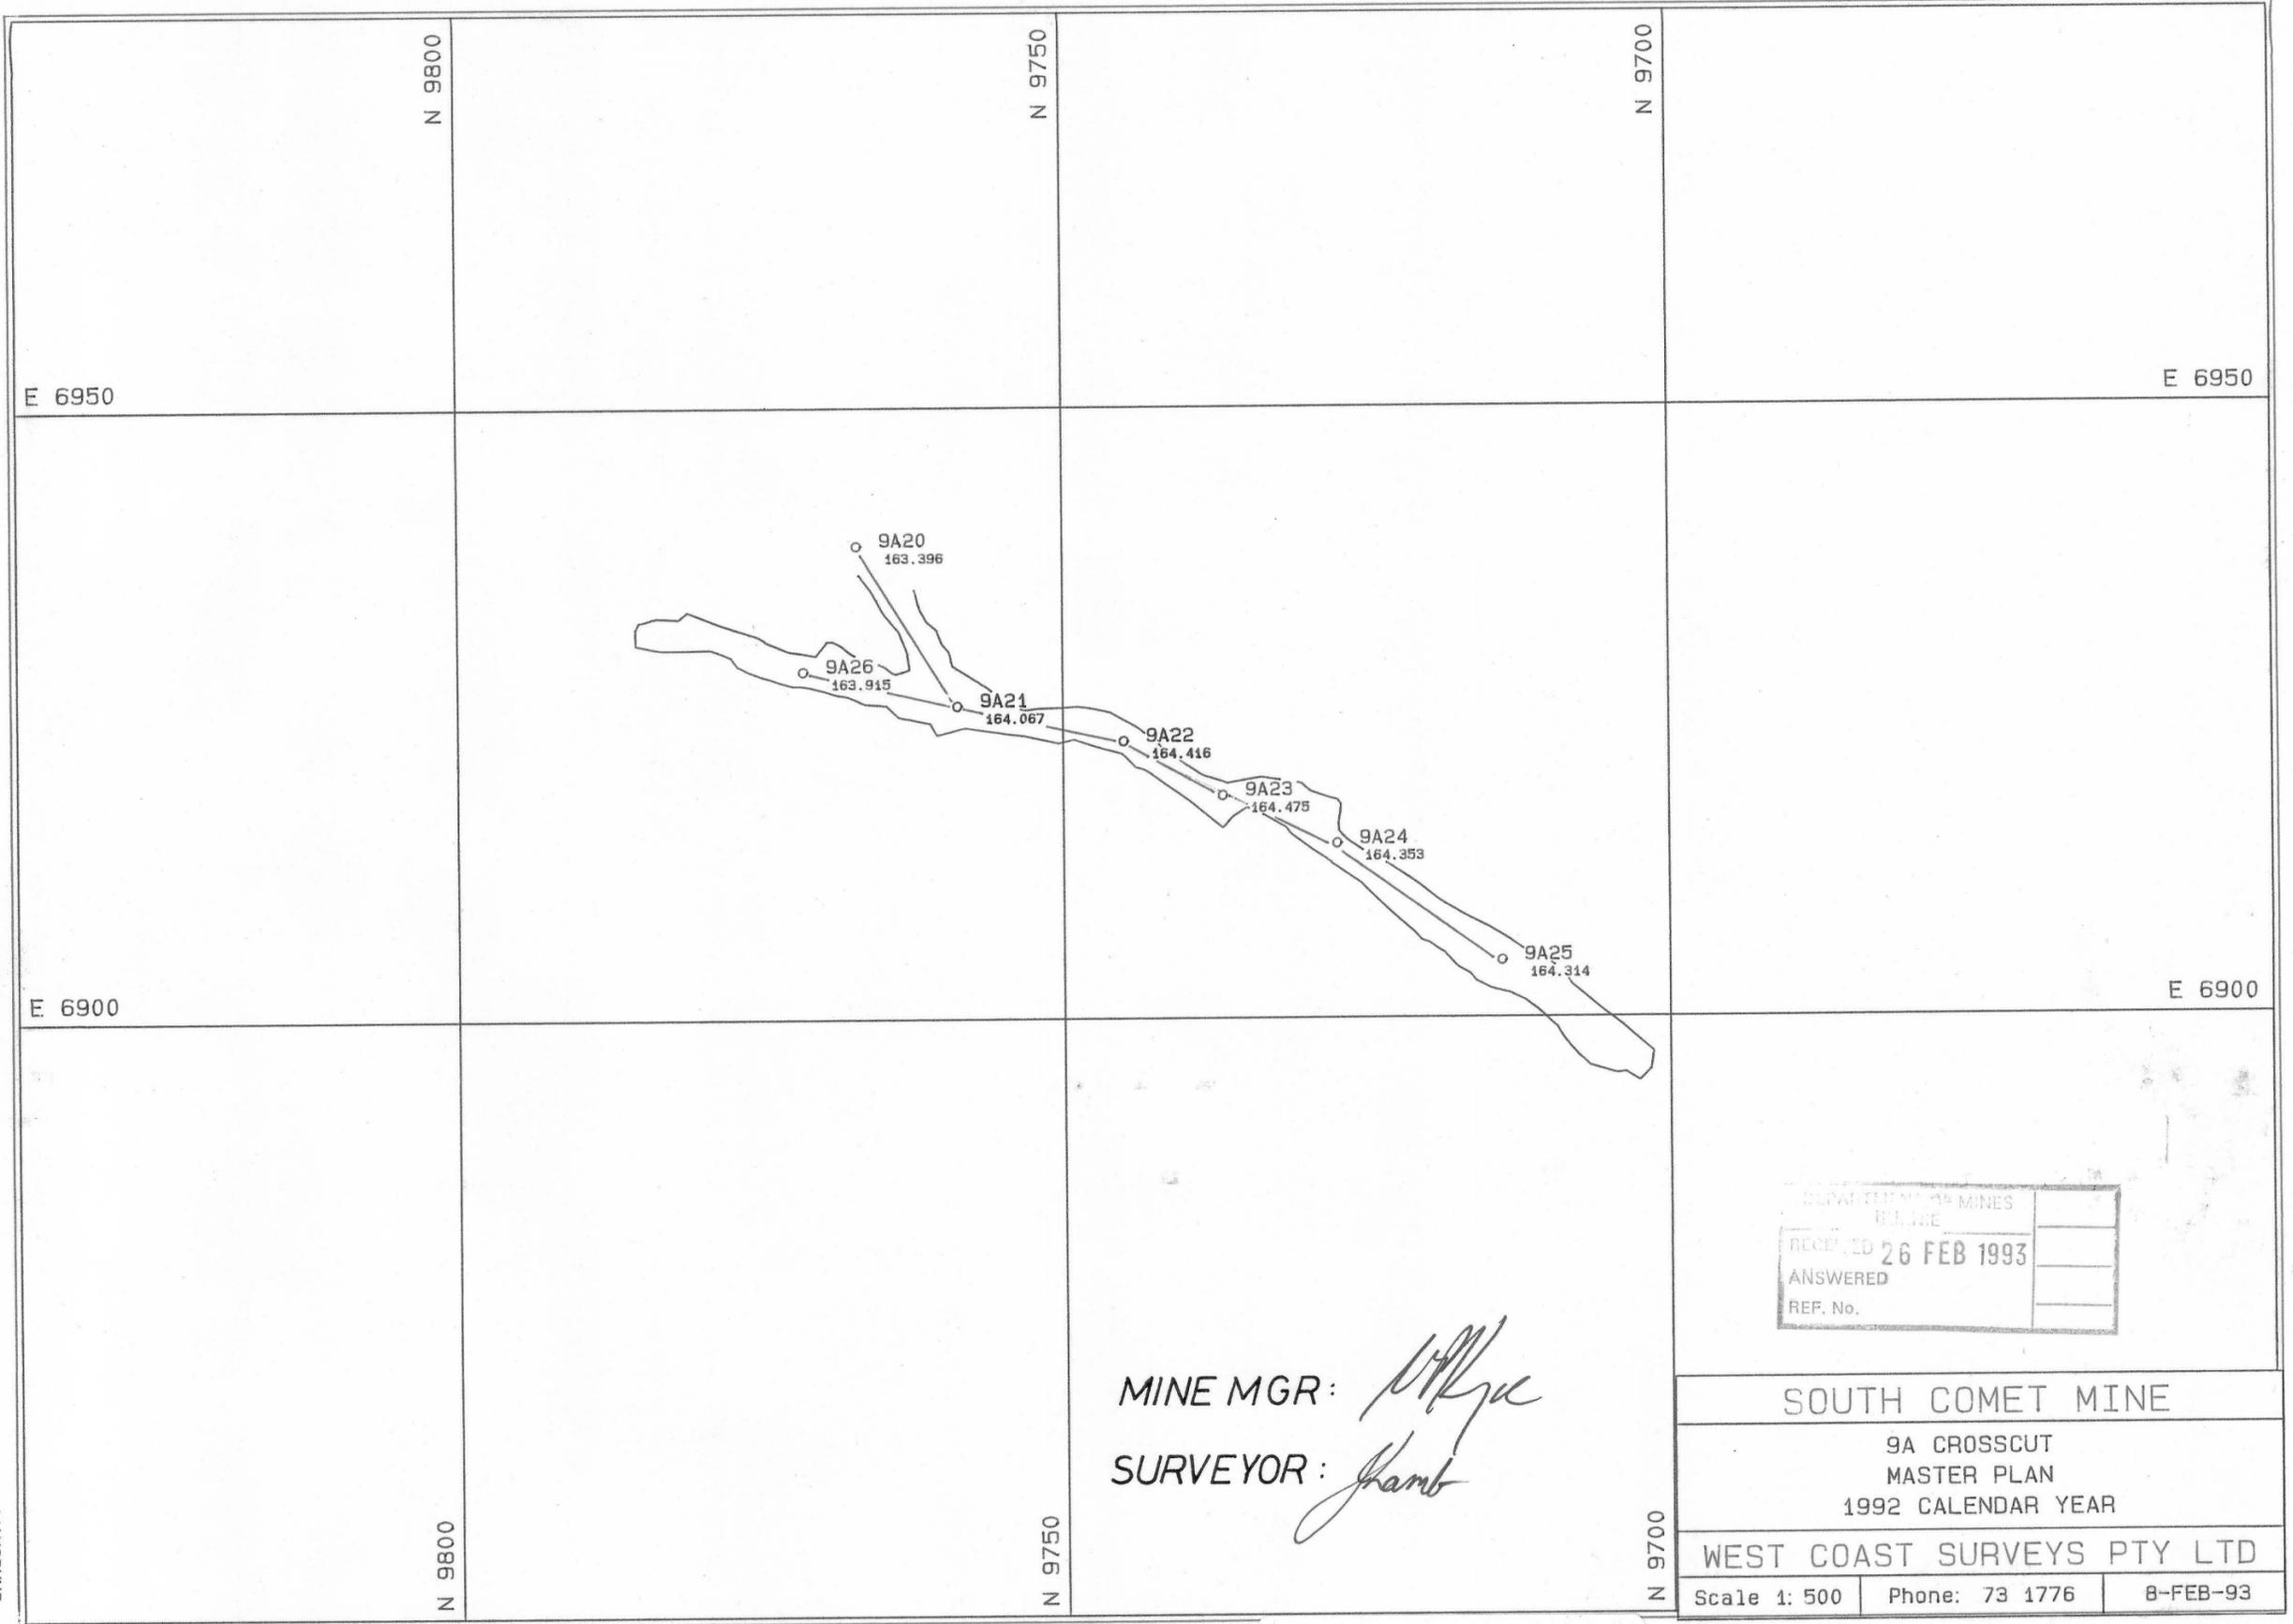

MINE MGR: *[Signature]*
 SURVEYOR: *[Signature]*

DEPARTMENT OF MINES
 RECEIVED 26 FEB 1993
 ANSWERED
 REF. No.

SOUTH COMET MINE
 9A CROSSCUT
 MASTER PLAN
 1992 CALENDAR YEAR
 WEST COAST SURVEYS PTY LTD
 Scale 1: 500 Phone: 73 1776 8-FEB-93

5 cm
 0154-009

9AXCVA.PF