


0154-013

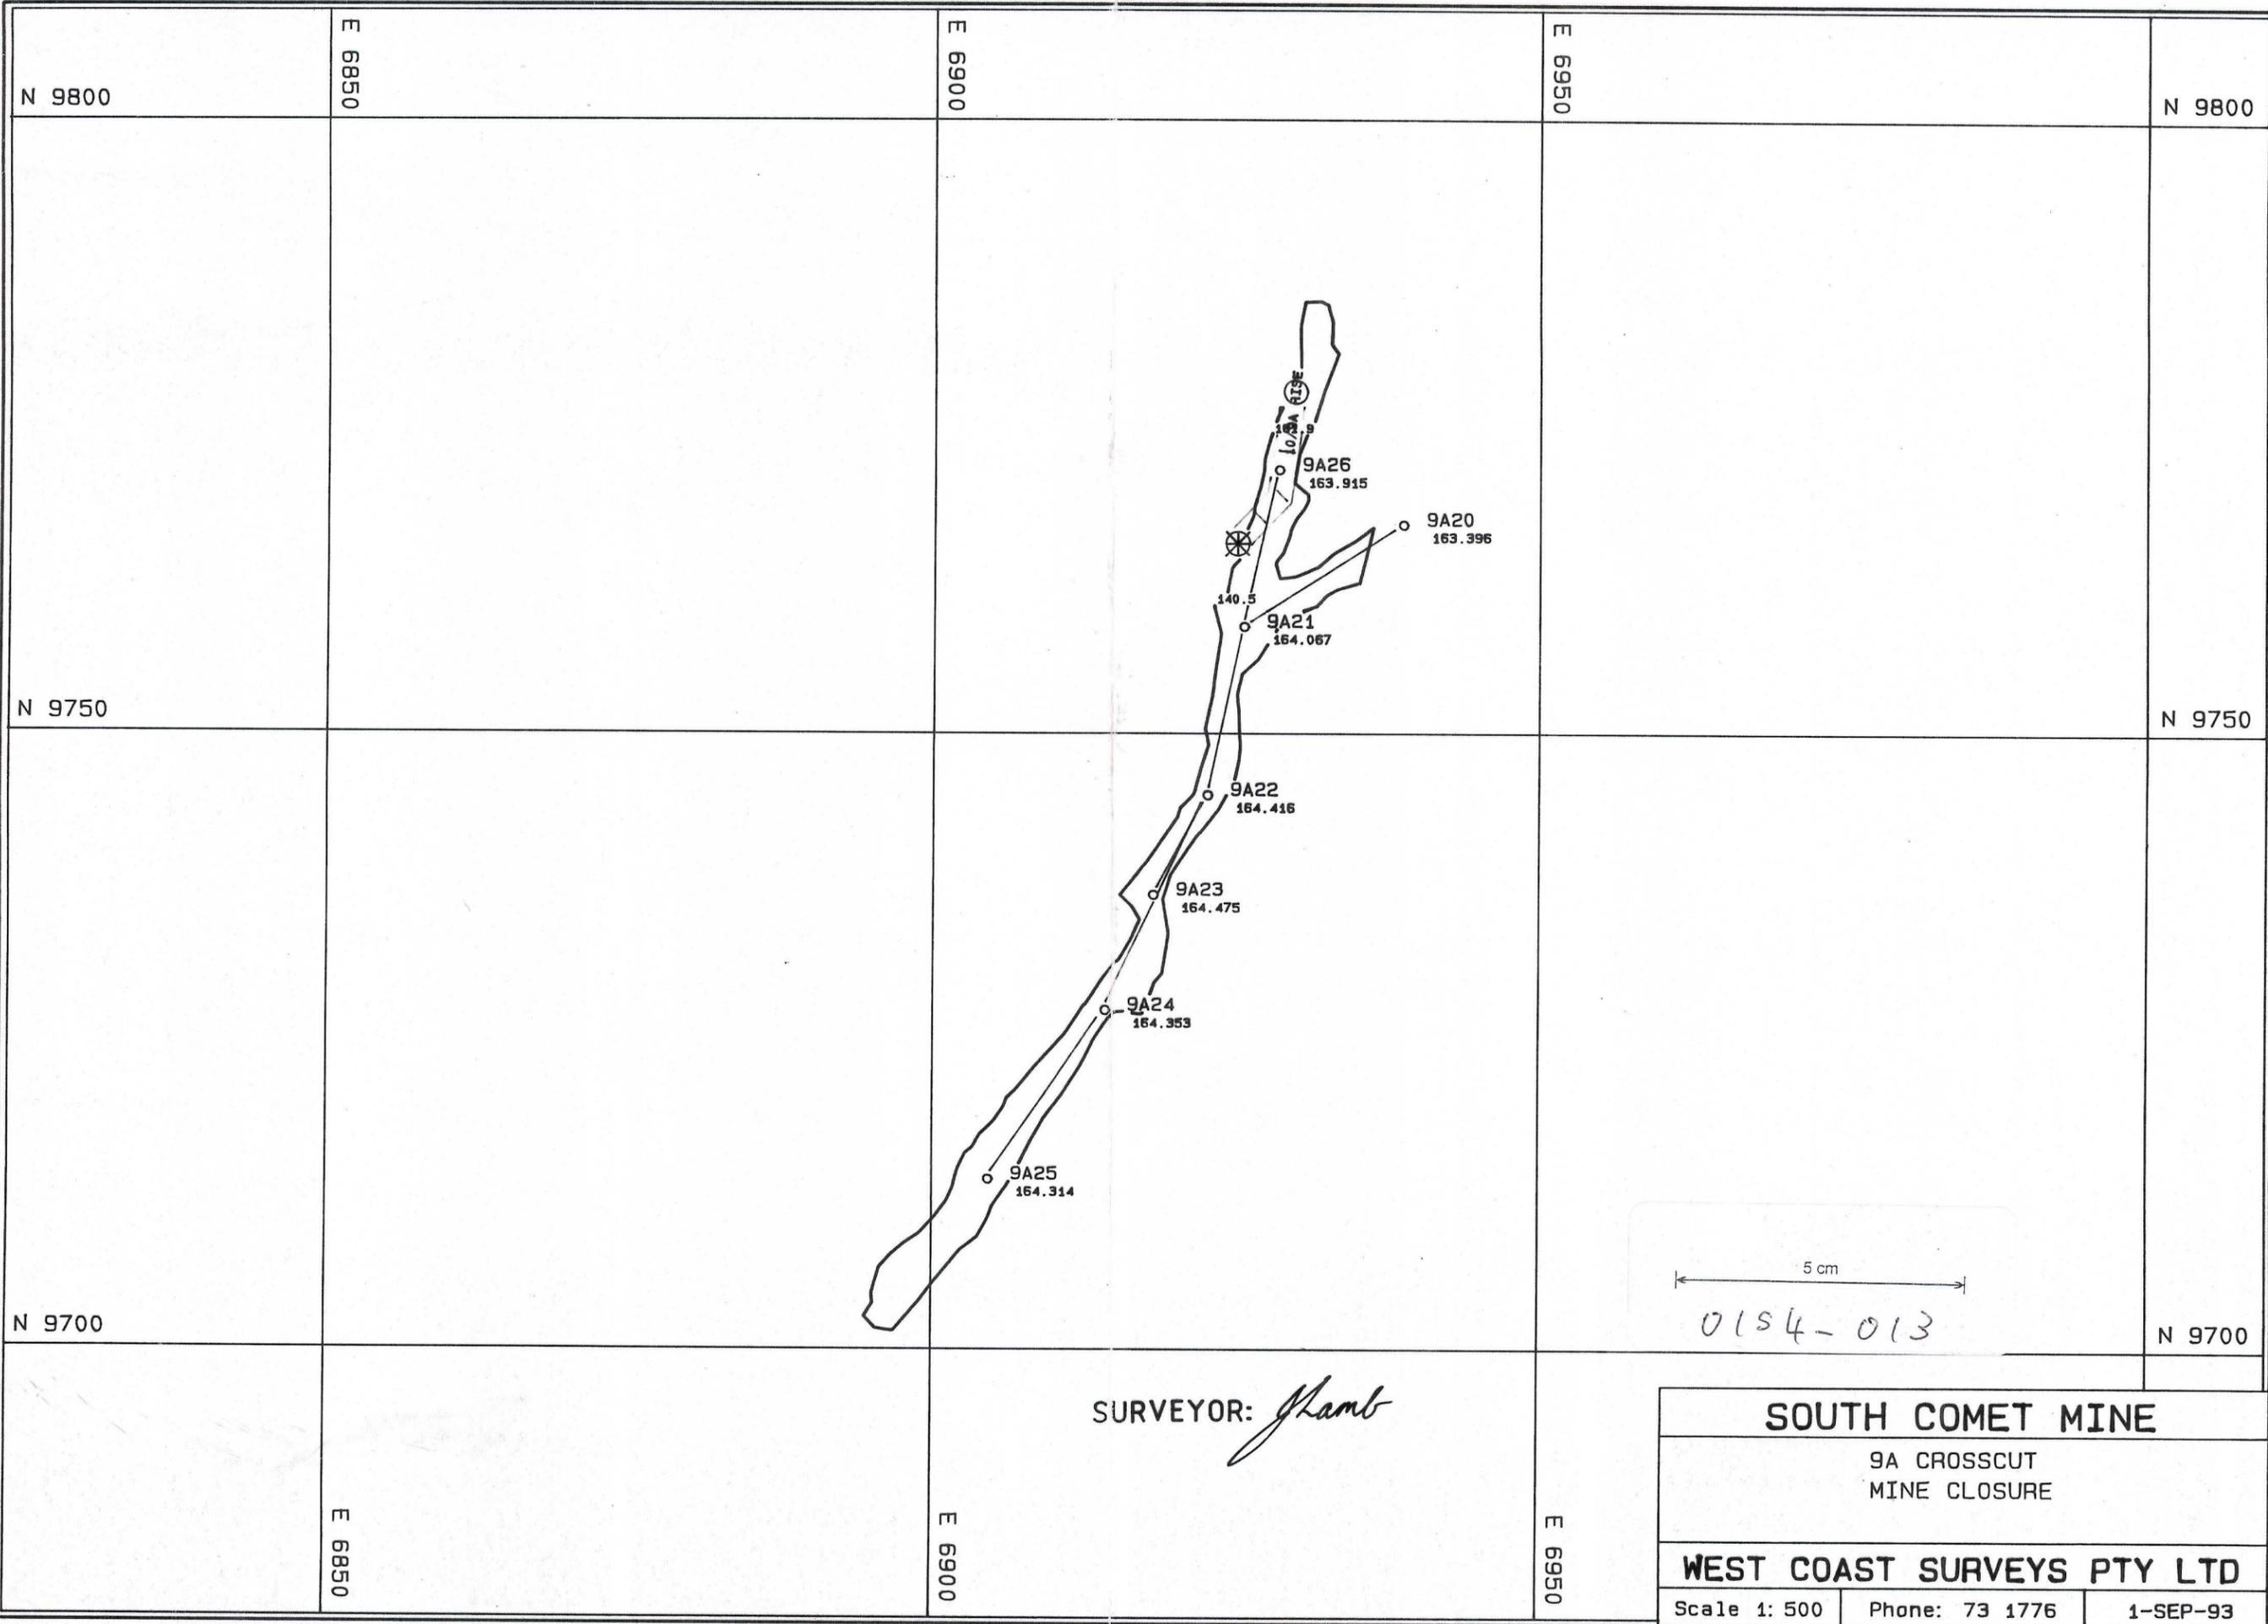

5 cm

0154-013

SURVEYOR: *Gamb*

SOUTH COMET MINE		
9A CROSSCUT MINE CLOSURE		
WEST COAST SURVEYS PTY LTD		
Scale 1: 500	Phone: 73 1776	1-SEP-93

9AXCUC.PF