


0154-014

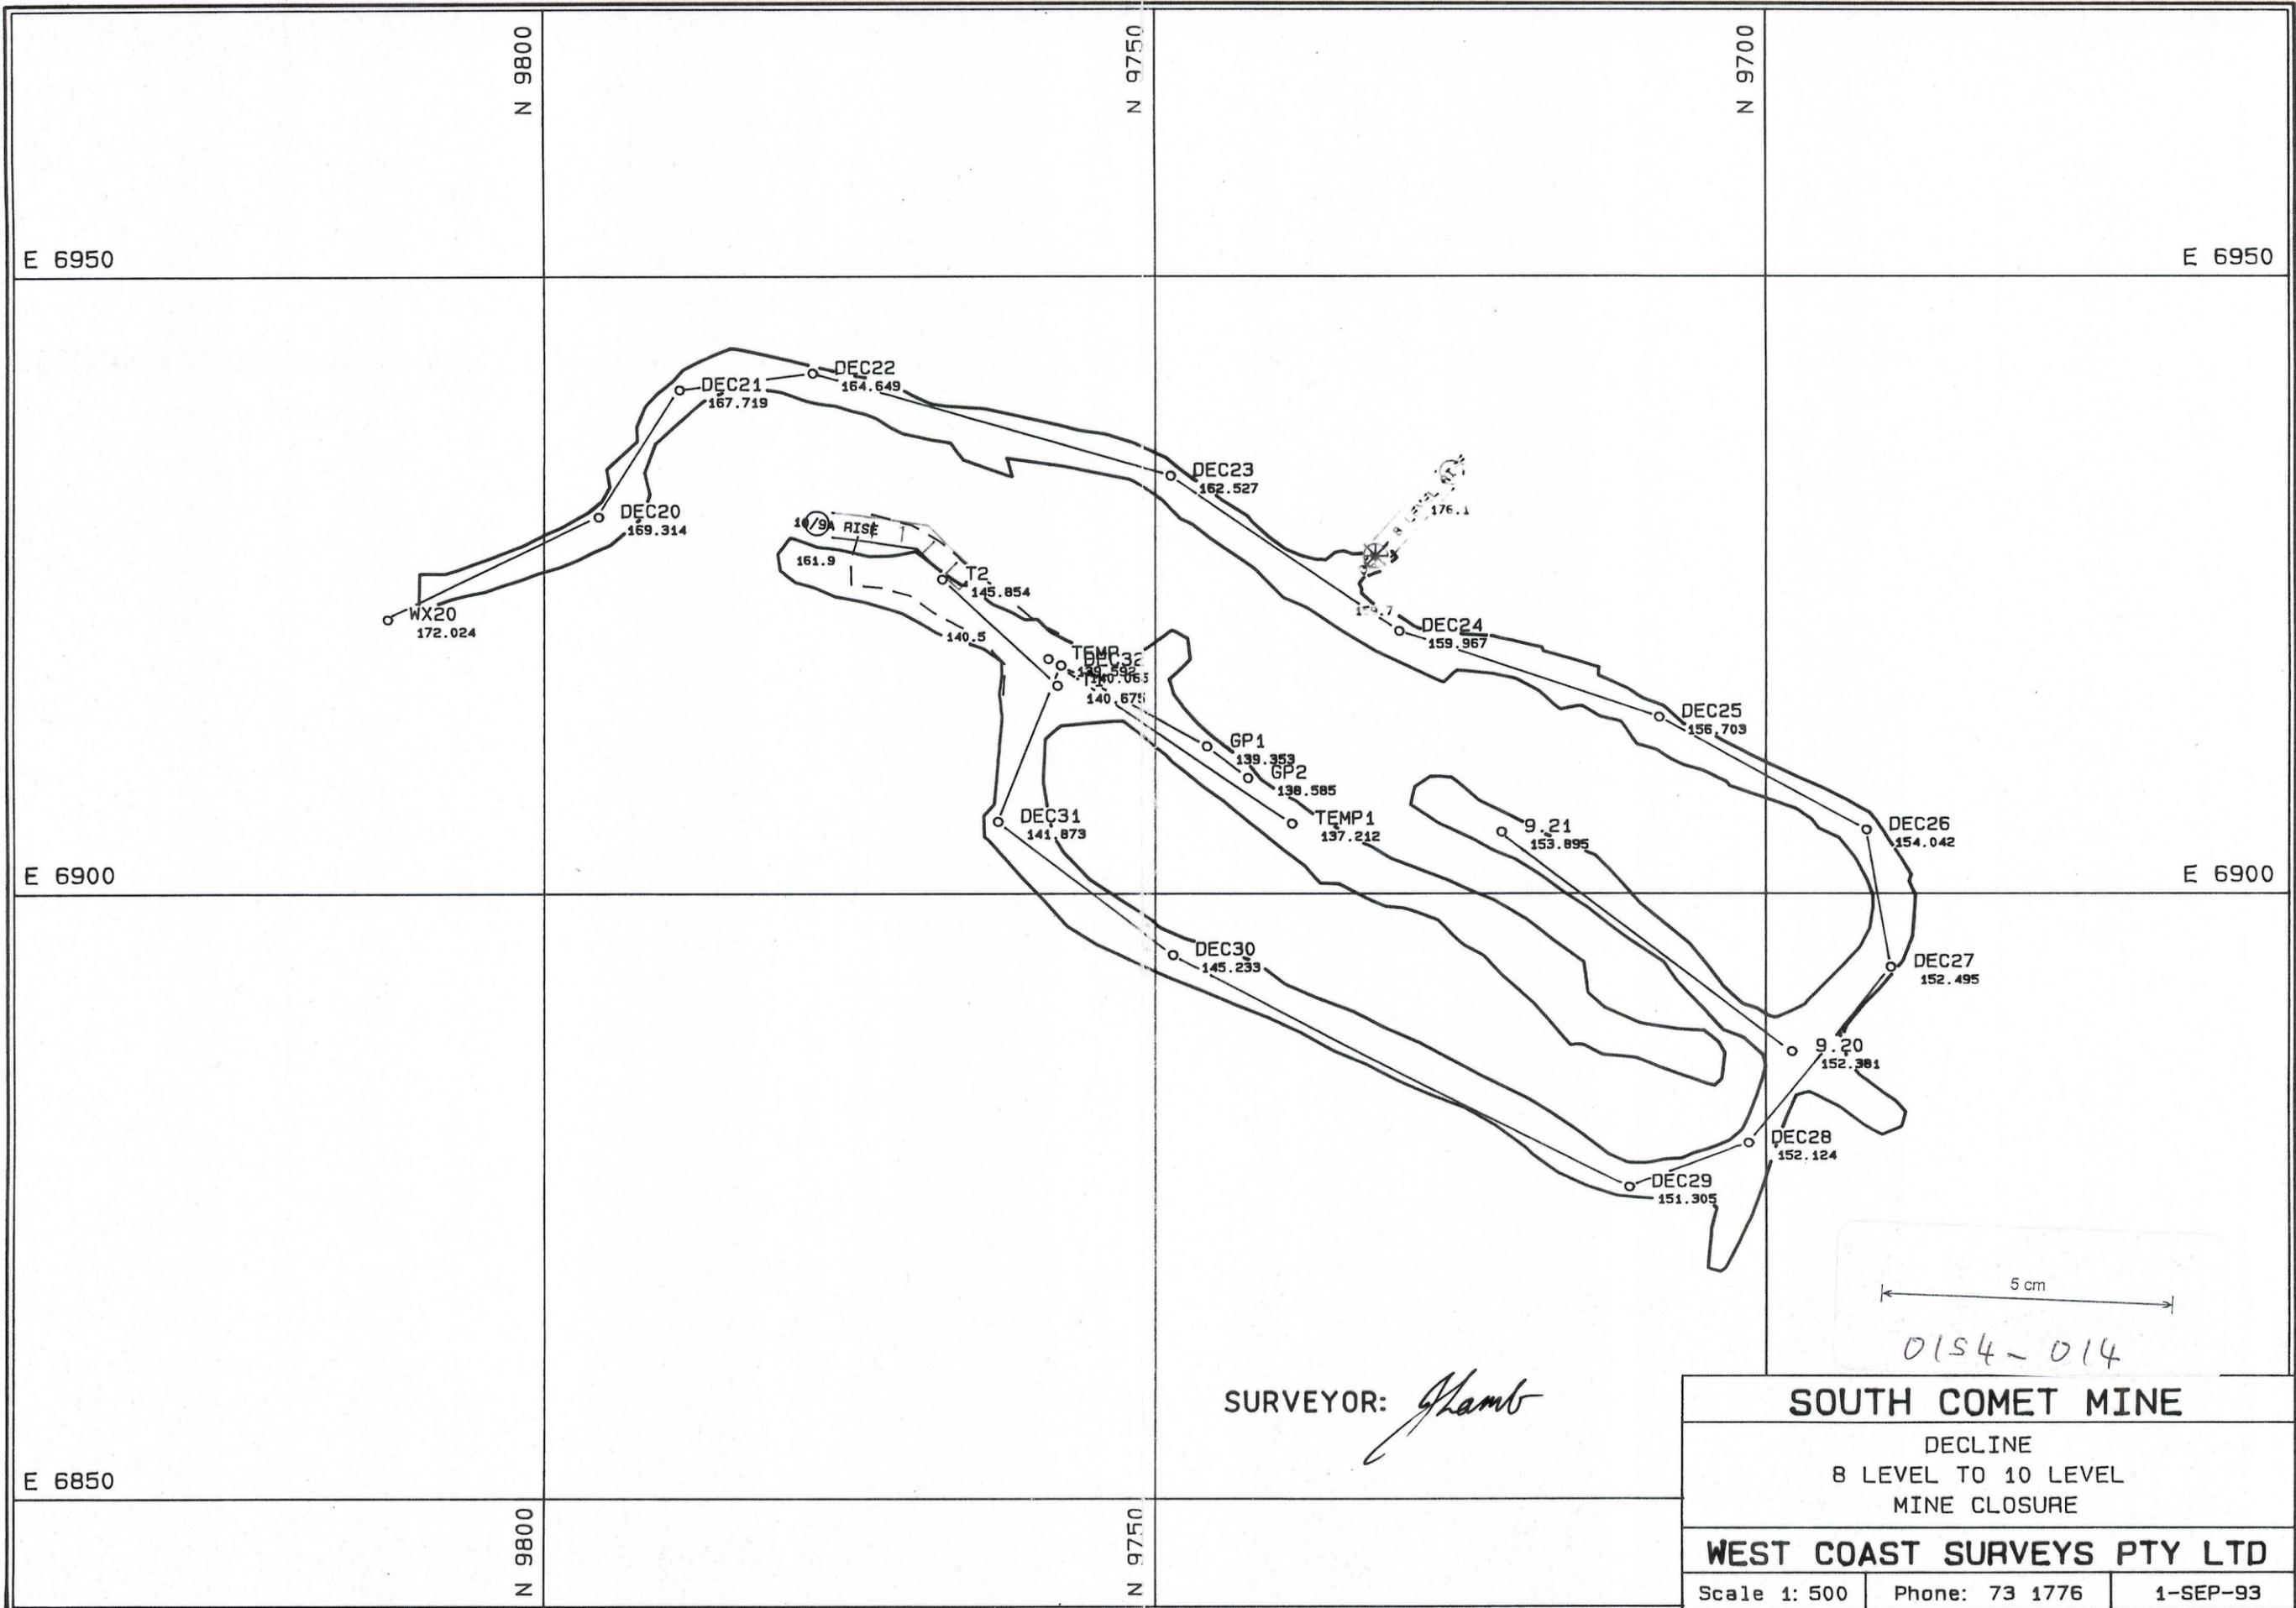

SOUTH COMET MINE		
DECLINE 8 LEVEL TO 10 LEVEL MINE CLOSURE		
WEST COAST SURVEYS PTY LTD		
Scale 1: 500	Phone: 73 1776	1-SEP-93

DECLIB.PF