


0154-015

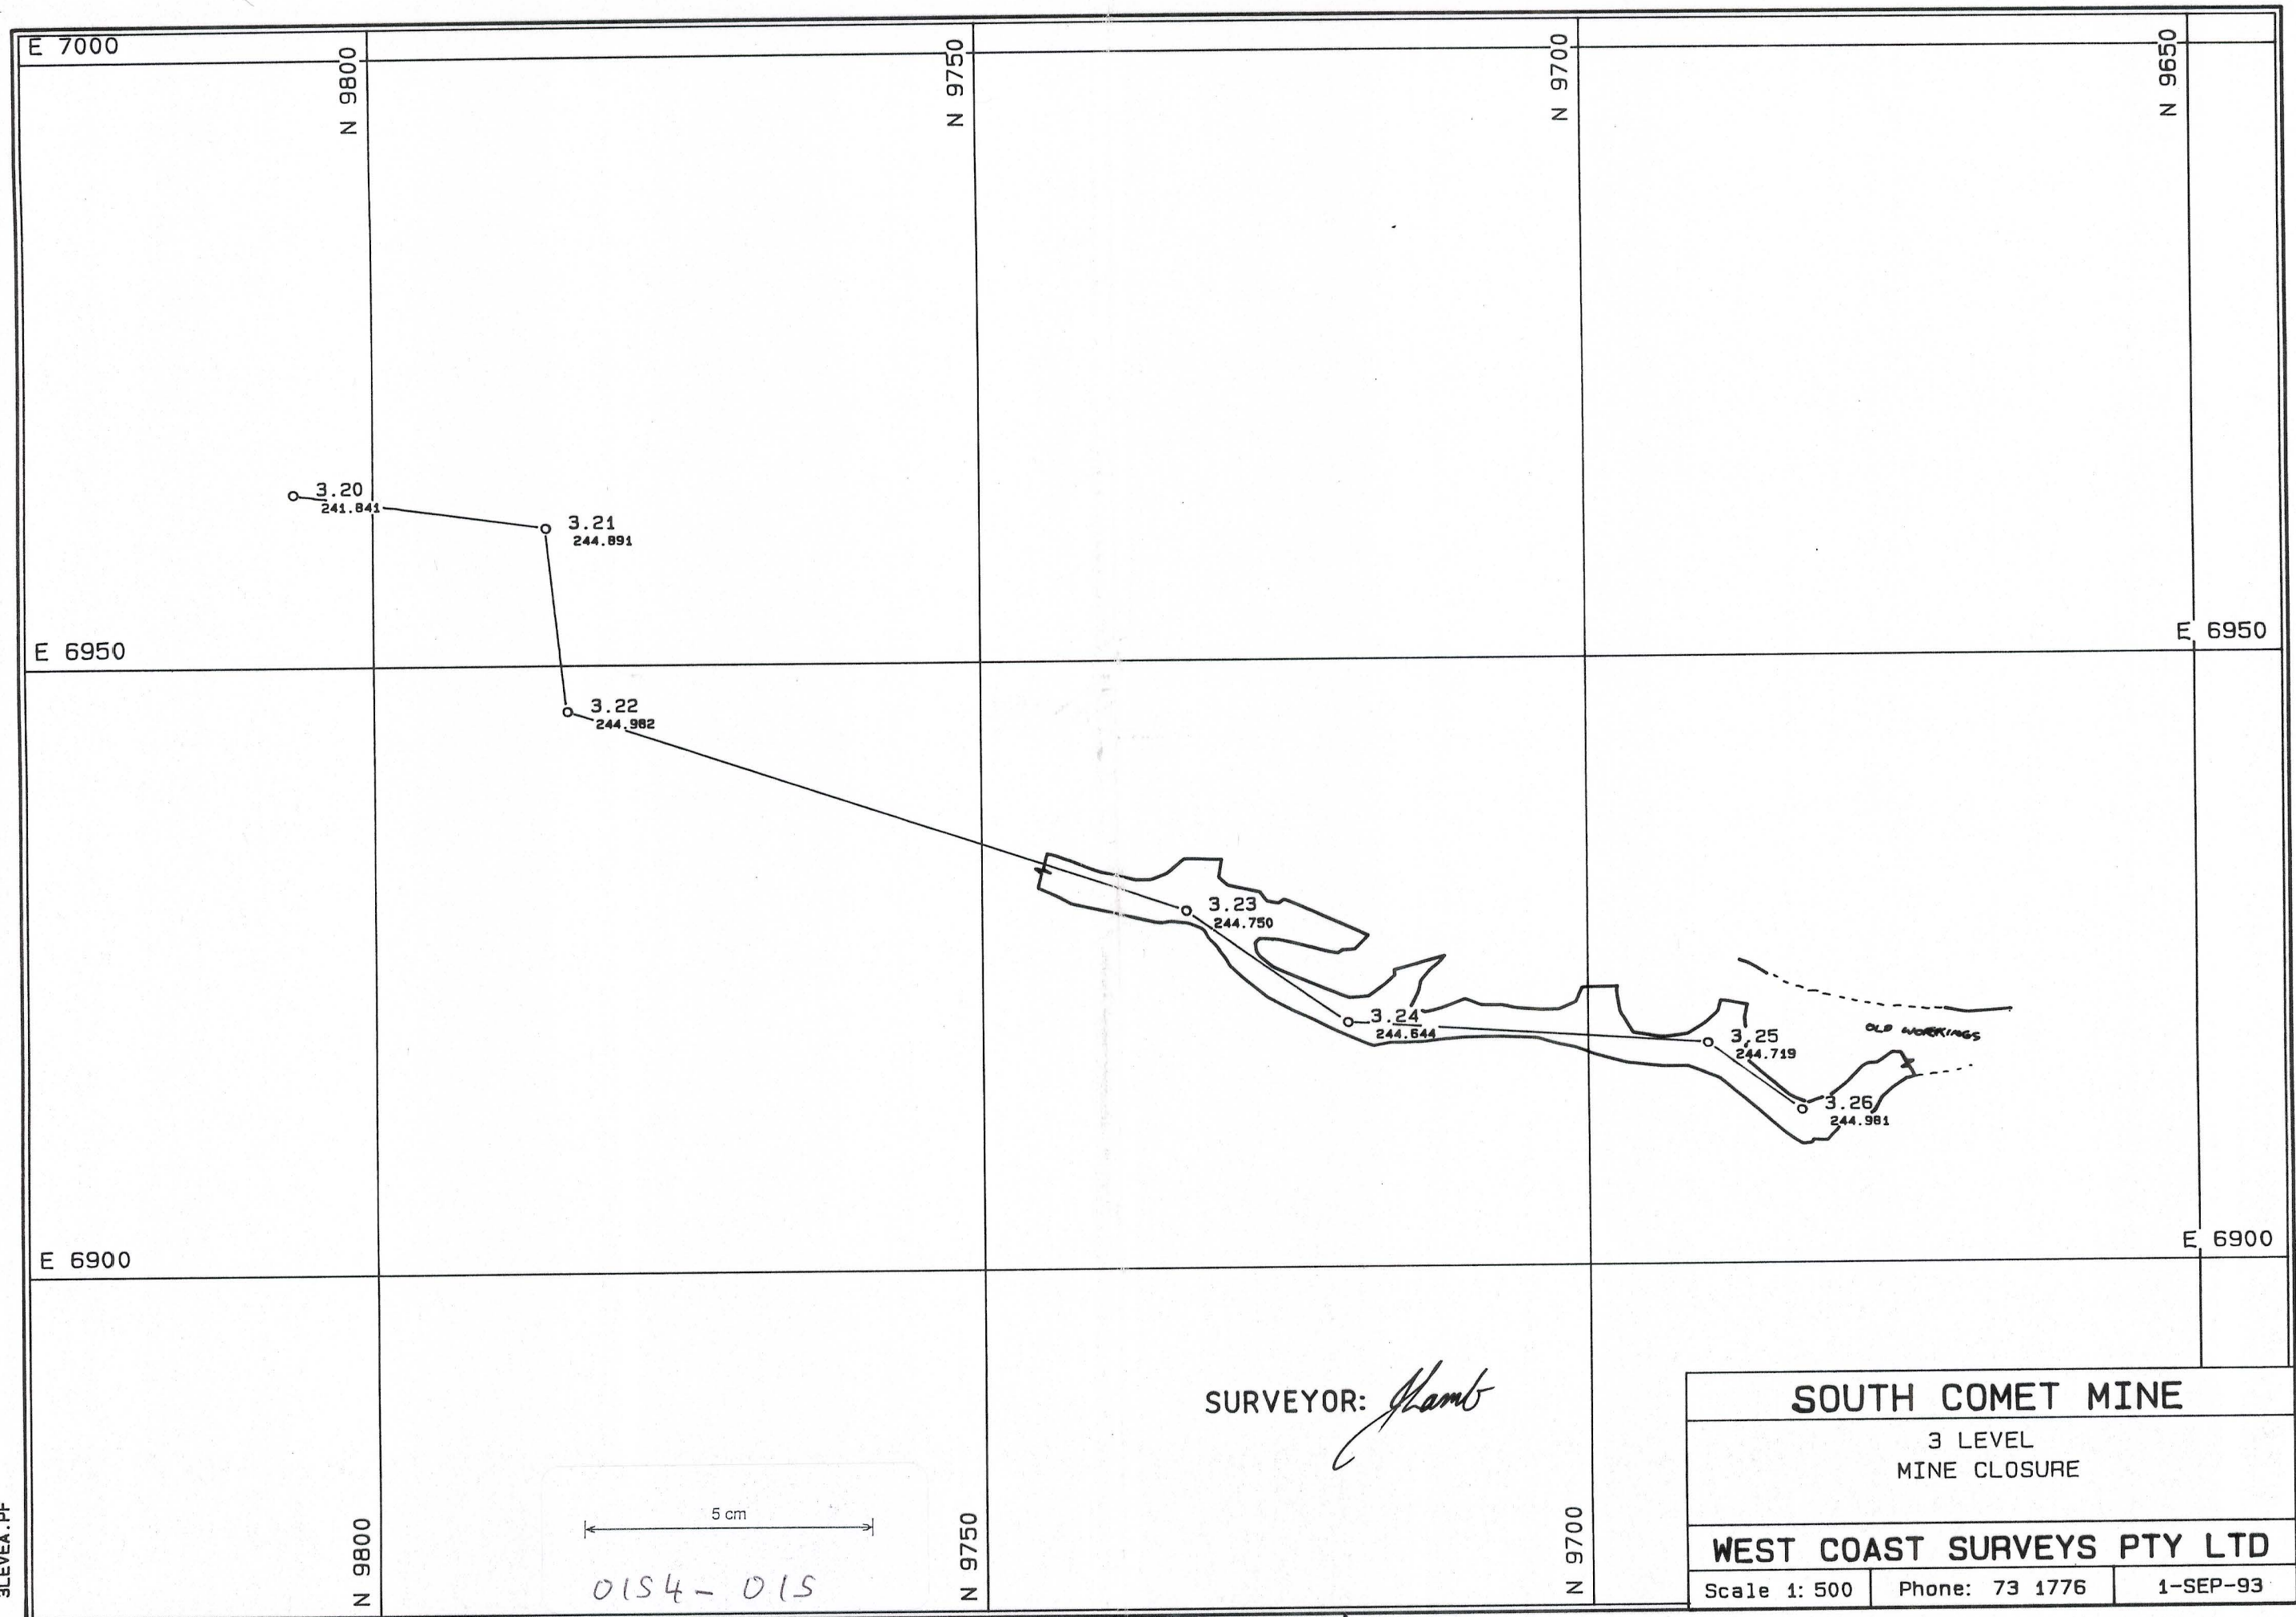

3LEVEA.PF