


0154 - 016

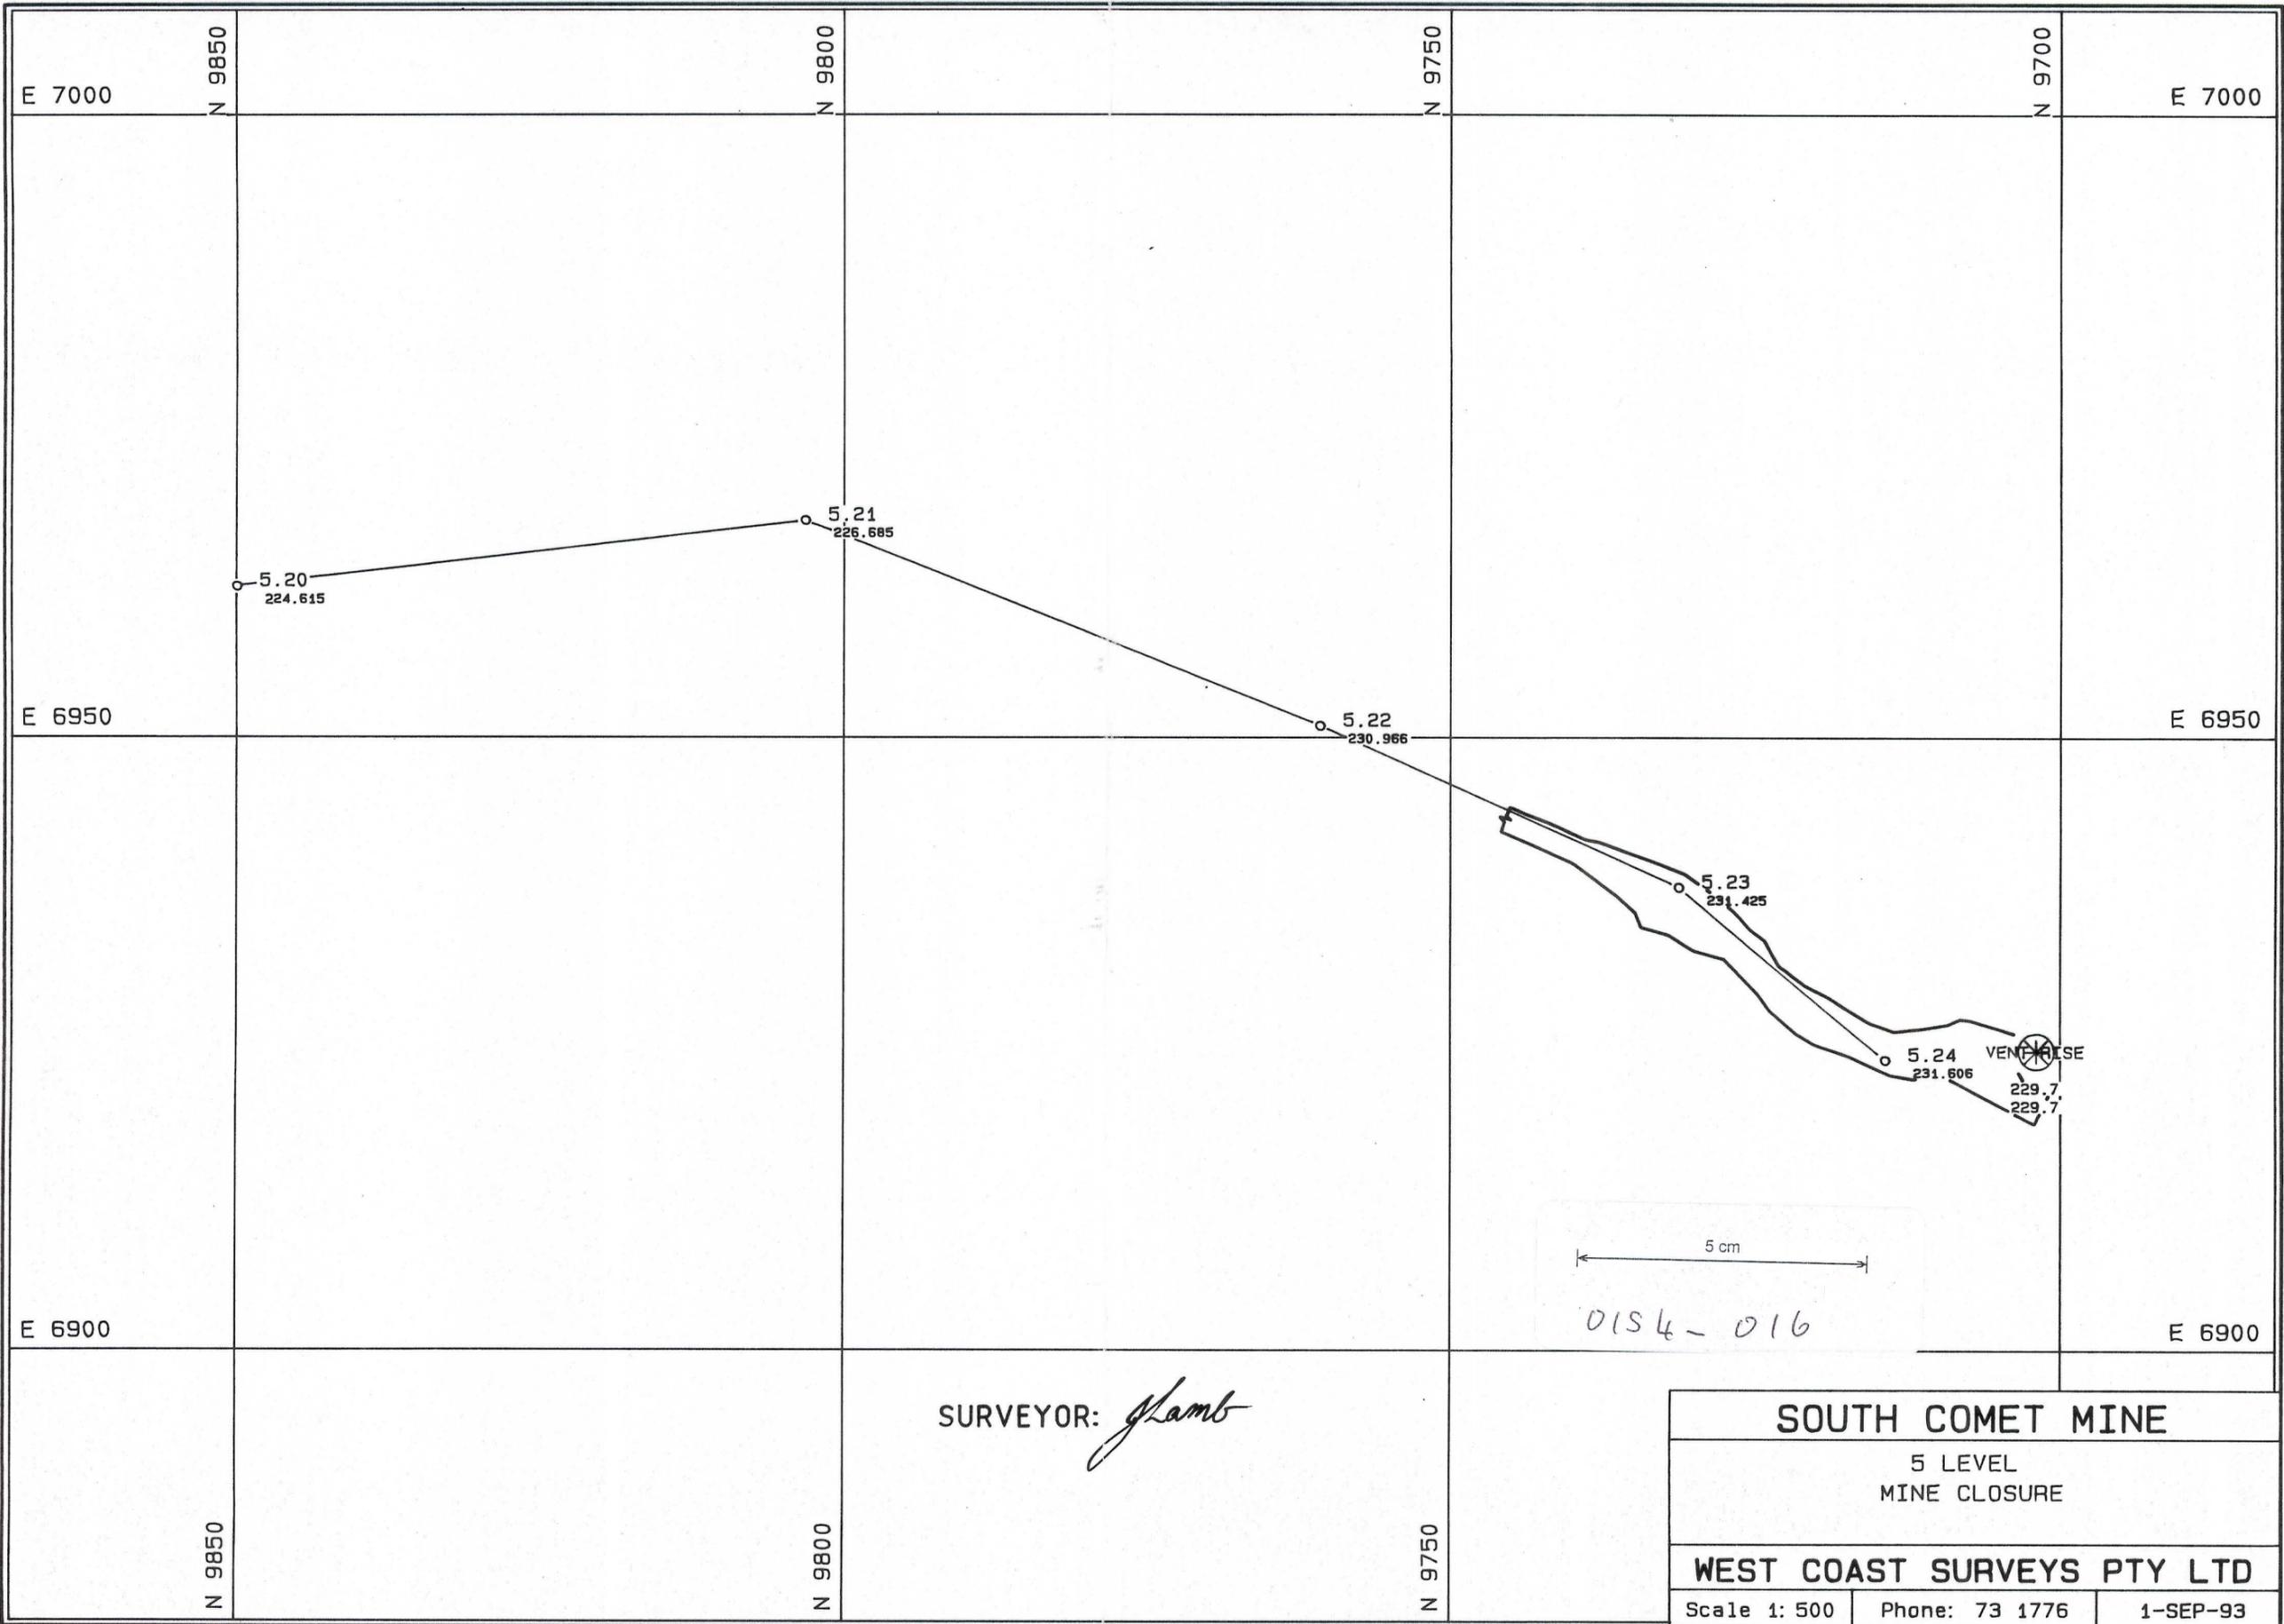

0154 - 016

SOUTH COMET MINE		
5 LEVEL MINE CLOSURE		
WEST COAST SURVEYS PTY LTD		
Scale 1: 500	Phone: 73 1776	1-SEP-93

SLEVEA.PF