


0154-017

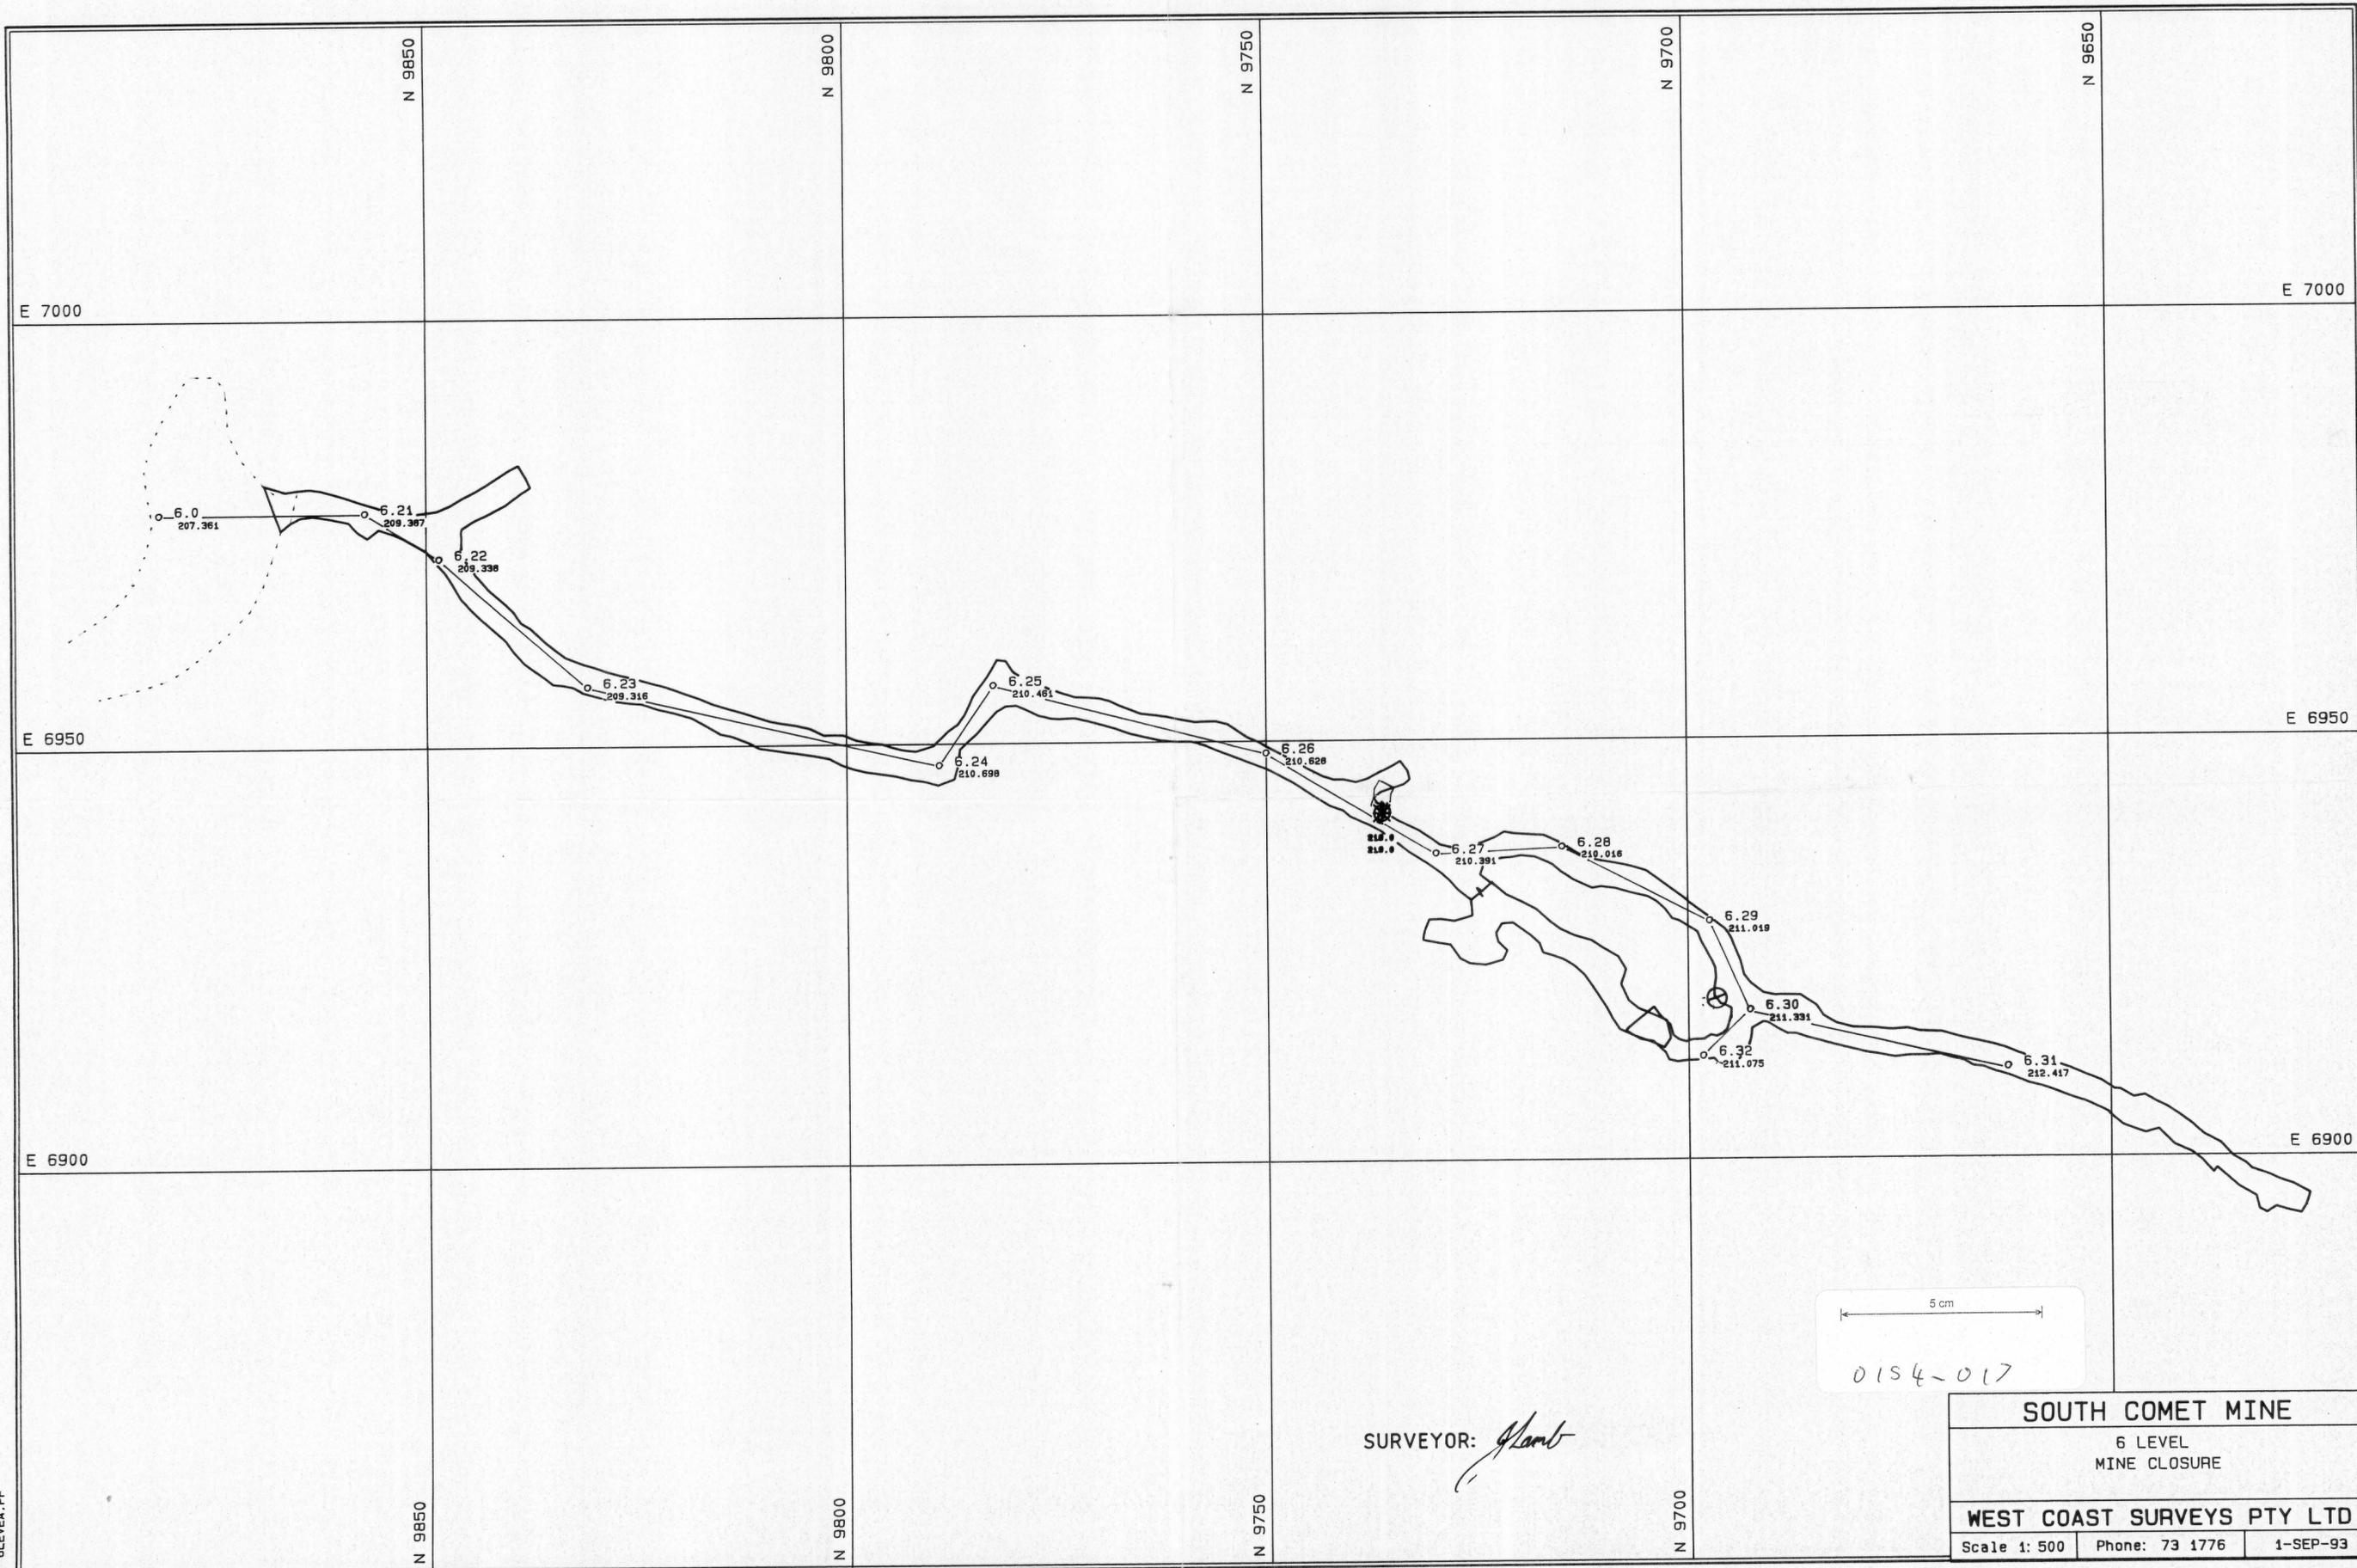

SURVEYOR: *[Signature]*

5 cm
0154-017

SOUTH COMET MINE		
6 LEVEL MINE CLOSURE		
WEST COAST SURVEYS PTY LTD		
Scale 1: 500	Phone: 73 1776	1-SEP-93

GLEVEA.PP