




1:250

SOUTH COMET MINE

6-LEVEL

MASTER

0154-020

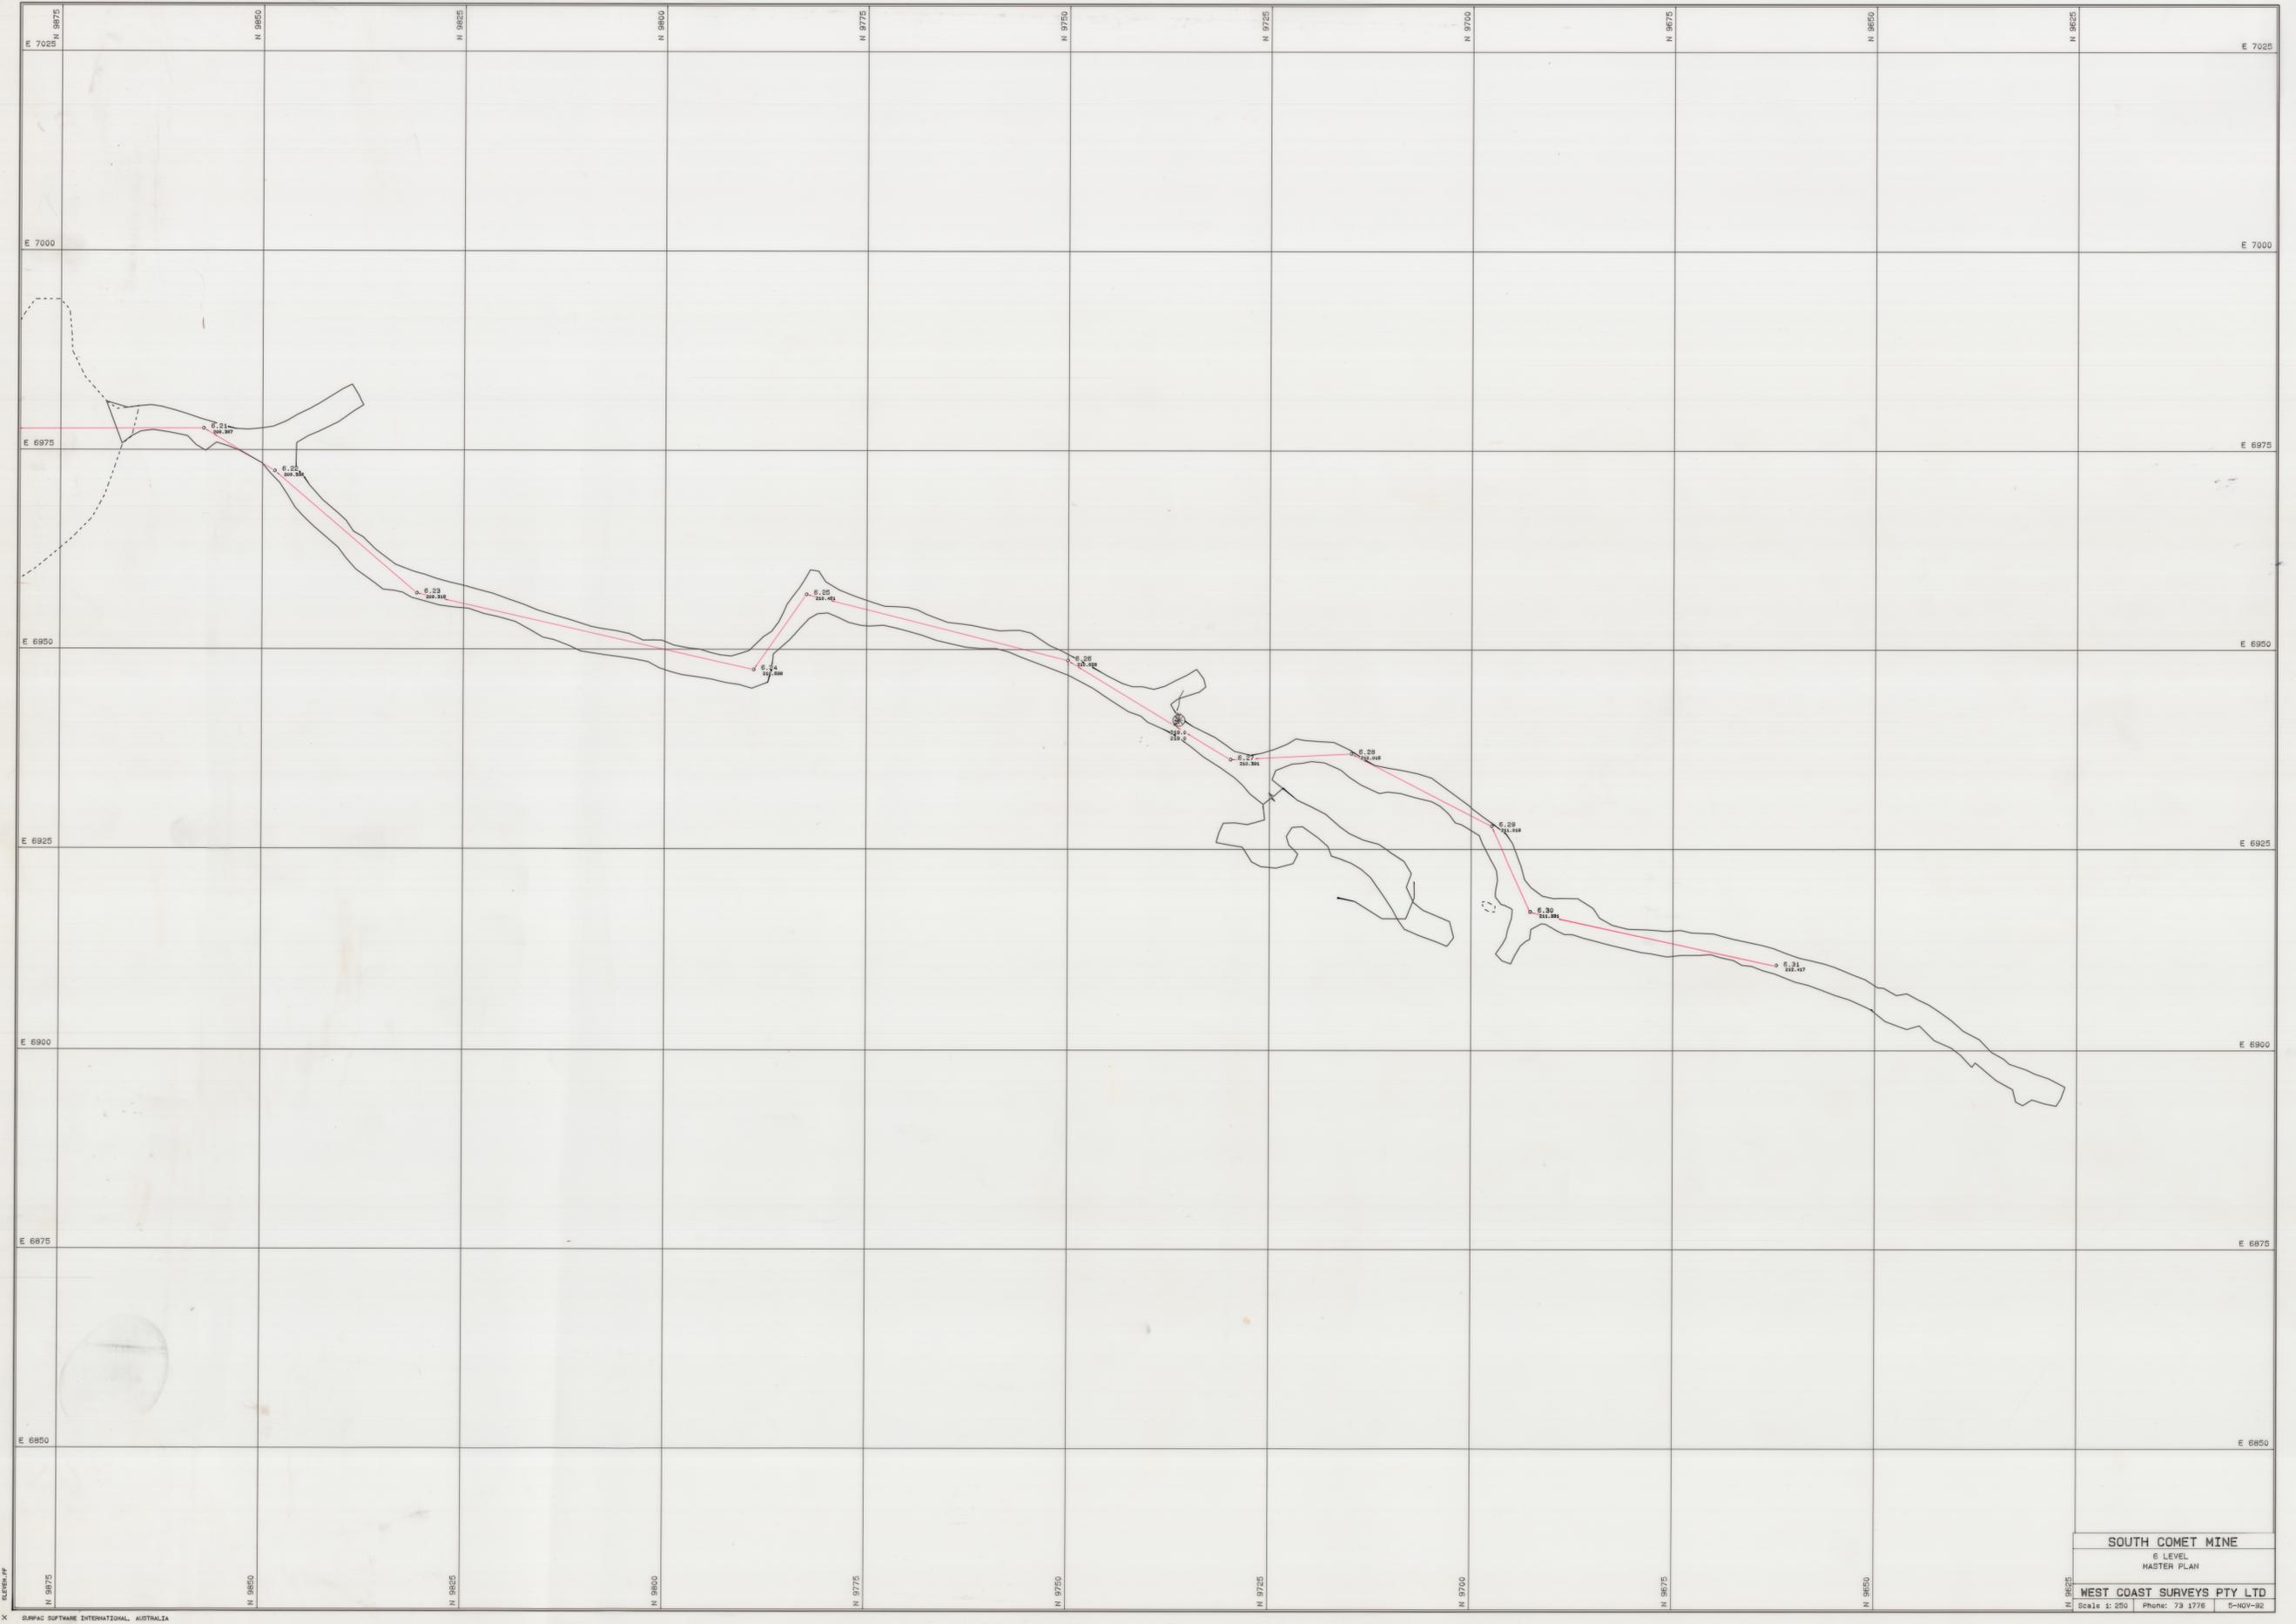

SOUTH COMET MINE
 6 LEVEL
 MASTER PLAN
 WEST COAST SURVEYS PTY LTD
 Scale 1:250 Phone: 73 1776 5-NOV-92