




2 Level
RL 260
1:250

2. Level
1:250

0154-021

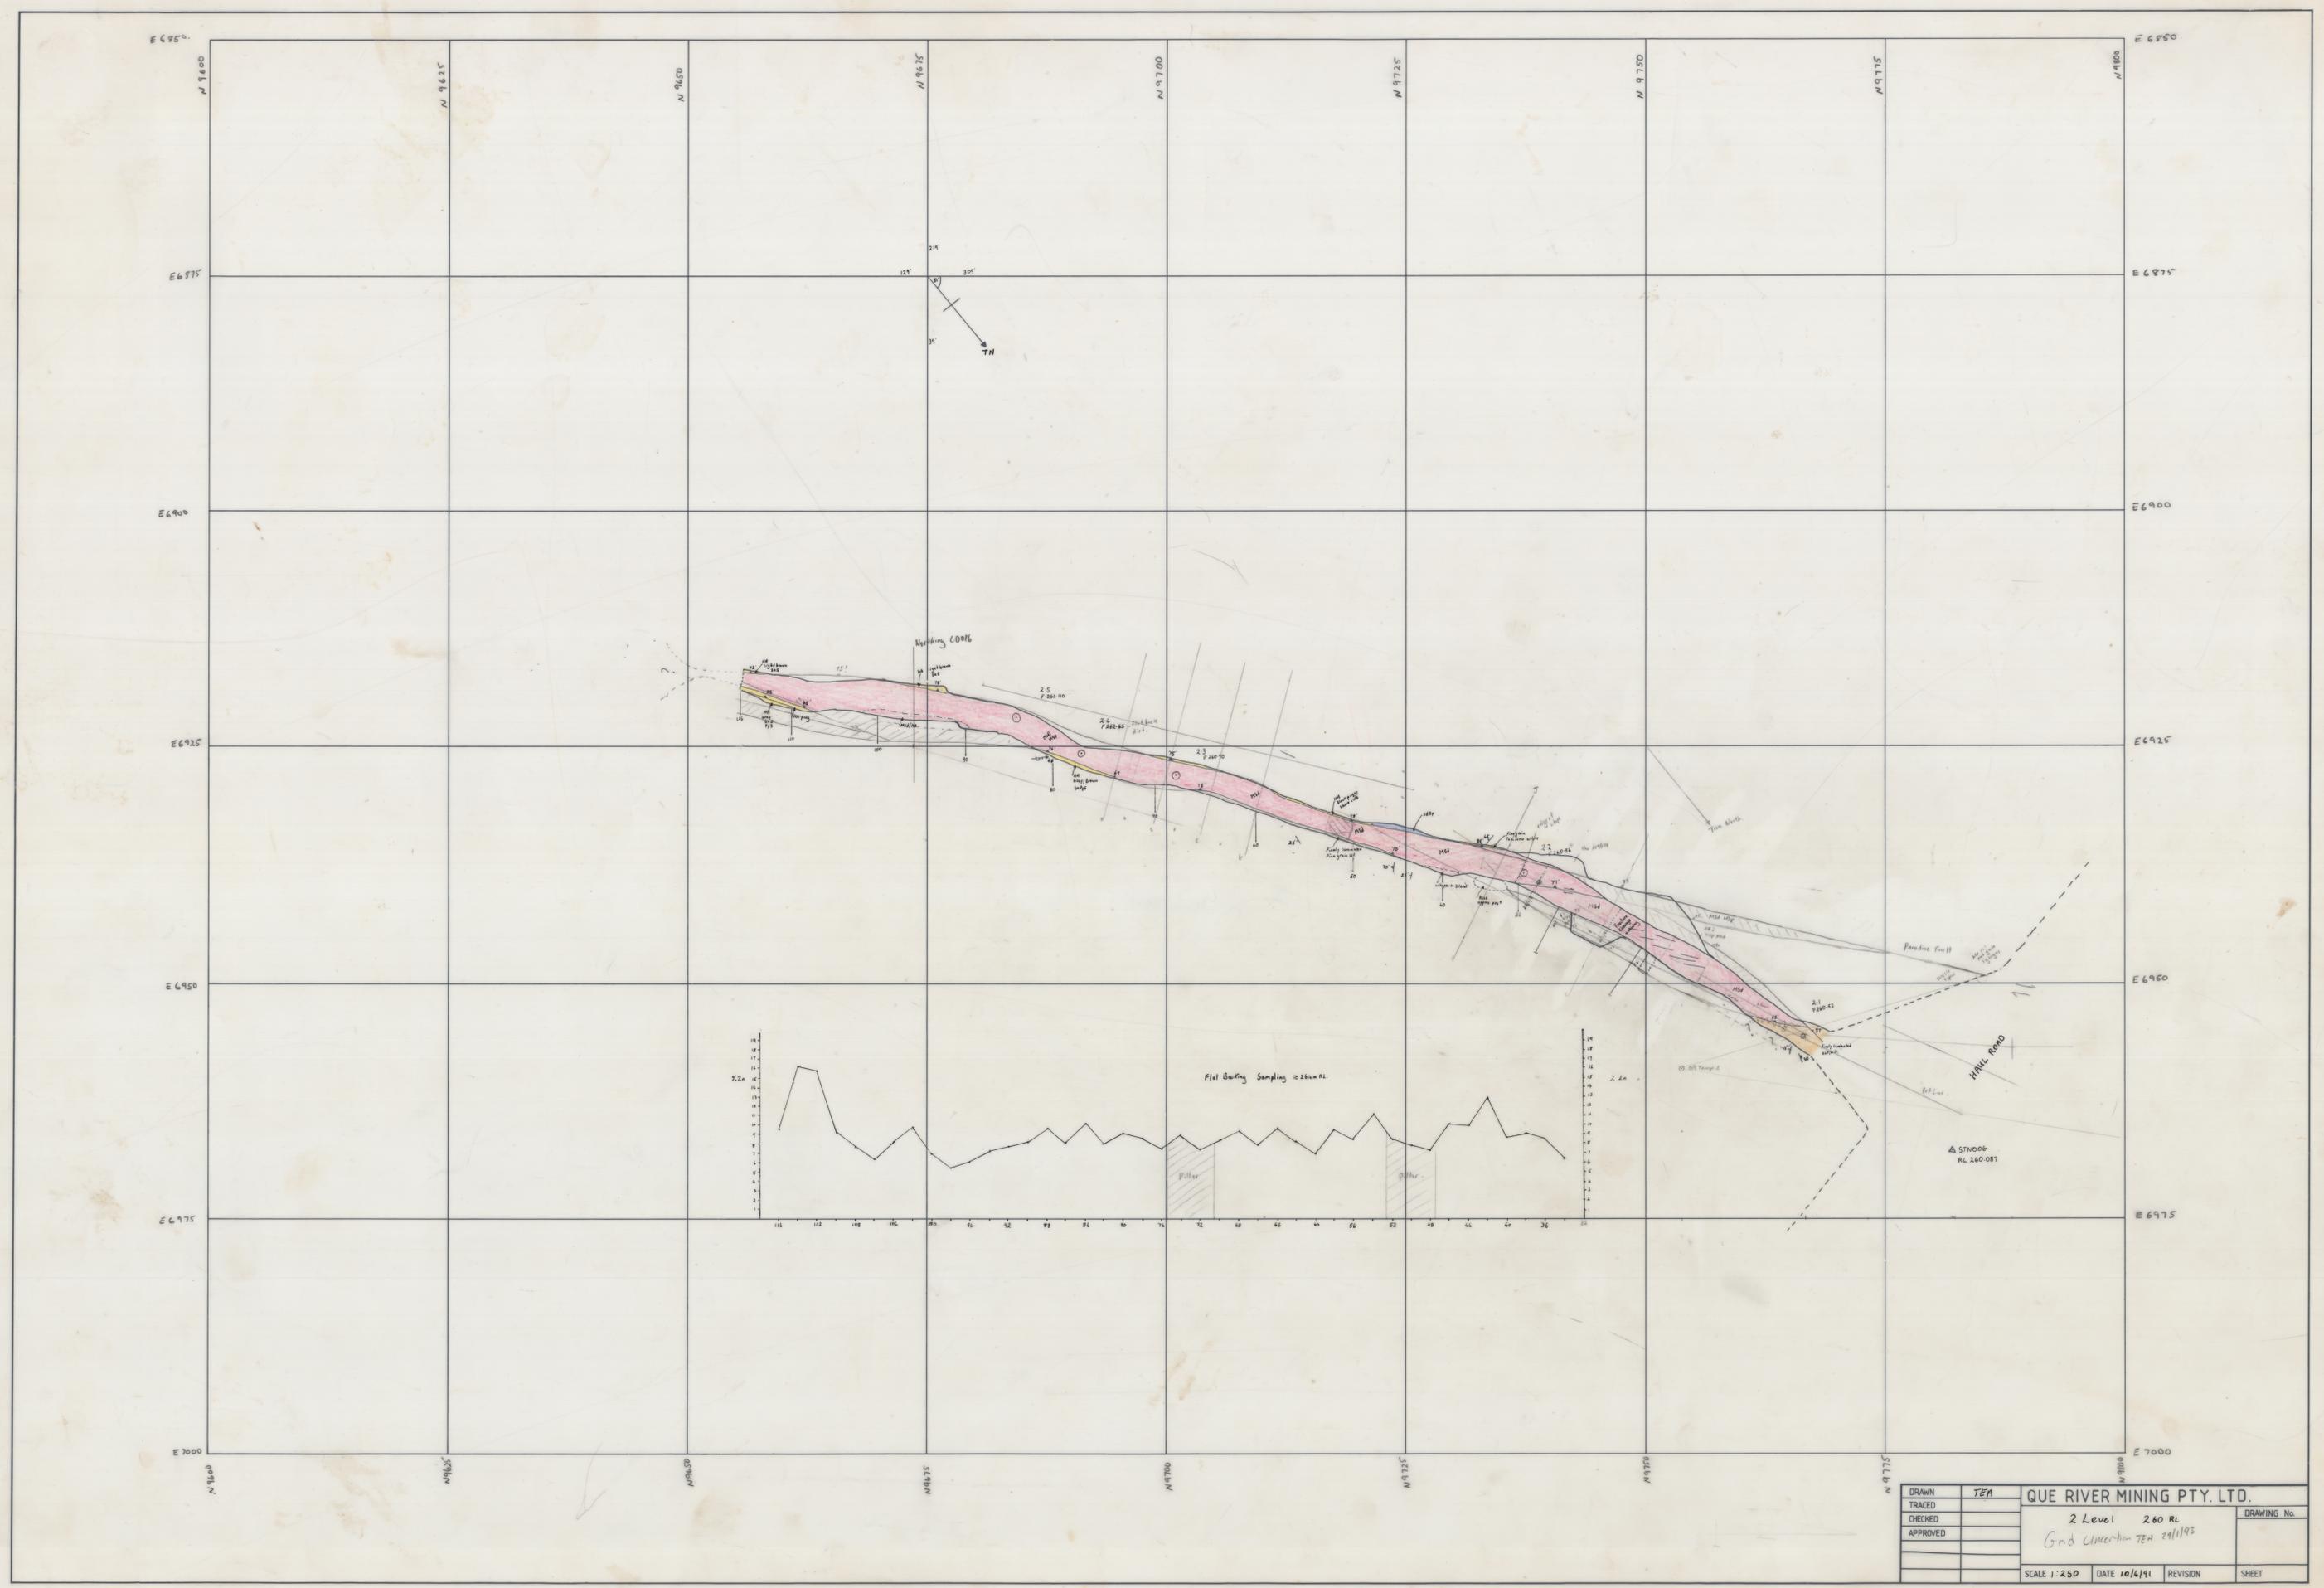

DRAWN	TEA	QUE RIVER MINING PTY. LTD.		DRAWING No.
TRACED		2 Level 260 RL		
CHECKED		Grid Upperton TEA 29/1/93		
APPROVED				
		SCALE 1:250	DATE 10/4/91	REVISION
				SHEET