


5 cm

5 Level
1:2.50
RL-226

5 Level
1:250

0154-024

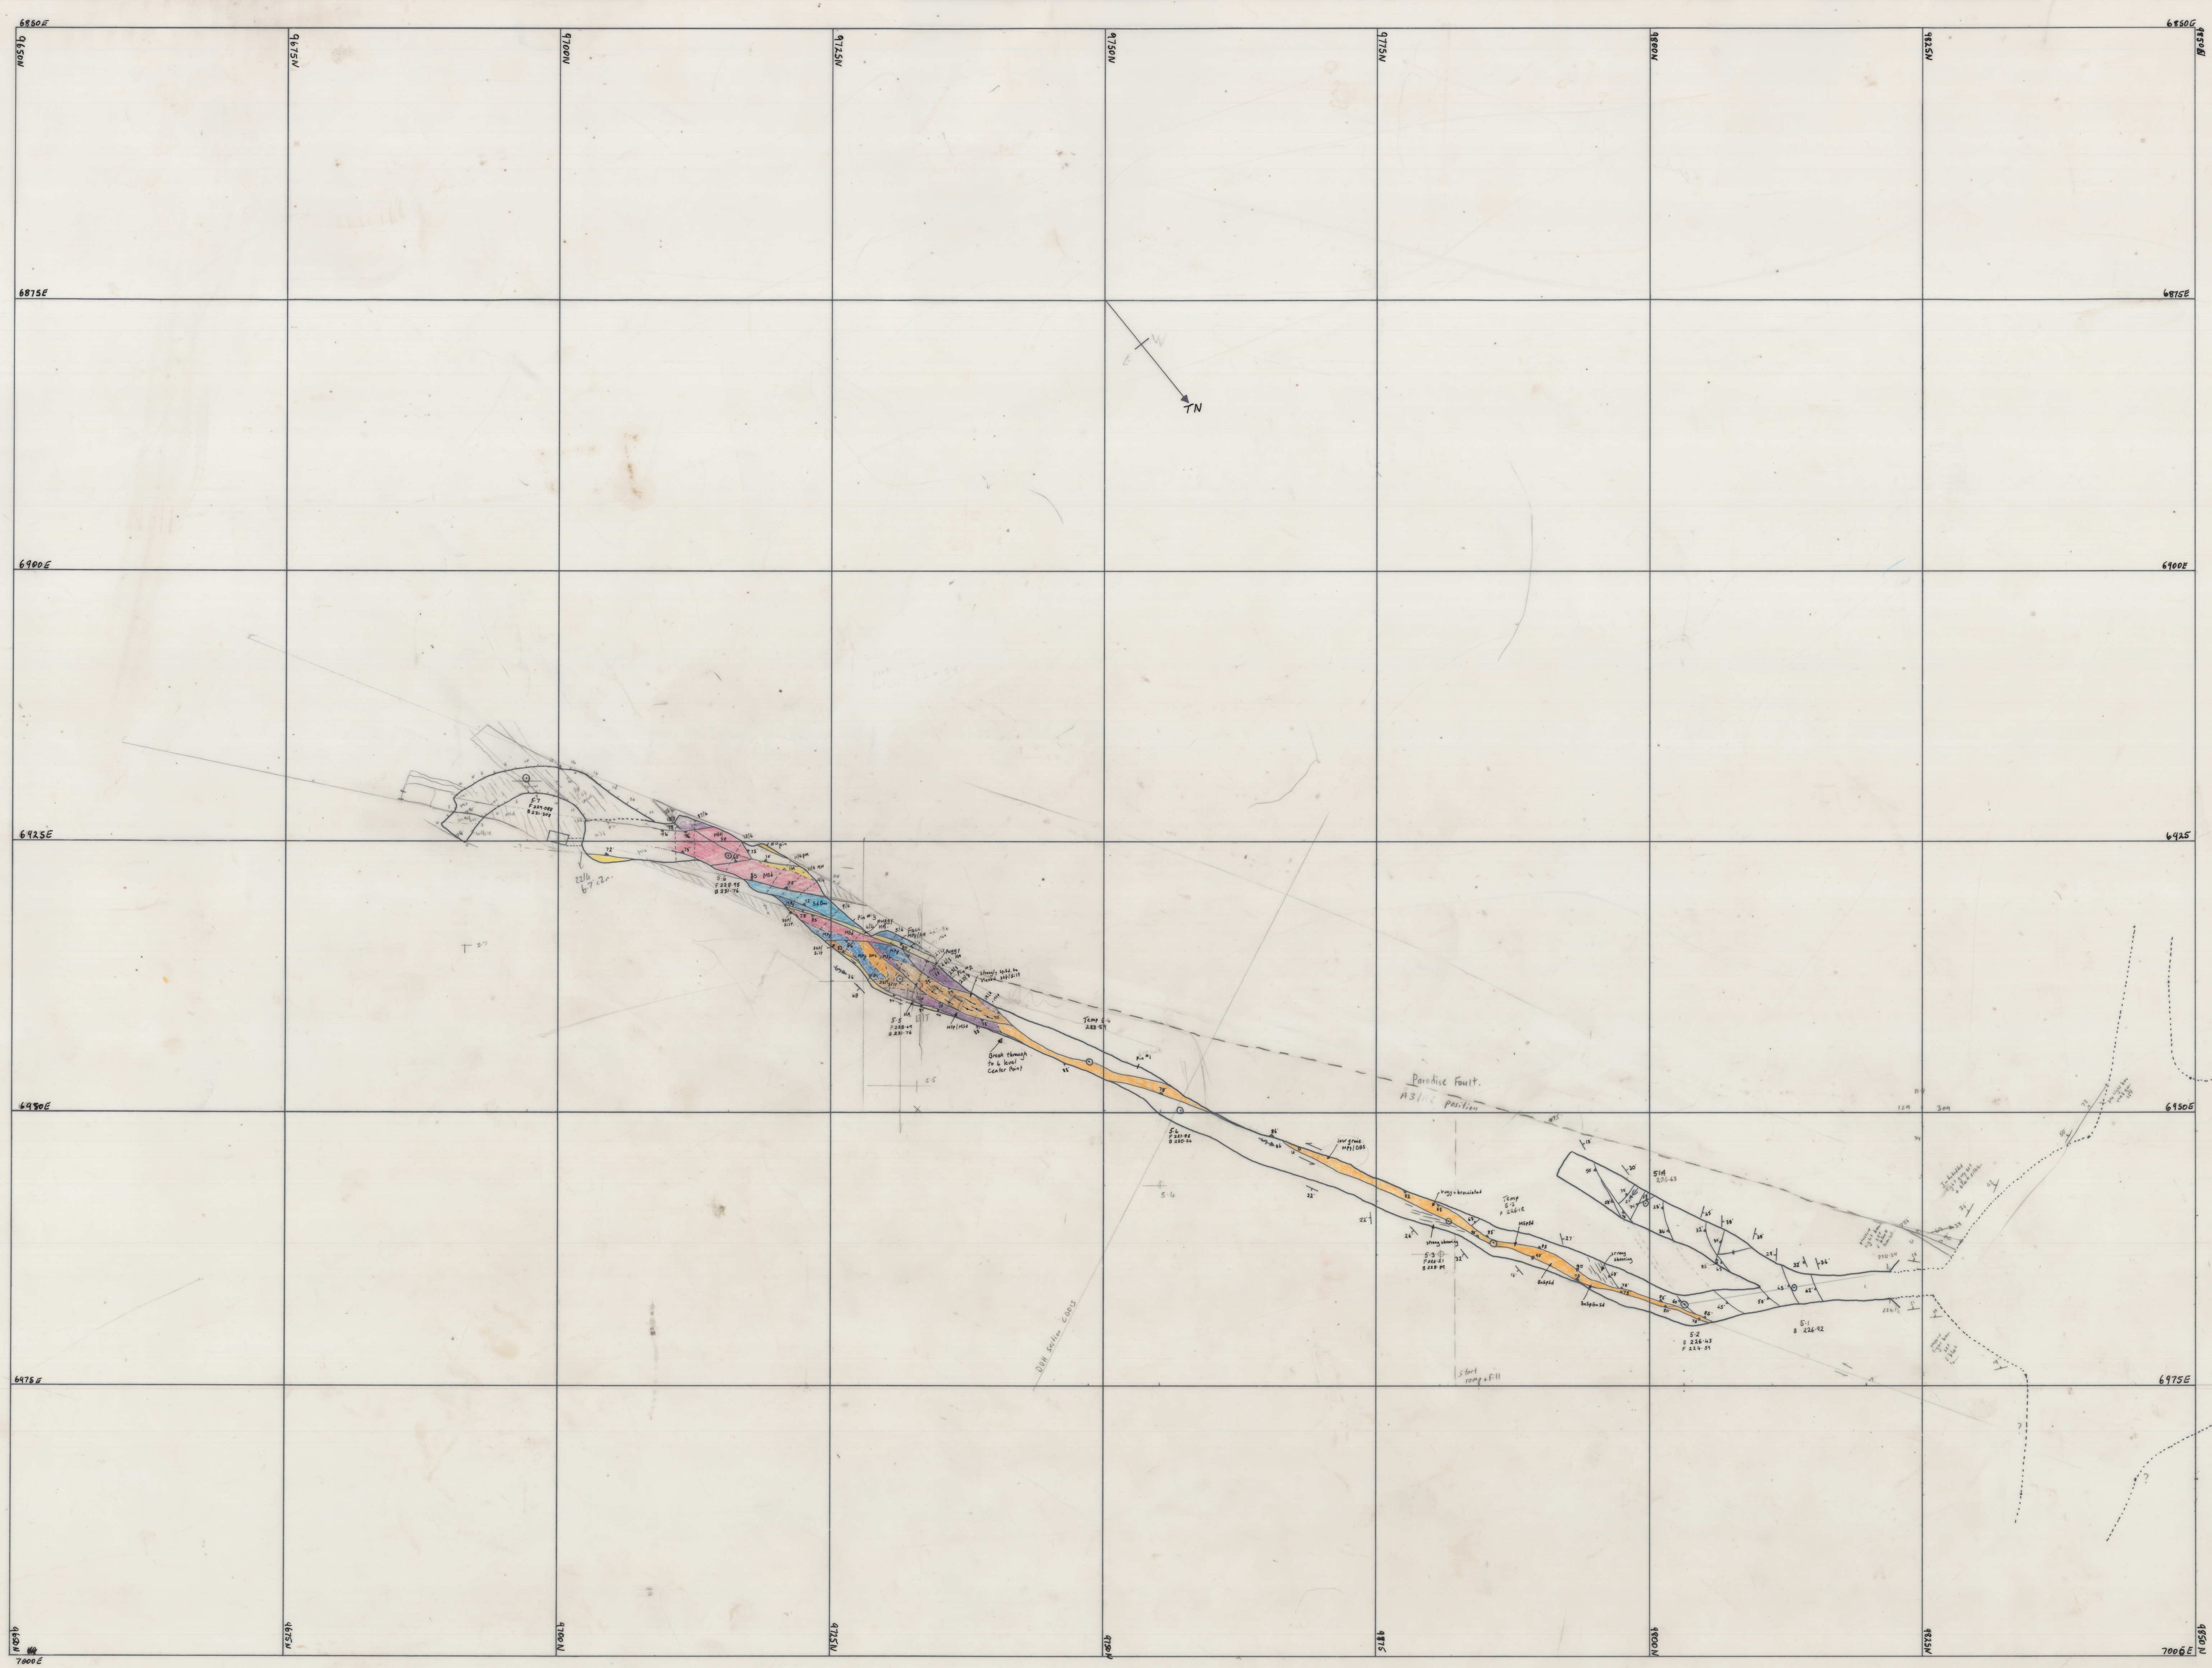

DRAWN	TER	QUE RIVER MINING PTY. LTD.	
TRACED		5 Level RL-226	
CHECKED		DRAWING No.	
APPROVED			
		SCALE 1:250	DATE 14/4/11
		REVISION	SHEET