


True N to Grid North + 5'

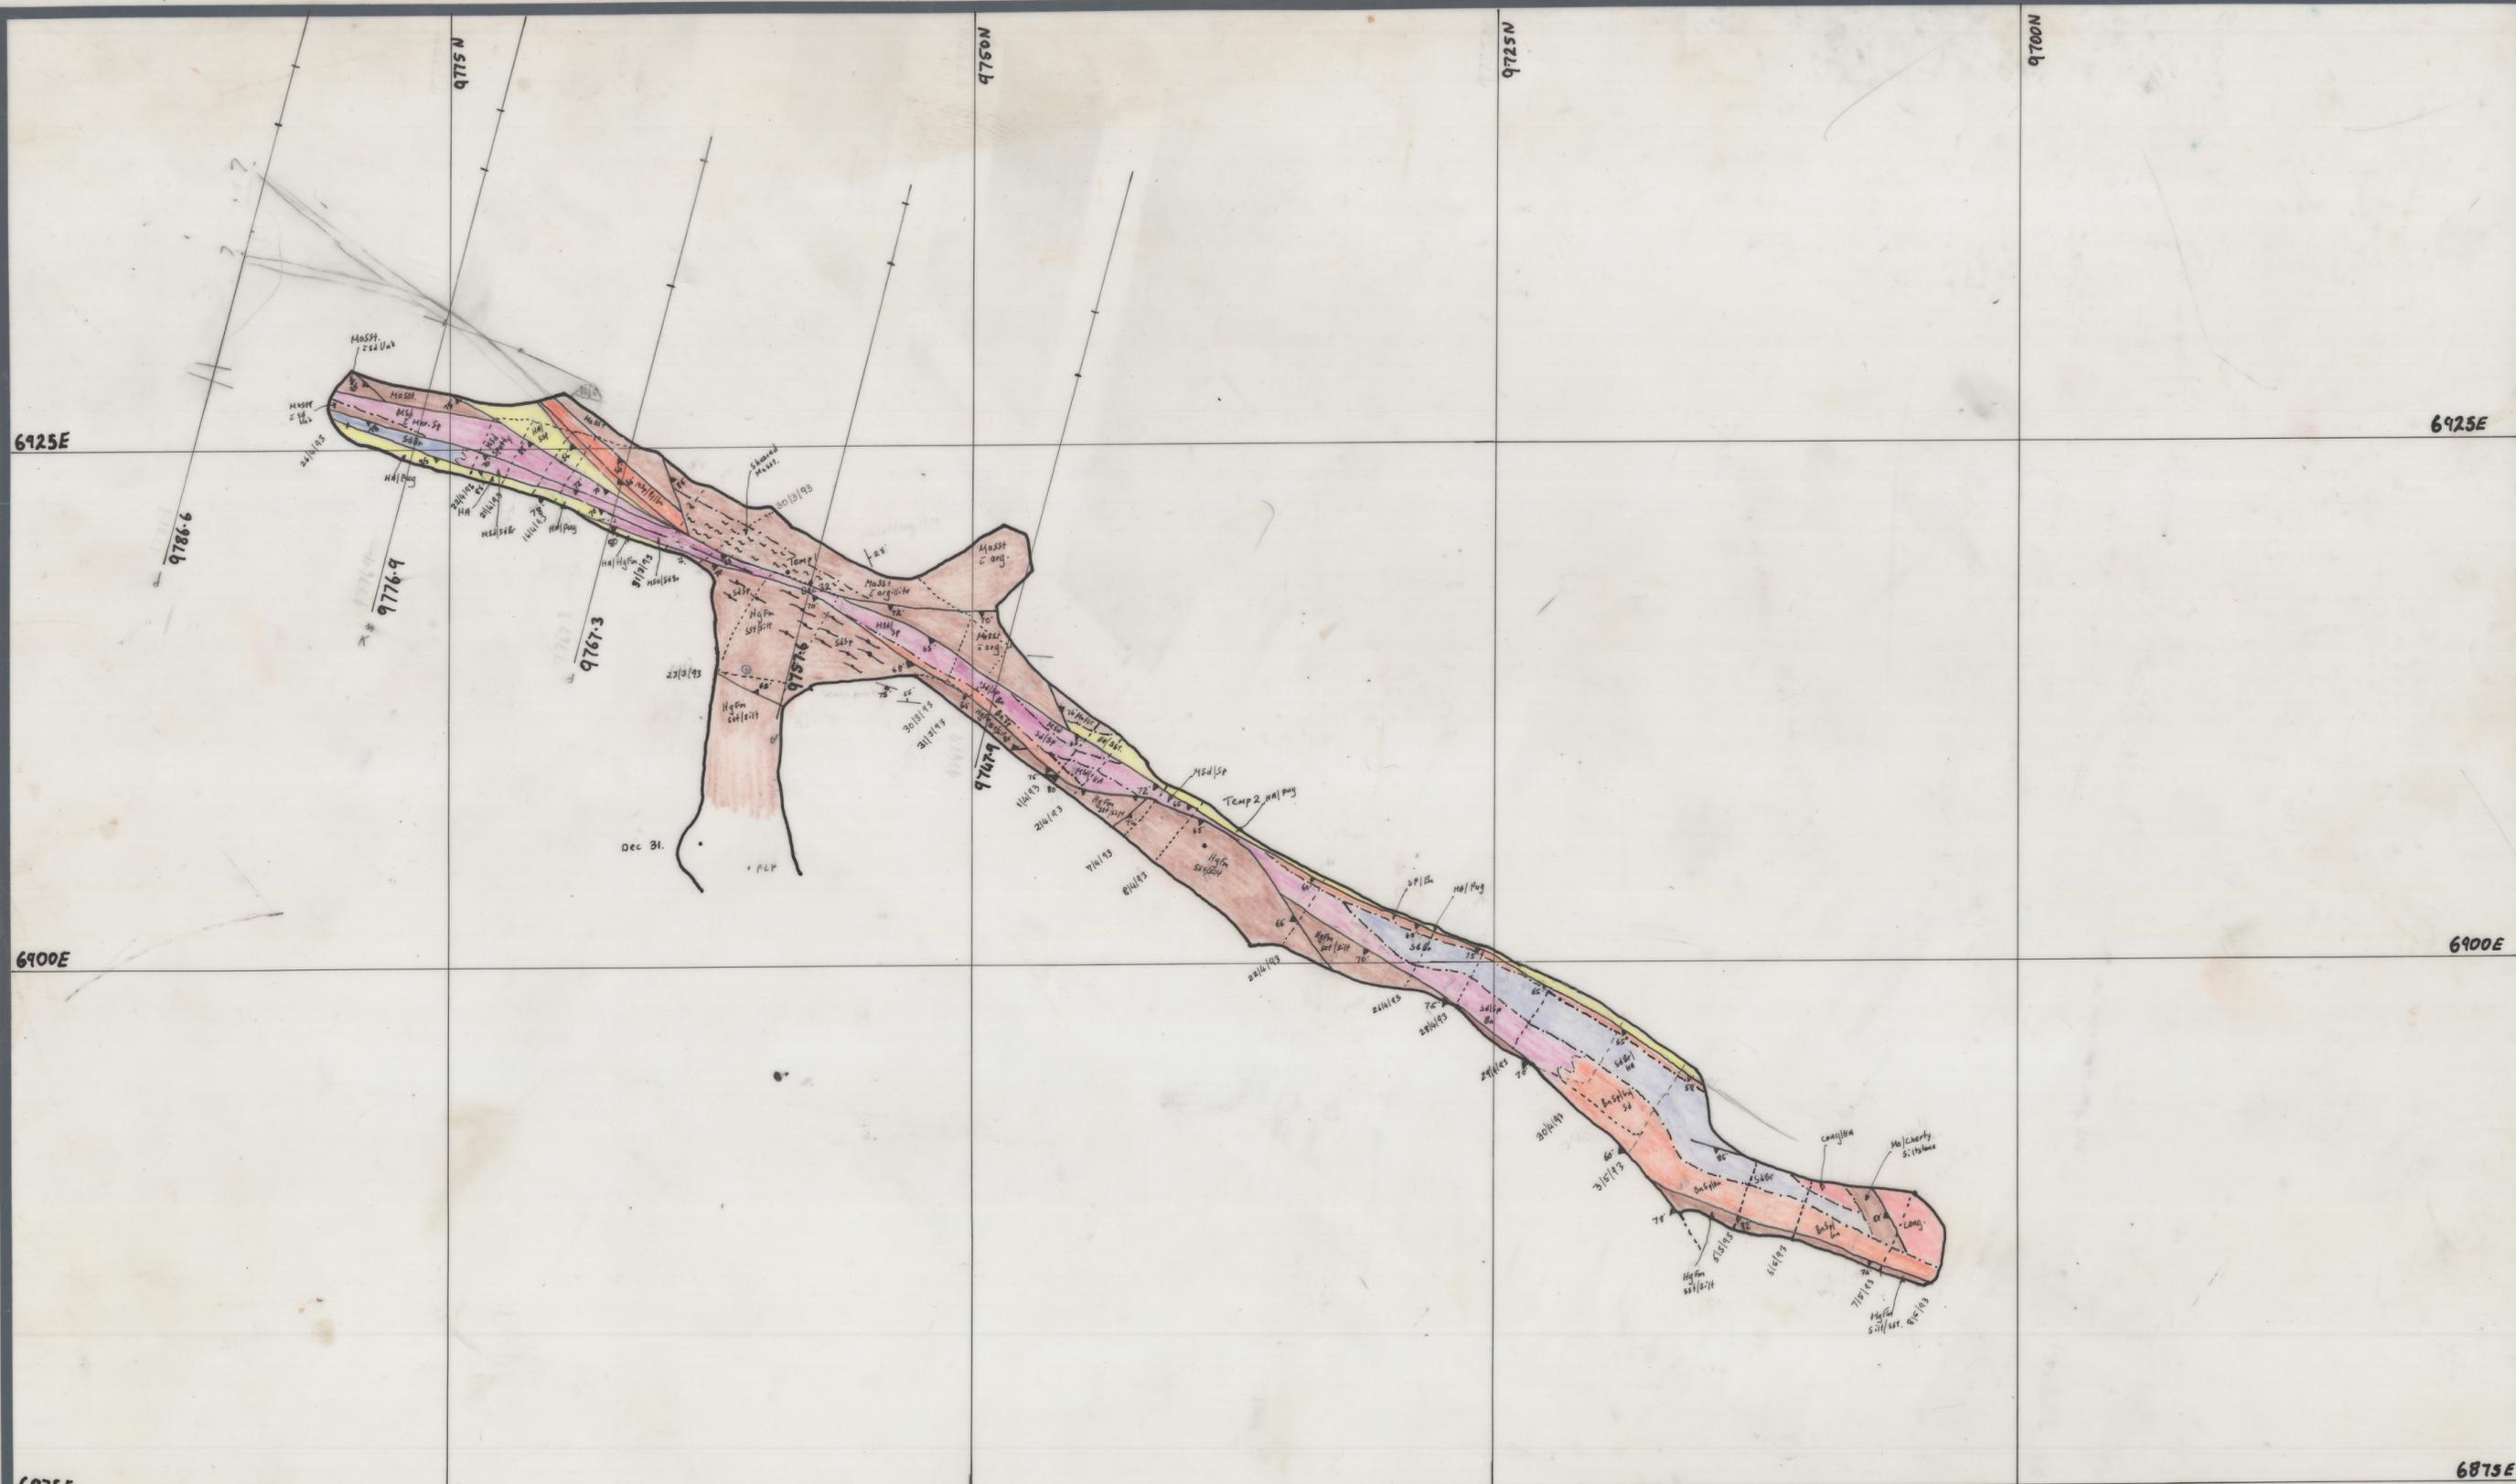

6925E

6925E


6900E

6900E

6875E

6875E

CLEVELAND TIN Ltd.		DRAWN	TEA
LUINA TASMANIA. 7321		SCALE	1:250
SOUTH COMET 10 LEVEL GEOLOGY		DATE	12/5/93
At Floor RL's		CHECKED	

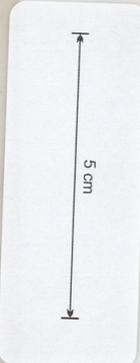

0154-
028