


MINETECH AUST PTY LTD
 SOUTH COMET MINE
 9 LEVEL MASTER
 SCALE 1: 250
 DATE 17-JUL-92
 LEVEL 9LV-1
 WEST COAST SURVEYS PTY LTD

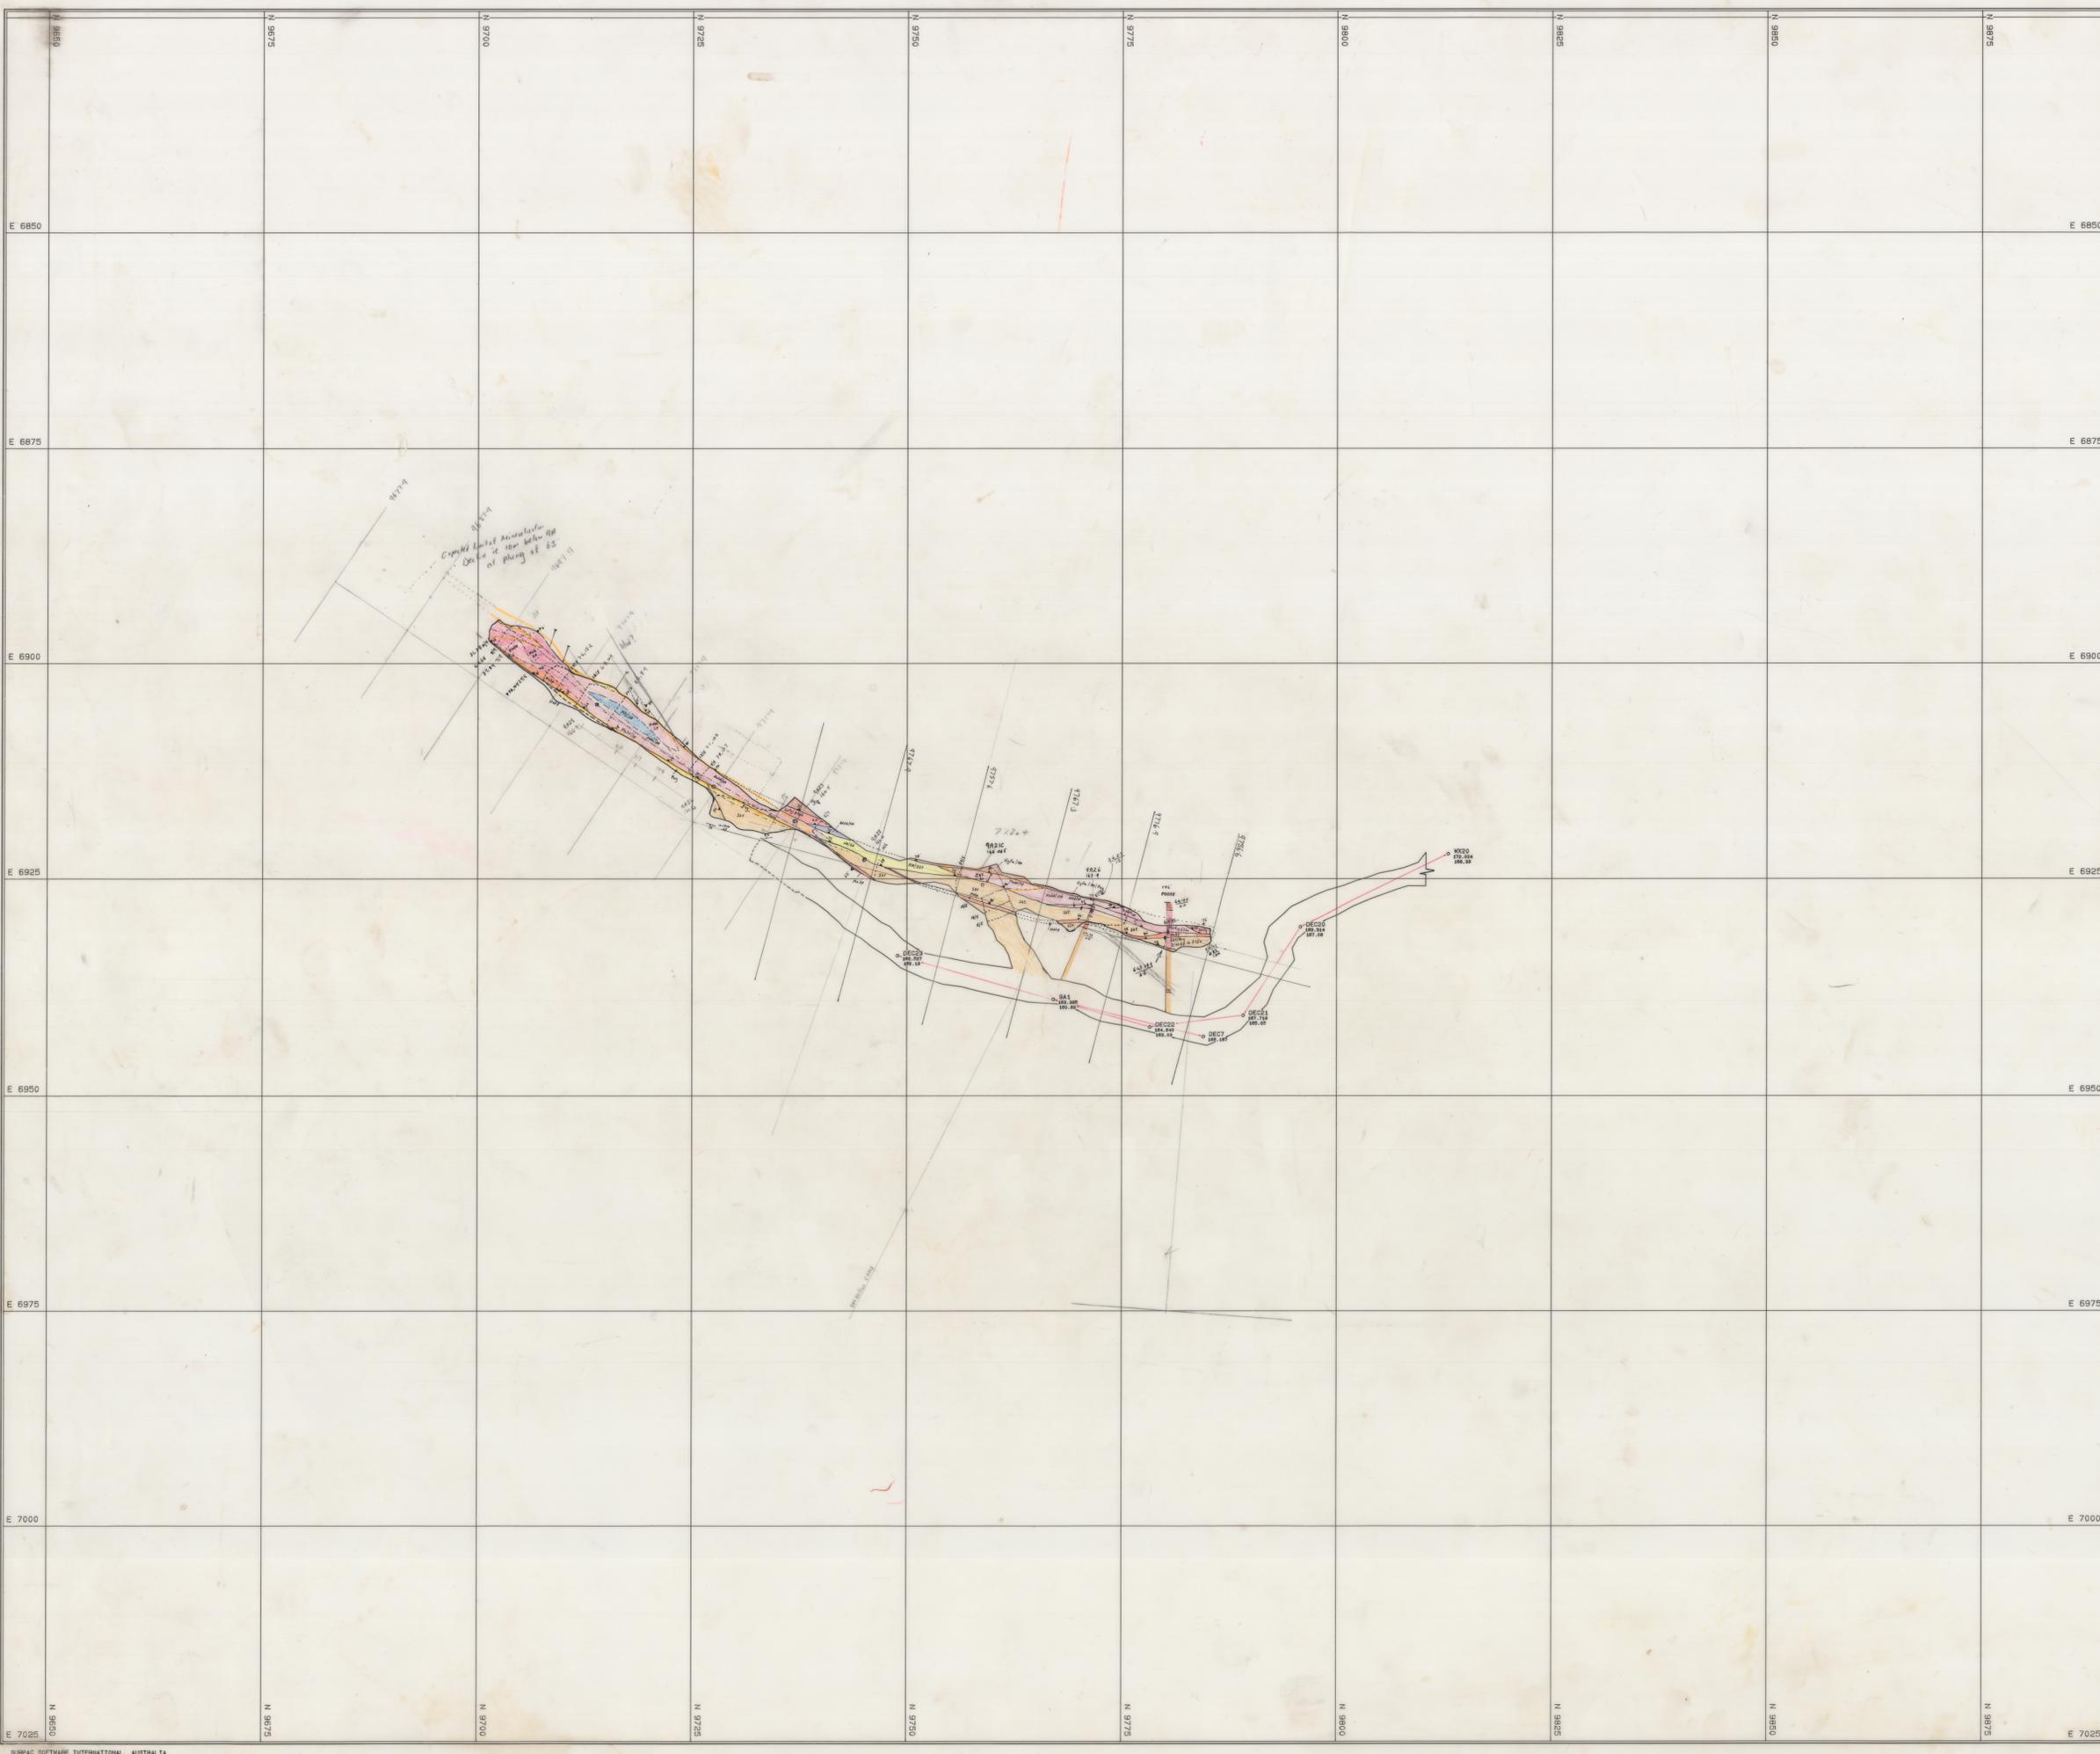

9 LEVEL
 M GEOLOGICAL

①

0154-031