


SECTION

9776.9

0154-035

5 cm

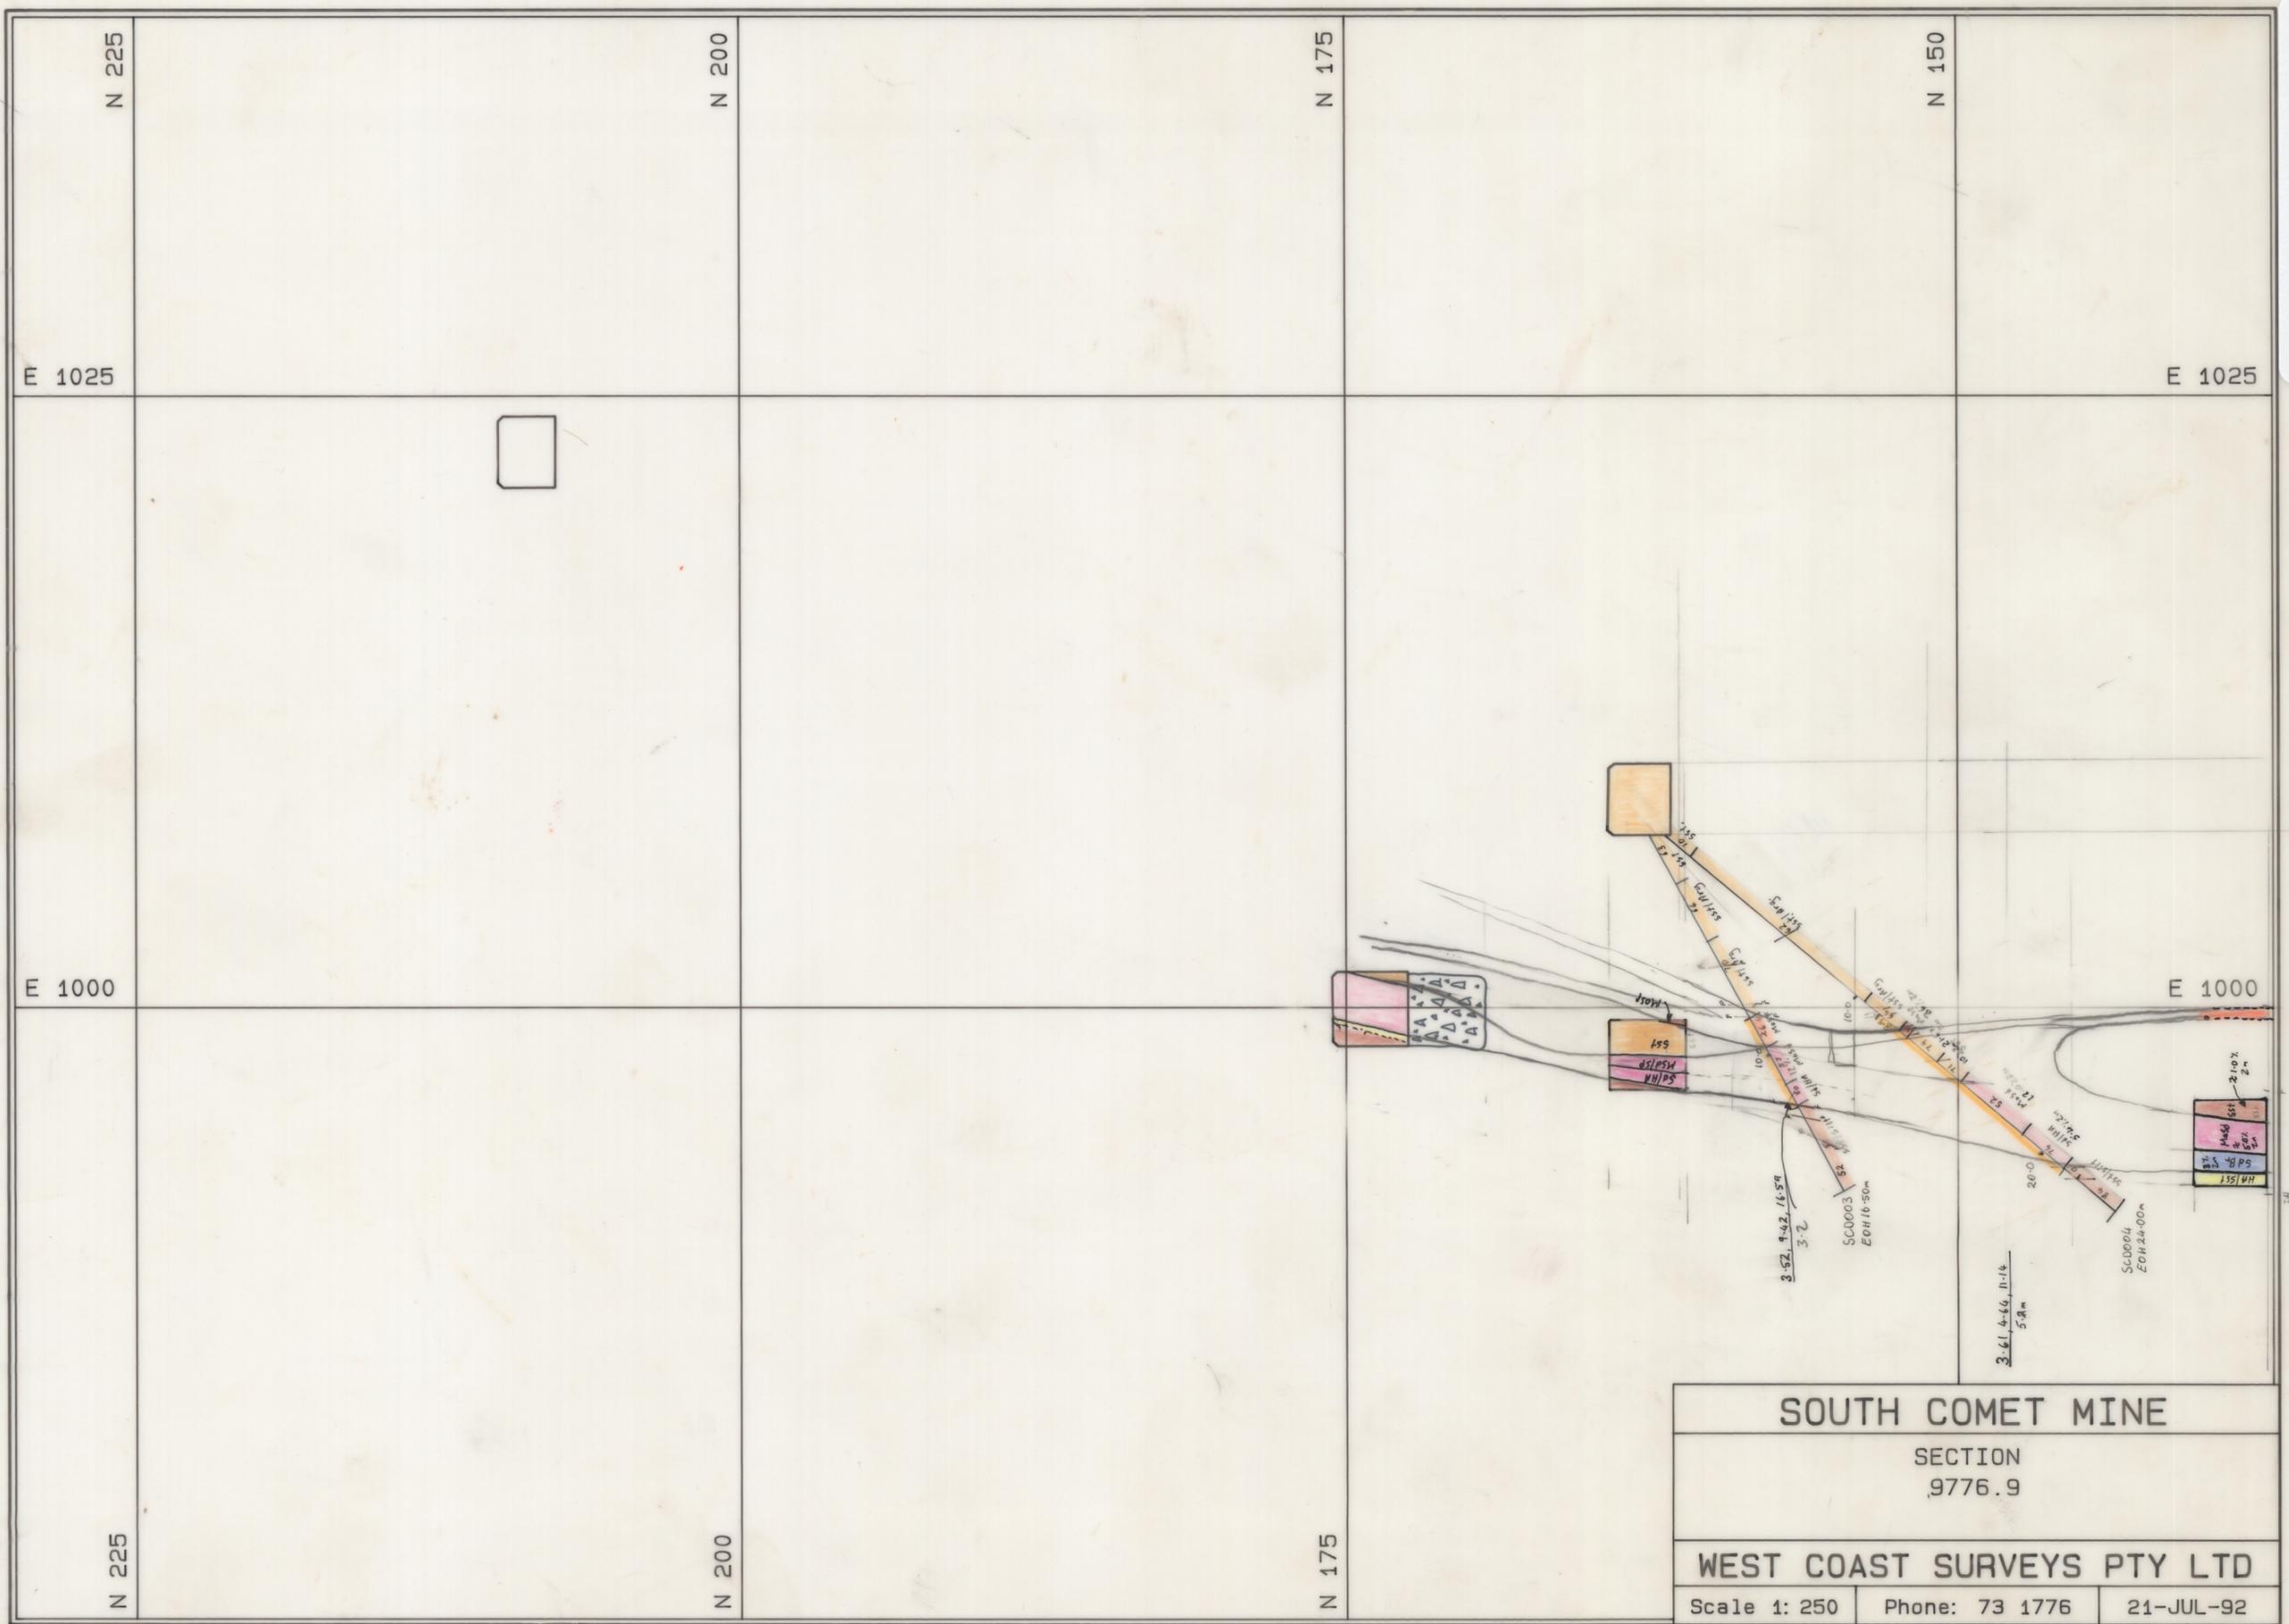

SOUTH COMET MINE

SECTION
9776.9

WEST COAST SURVEYS PTY LTD

Scale 1: 250 Phone: 73 1776 21-JUL-92

XSECH.PF