


MINETECH AUST PTY LTD
 SOUTH COMET MINE
 6 LEVEL MASTER

SCALE	1: 250
DATE	17-JUL-92
LEVEL	6LV-1

WEST COAST SURVEYS PTY LTD

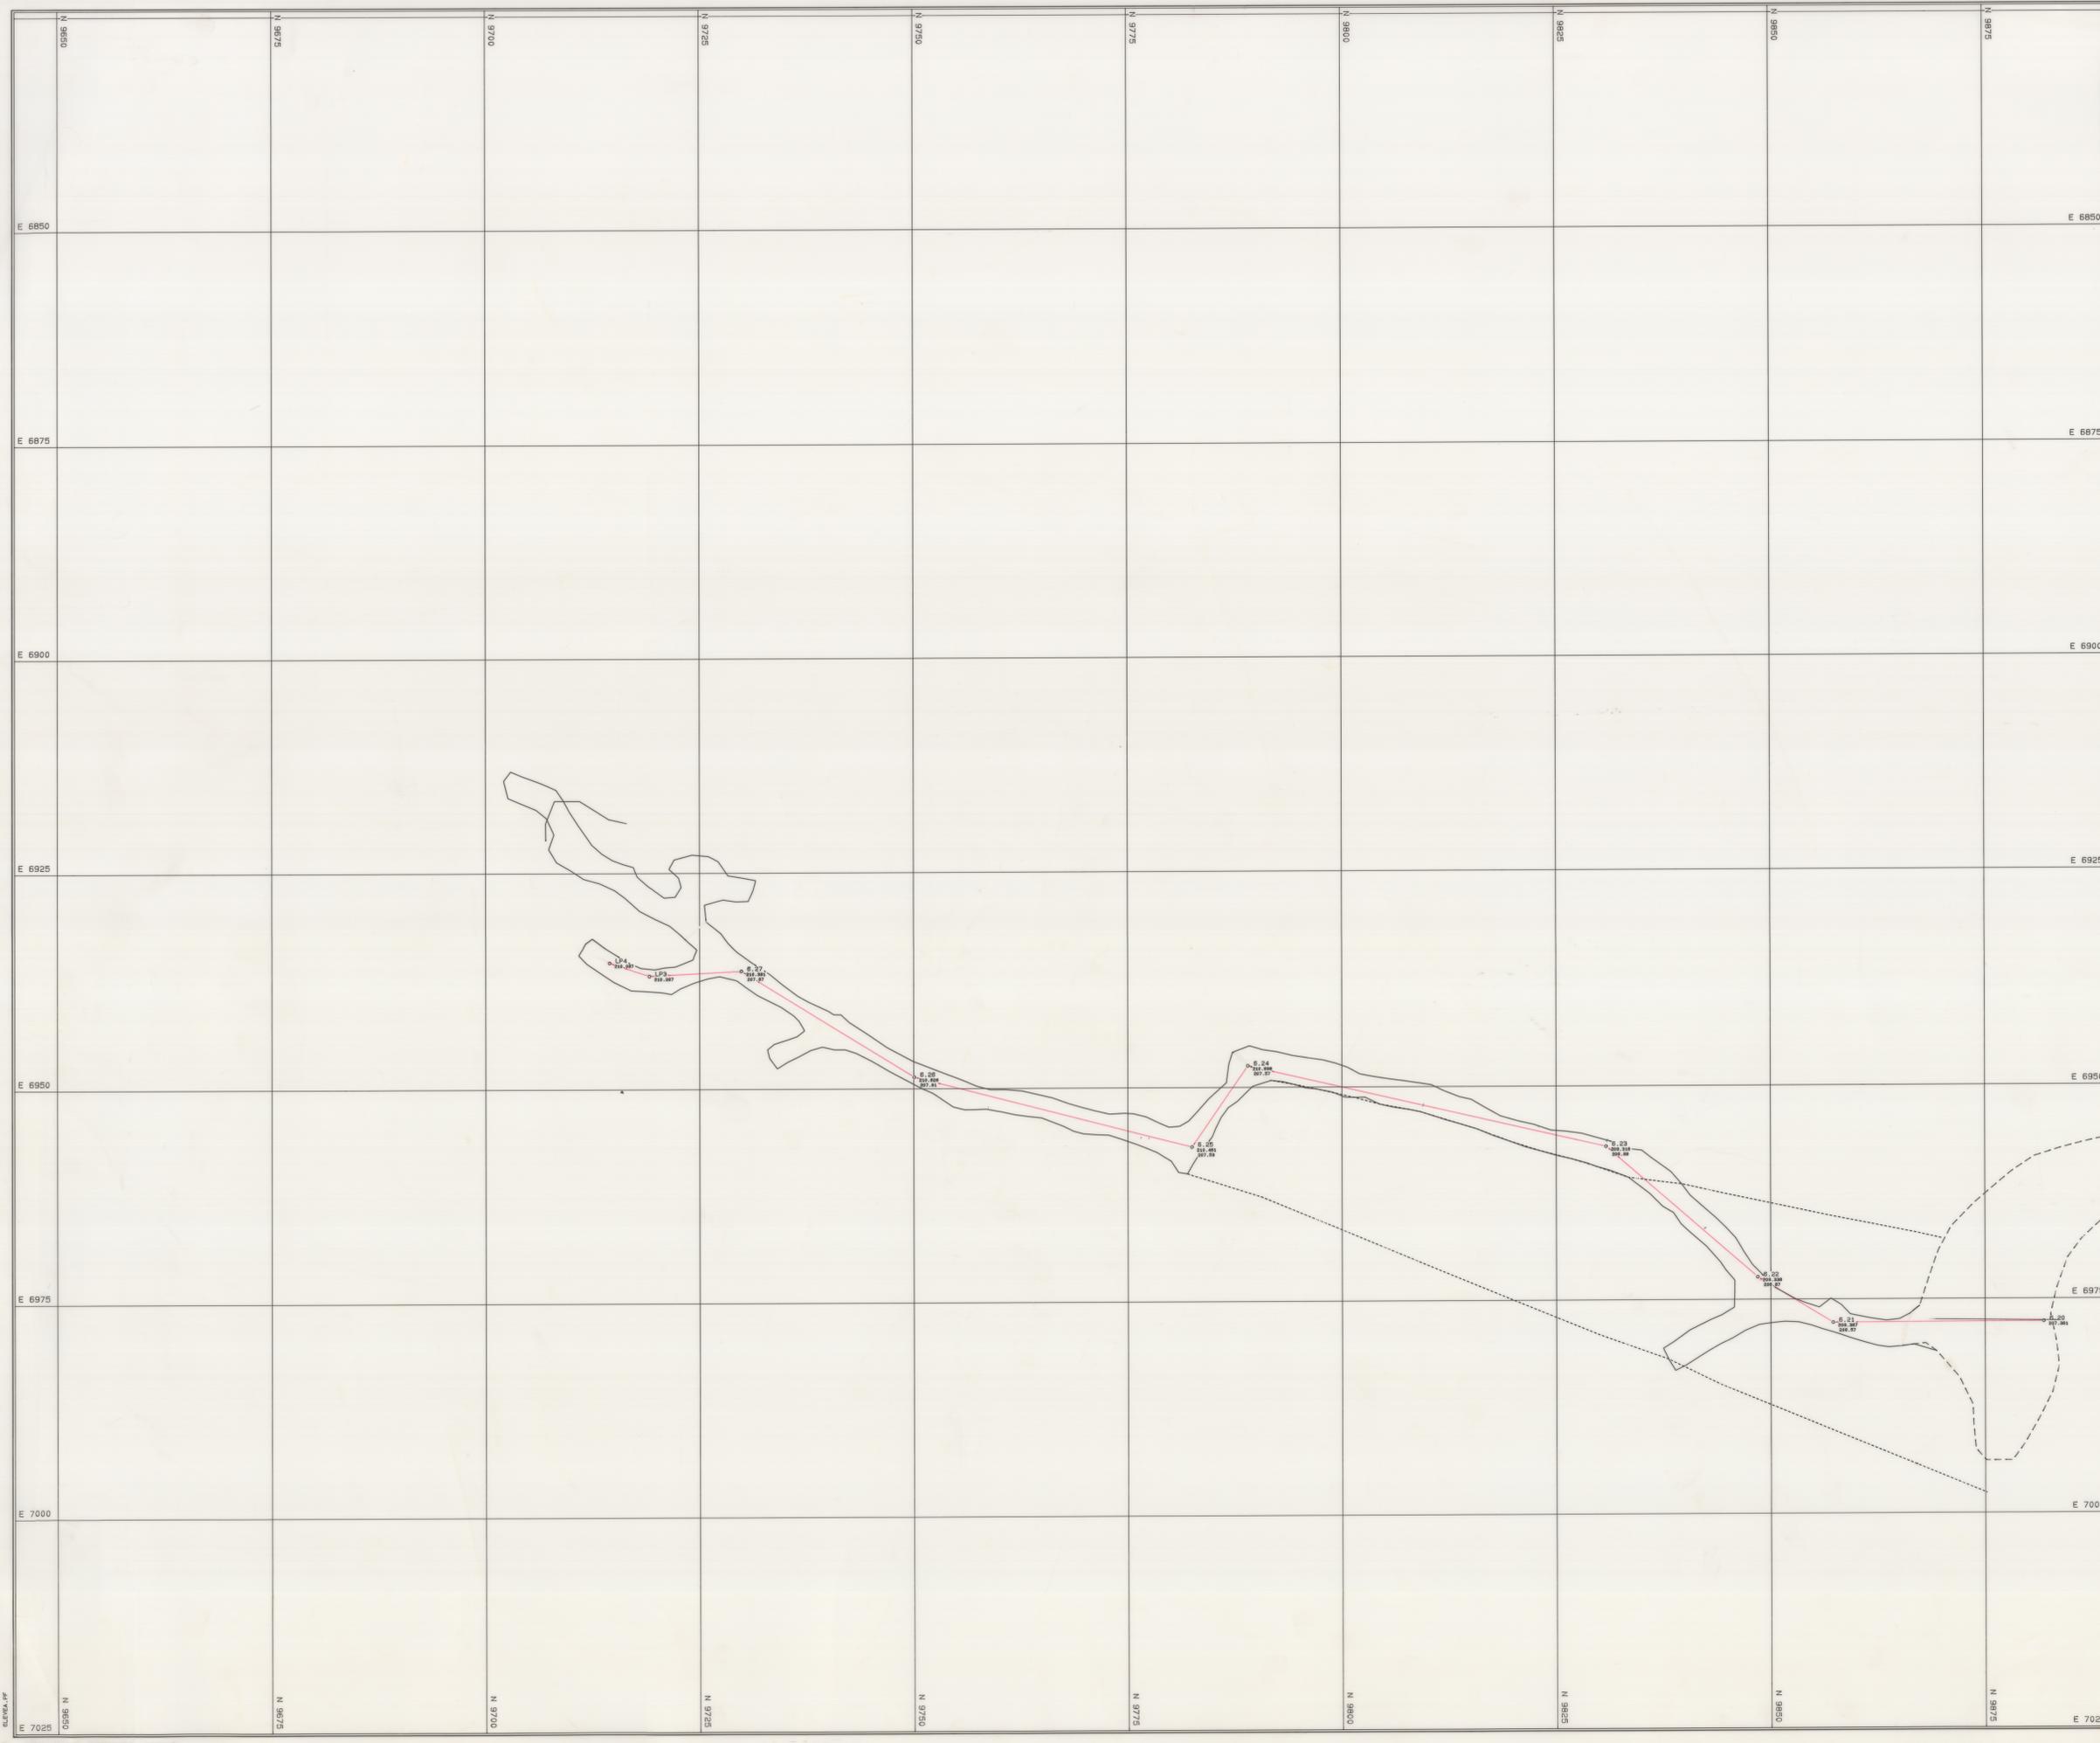

1:250
 6 LEVEL
 MASTER
 ①
 0154-
 0410