


MINETECH AUST PTY LTD	
SOUTH COMET MINE	
8 LEVEL MASTER	
SCALE 1: 250	8LV-2
DATE 17-JUL-92	
LEVEL	
WEST COAST SURVEYS PTY LTD	

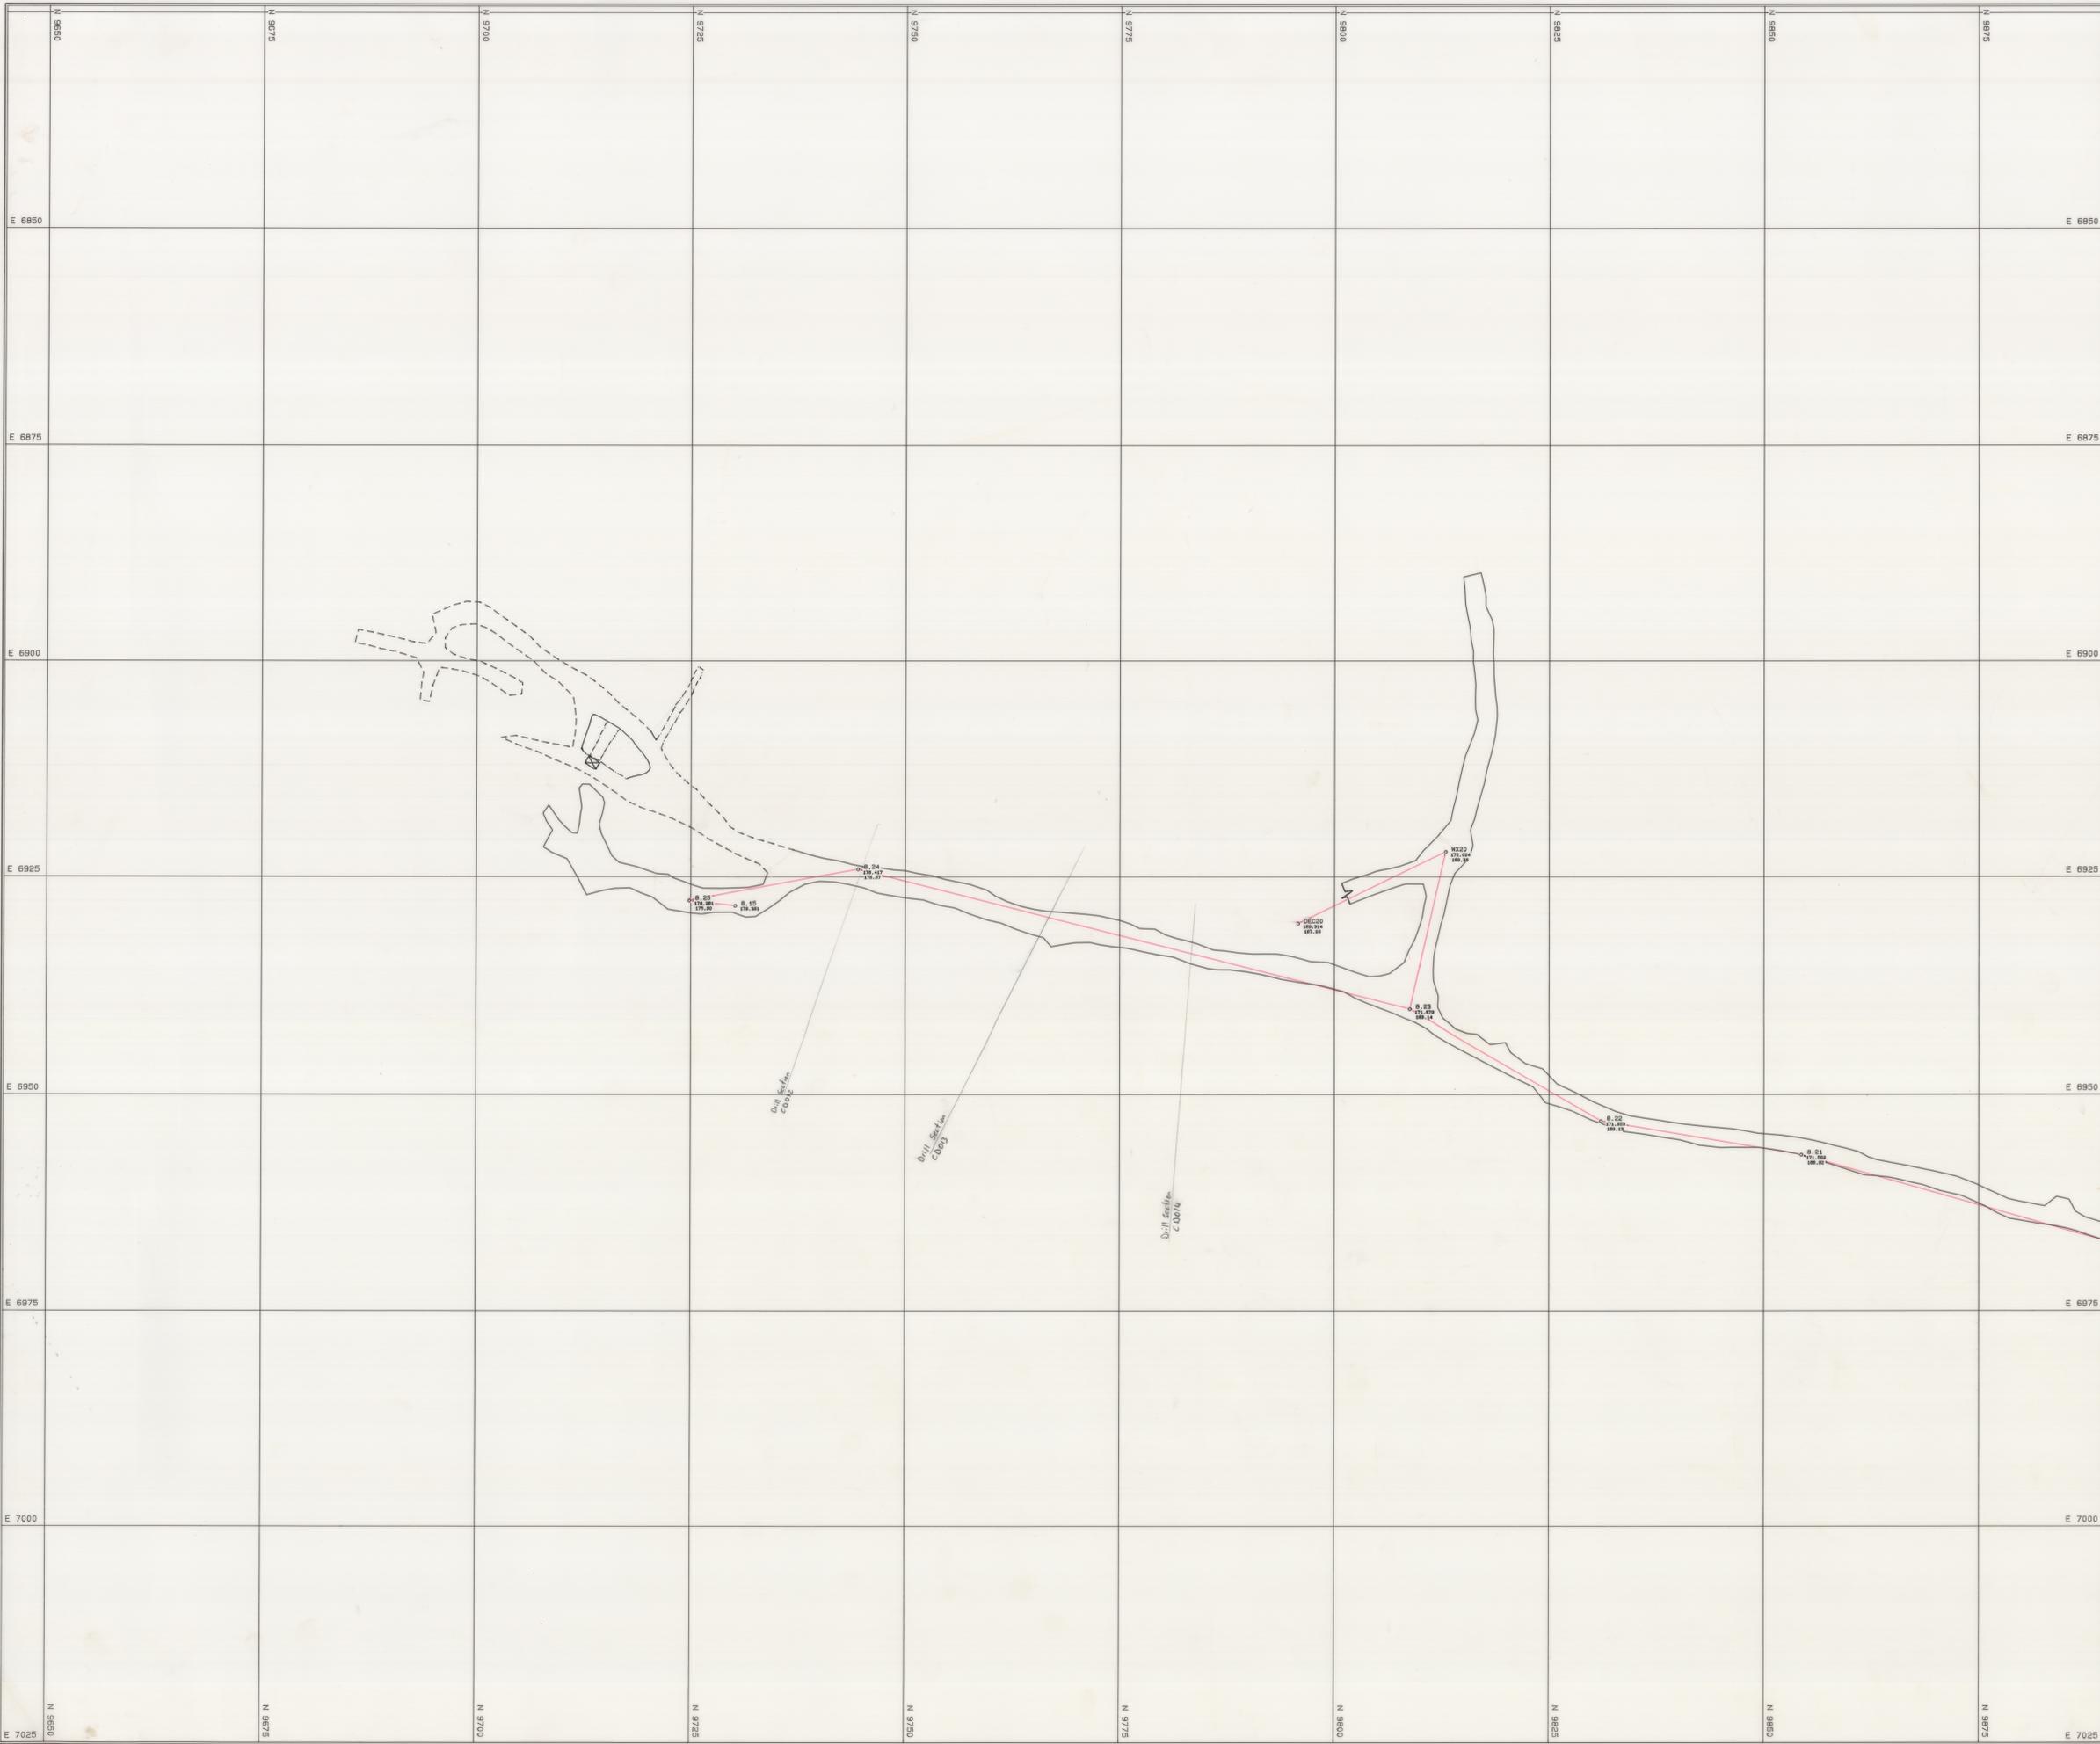

1:250

8 LEVEL
MASTER

①
0154-
042