


MINETECH AUST PTY LTD	
SOUTH COMET MINE	
9 LEVEL MASTER	
SCALE 1: 250	9LV-1
DATE 17-JUL-92	
WEST COAST SURVEYS PTY LTD	

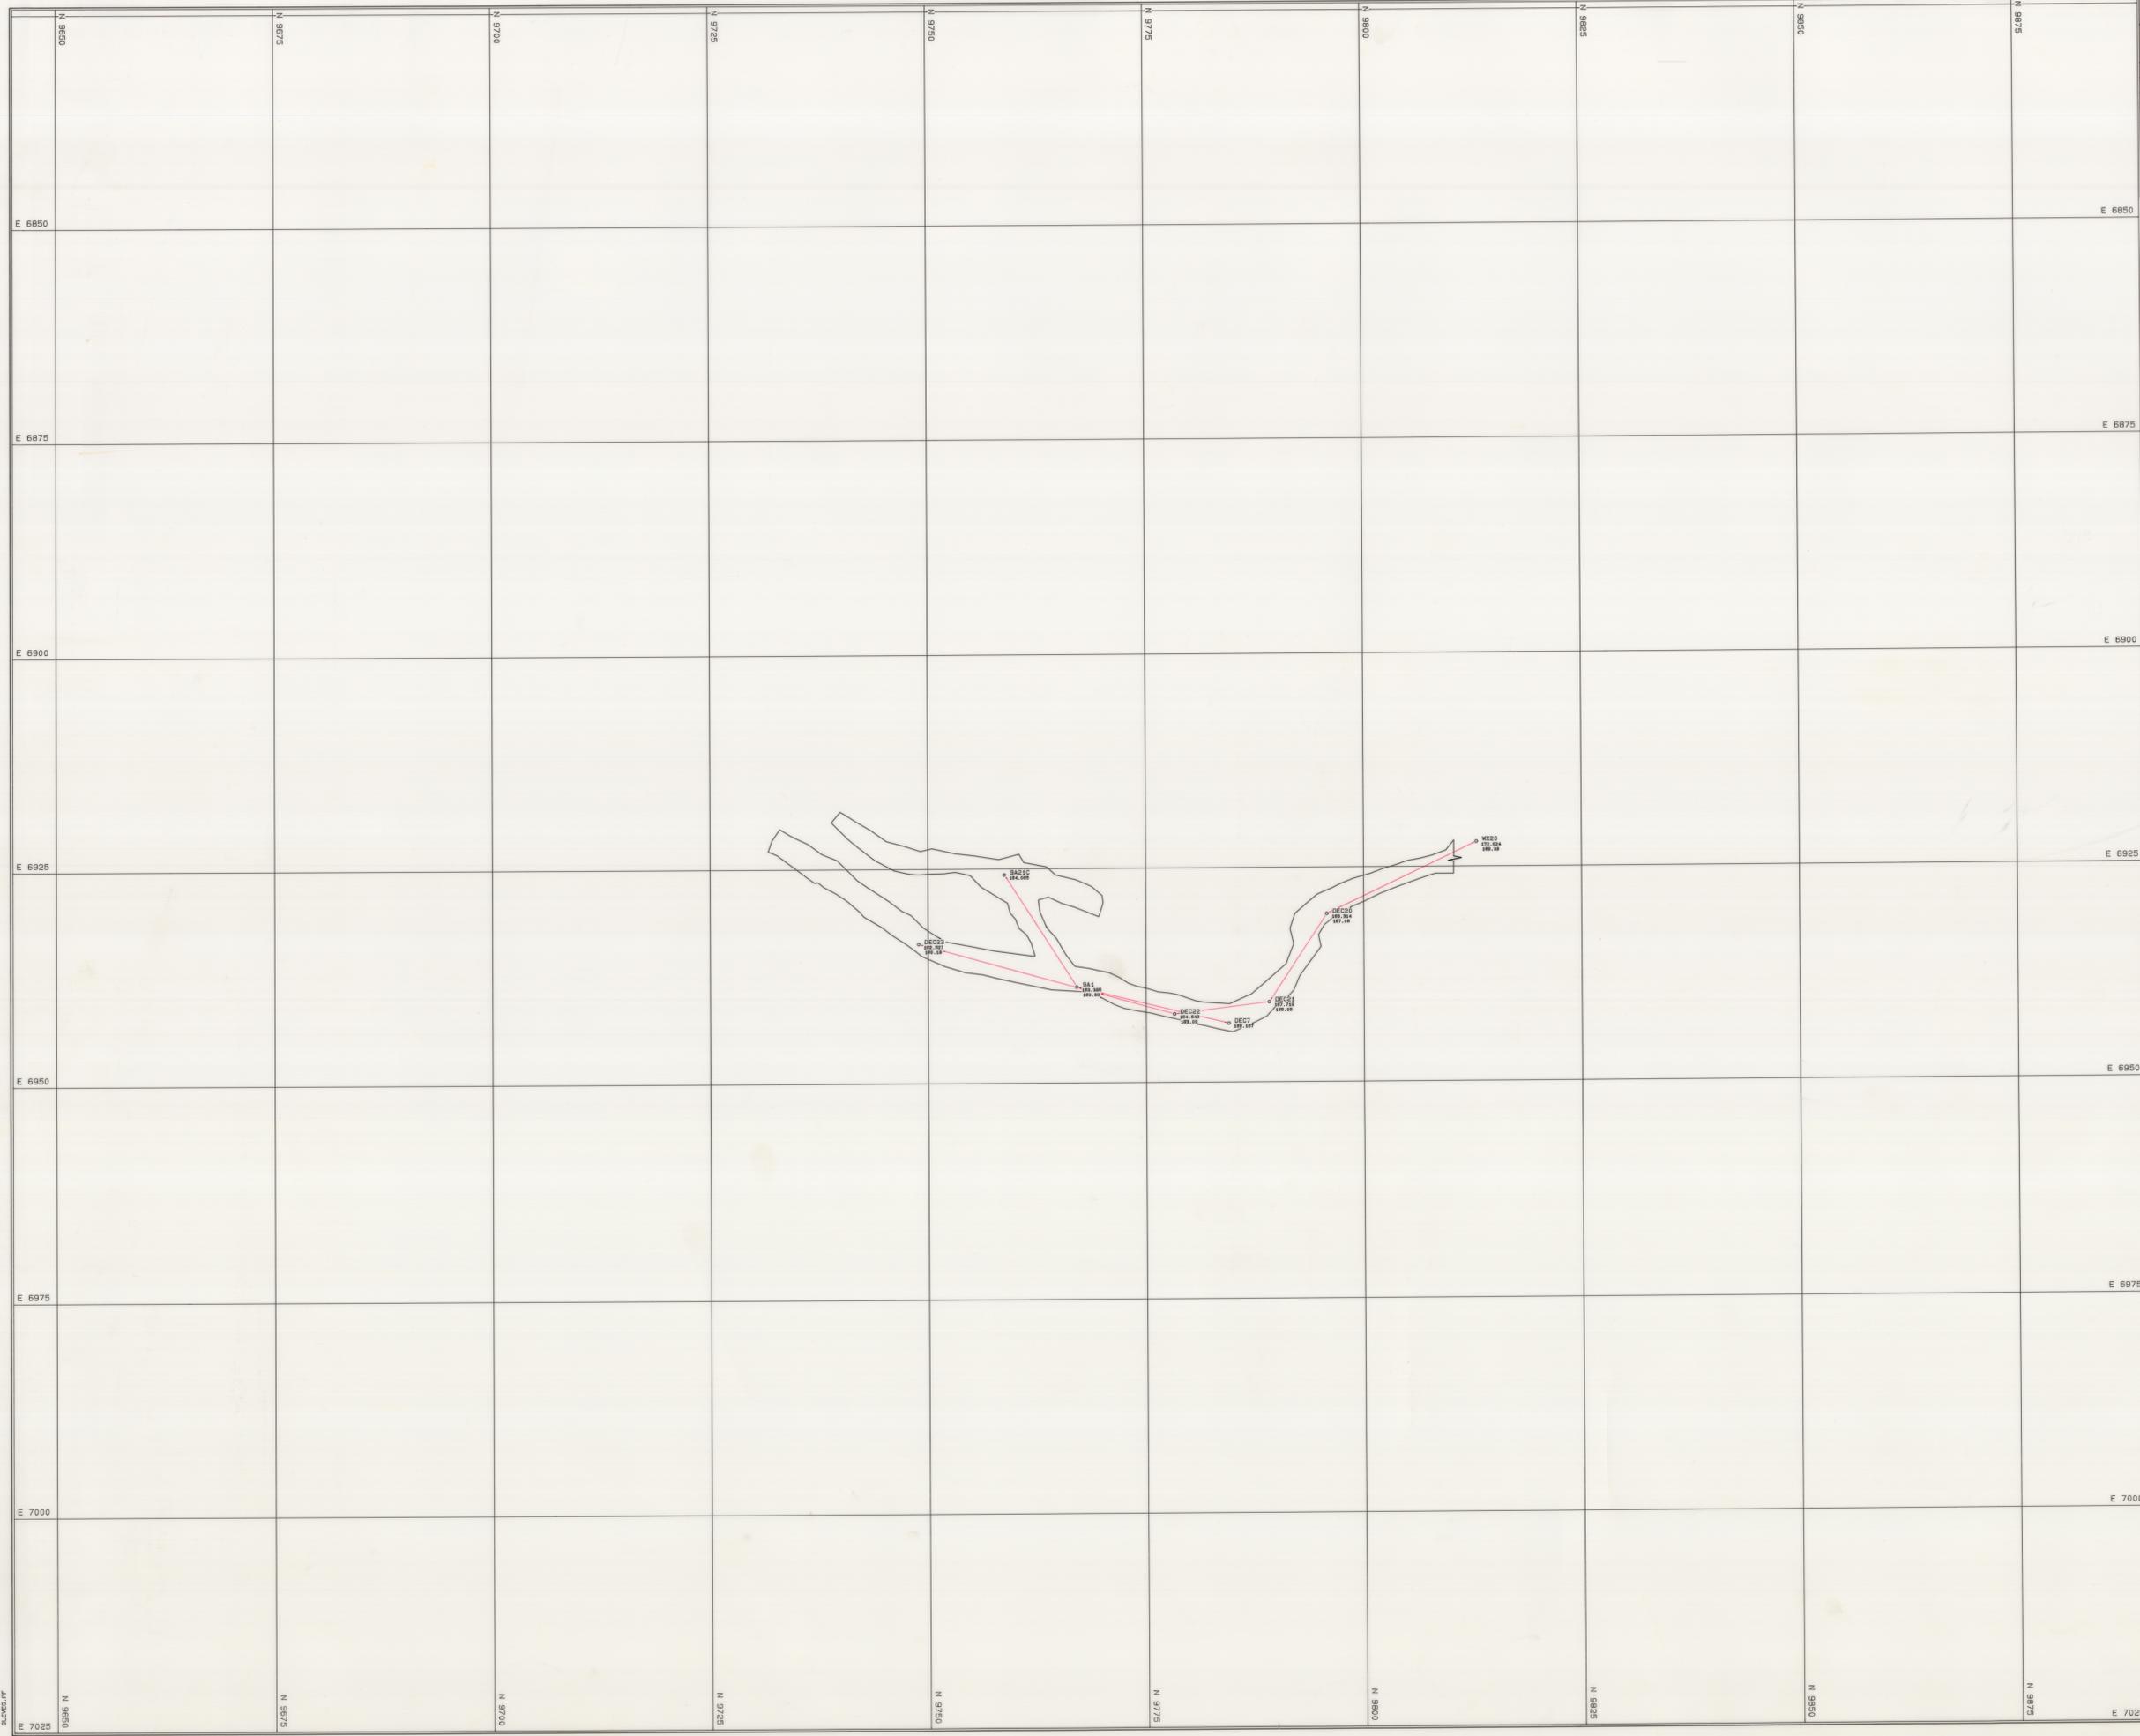

1:250

9 LEVEL MASTER

2

0154-043