


Surface
1:1000



0154 -
04-8

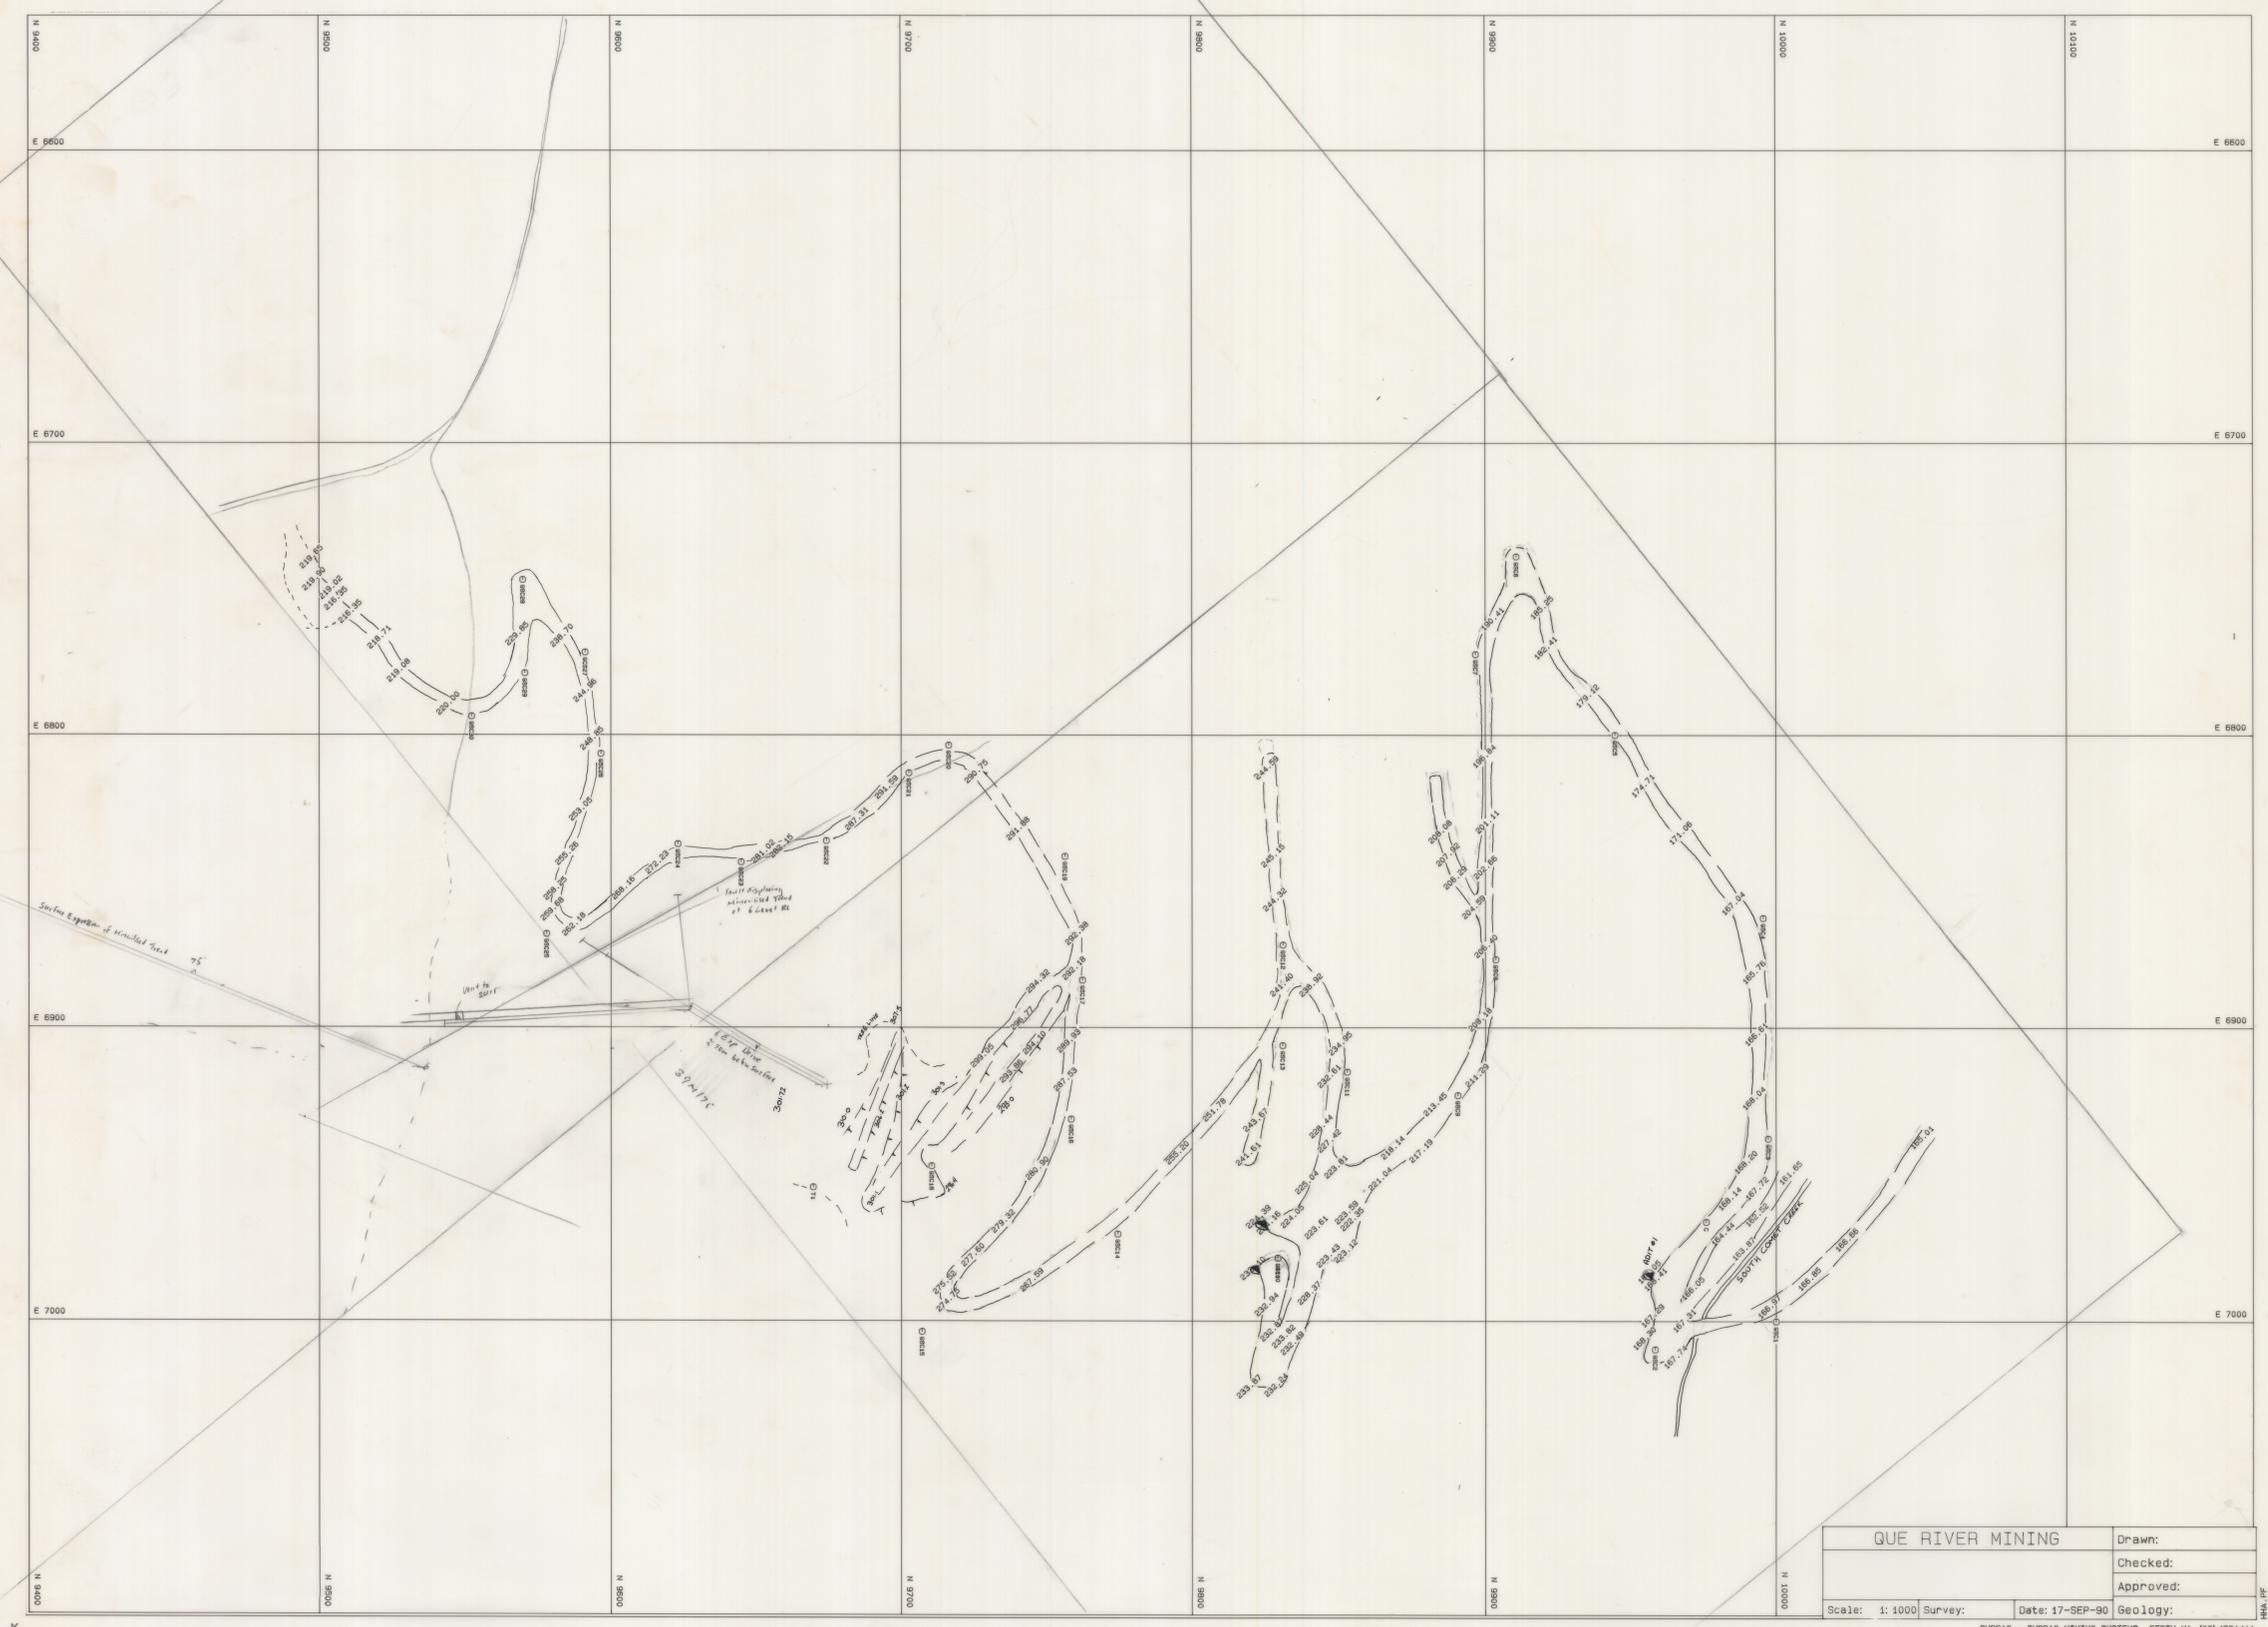

QUE RIVER MINING		Drawn:
		Checked:
		Approved:
Scale: 1:1000	Survey:	Geology:
Date: 17-SEP-90		