


0154-049

Surface
1:500

5 cm

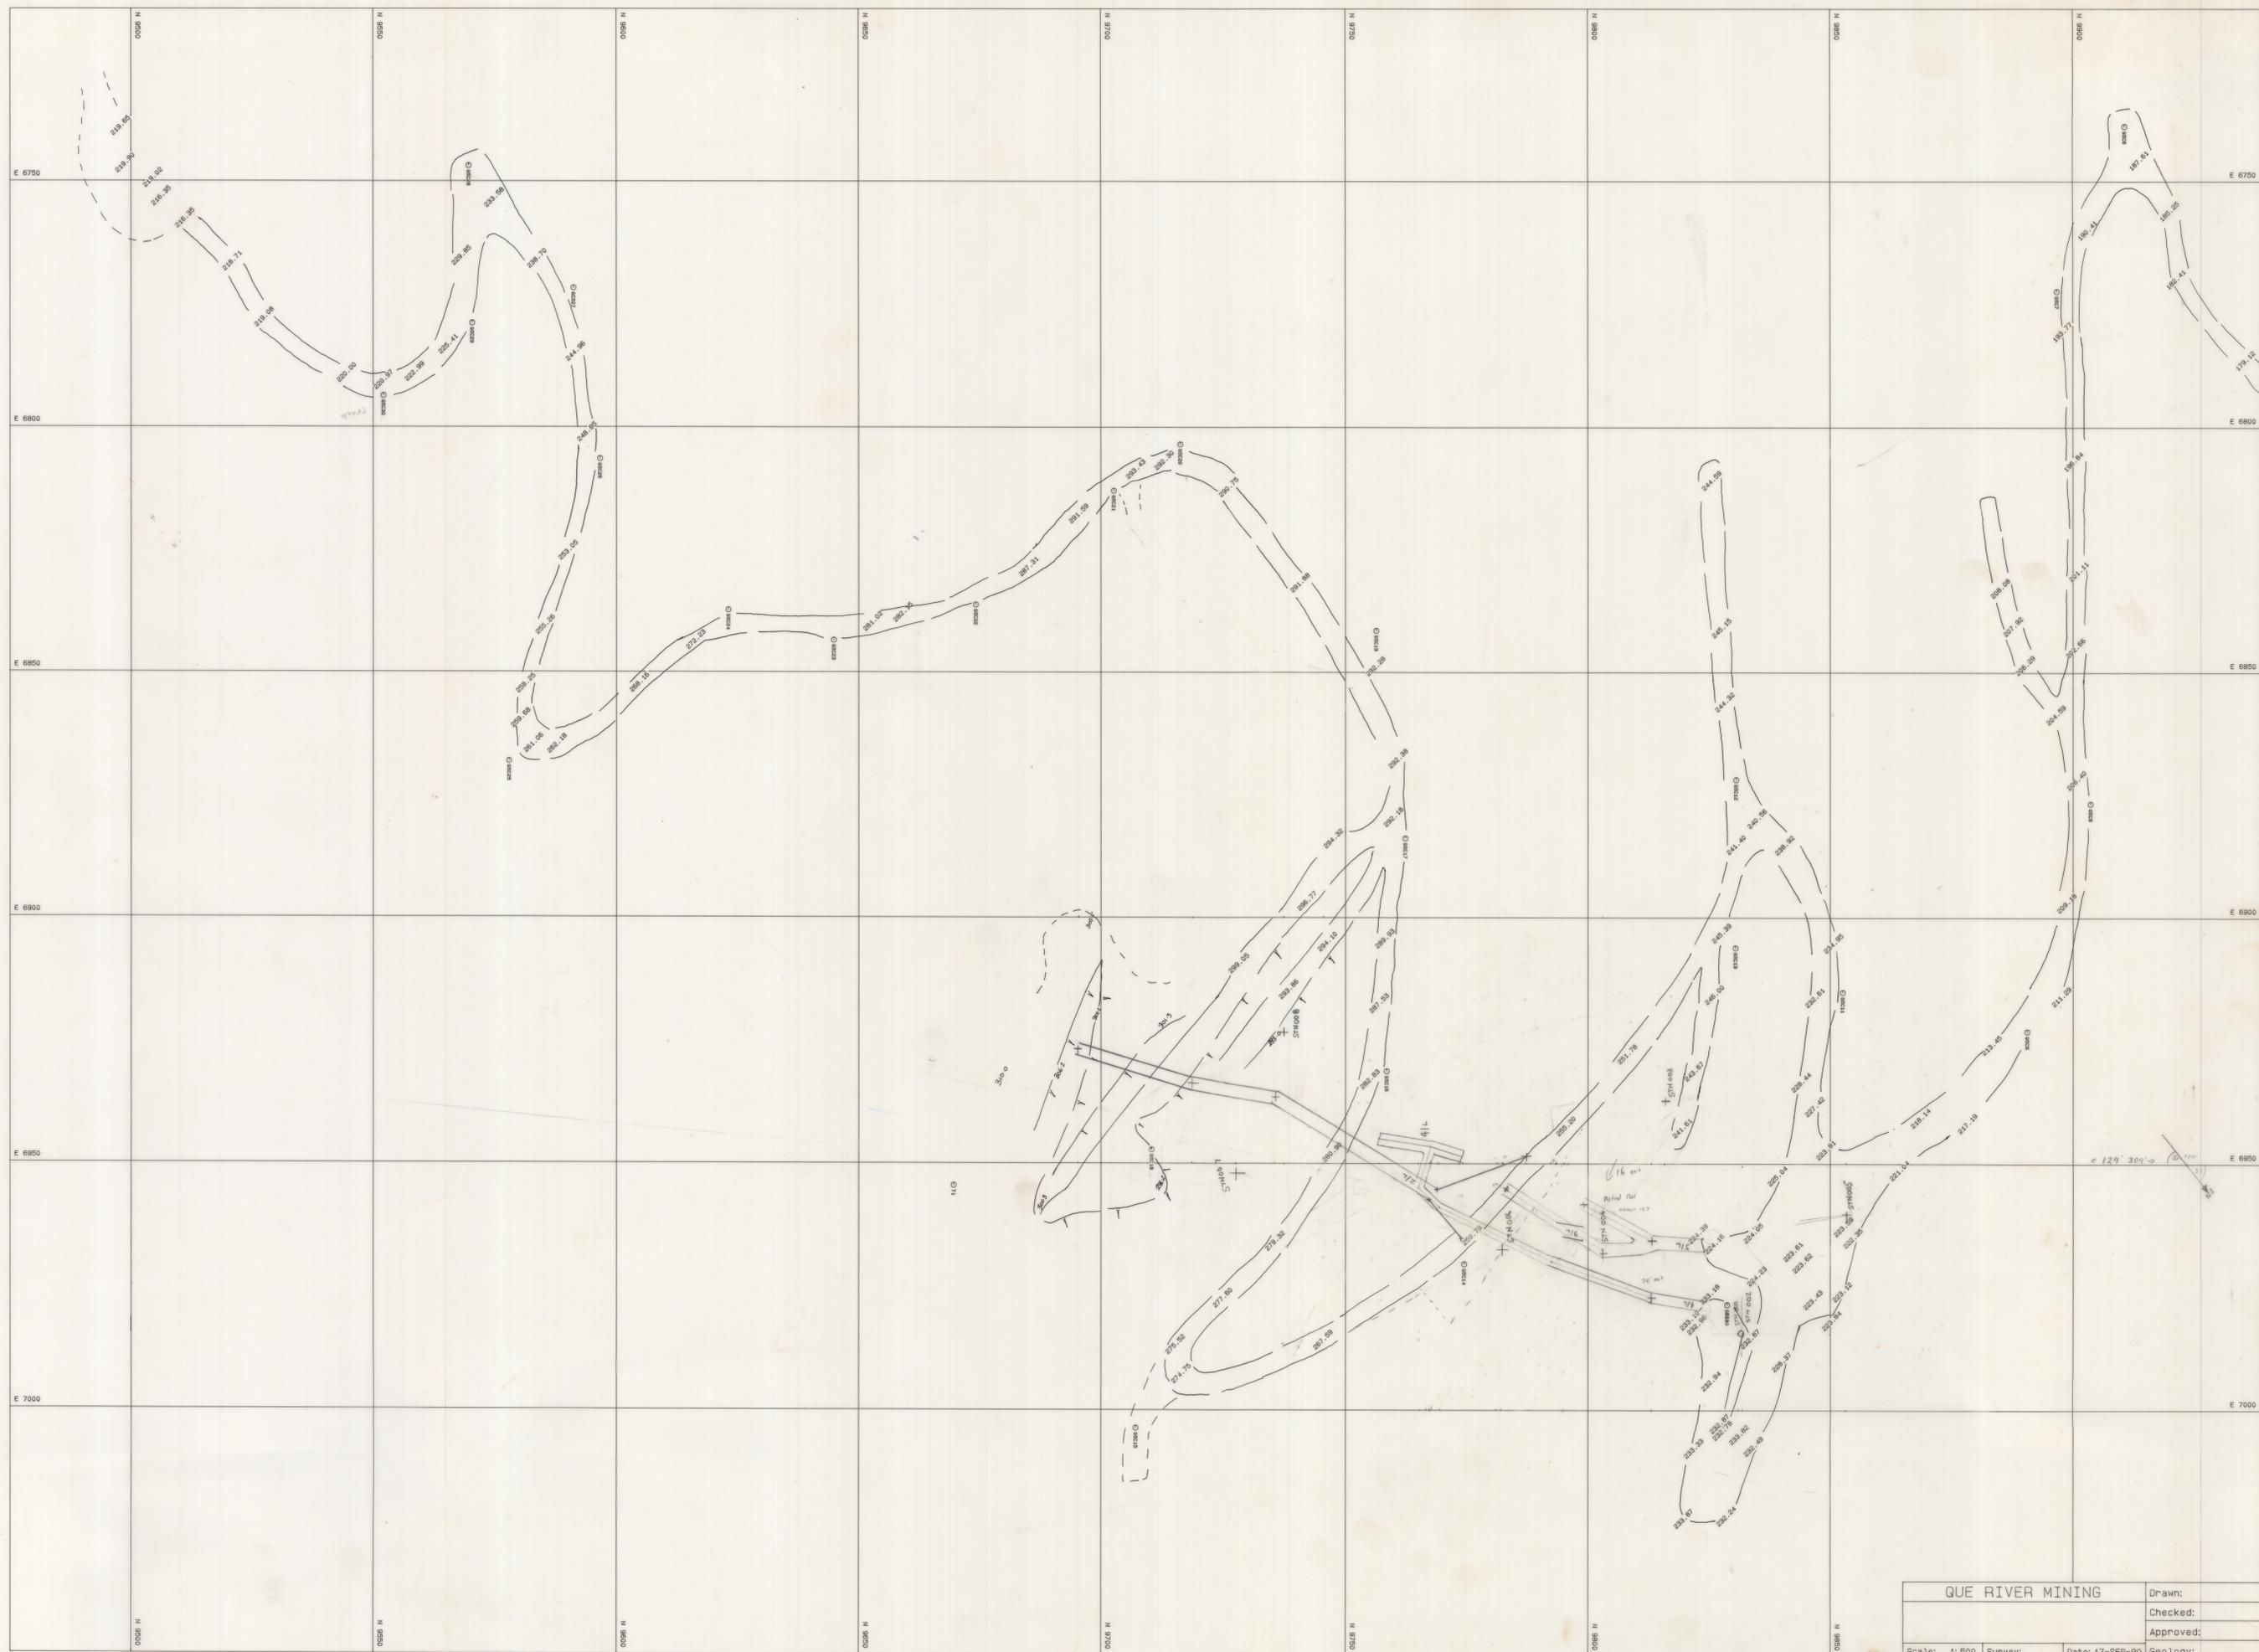

QUE RIVER MINING			
Scale: 1:500	Survey:	Date: 17-SEP-90	Geology:
Checked:		Drawn:	
Approved:			