


Surface 1:500  
8 Level Area

015A-050

5 cm

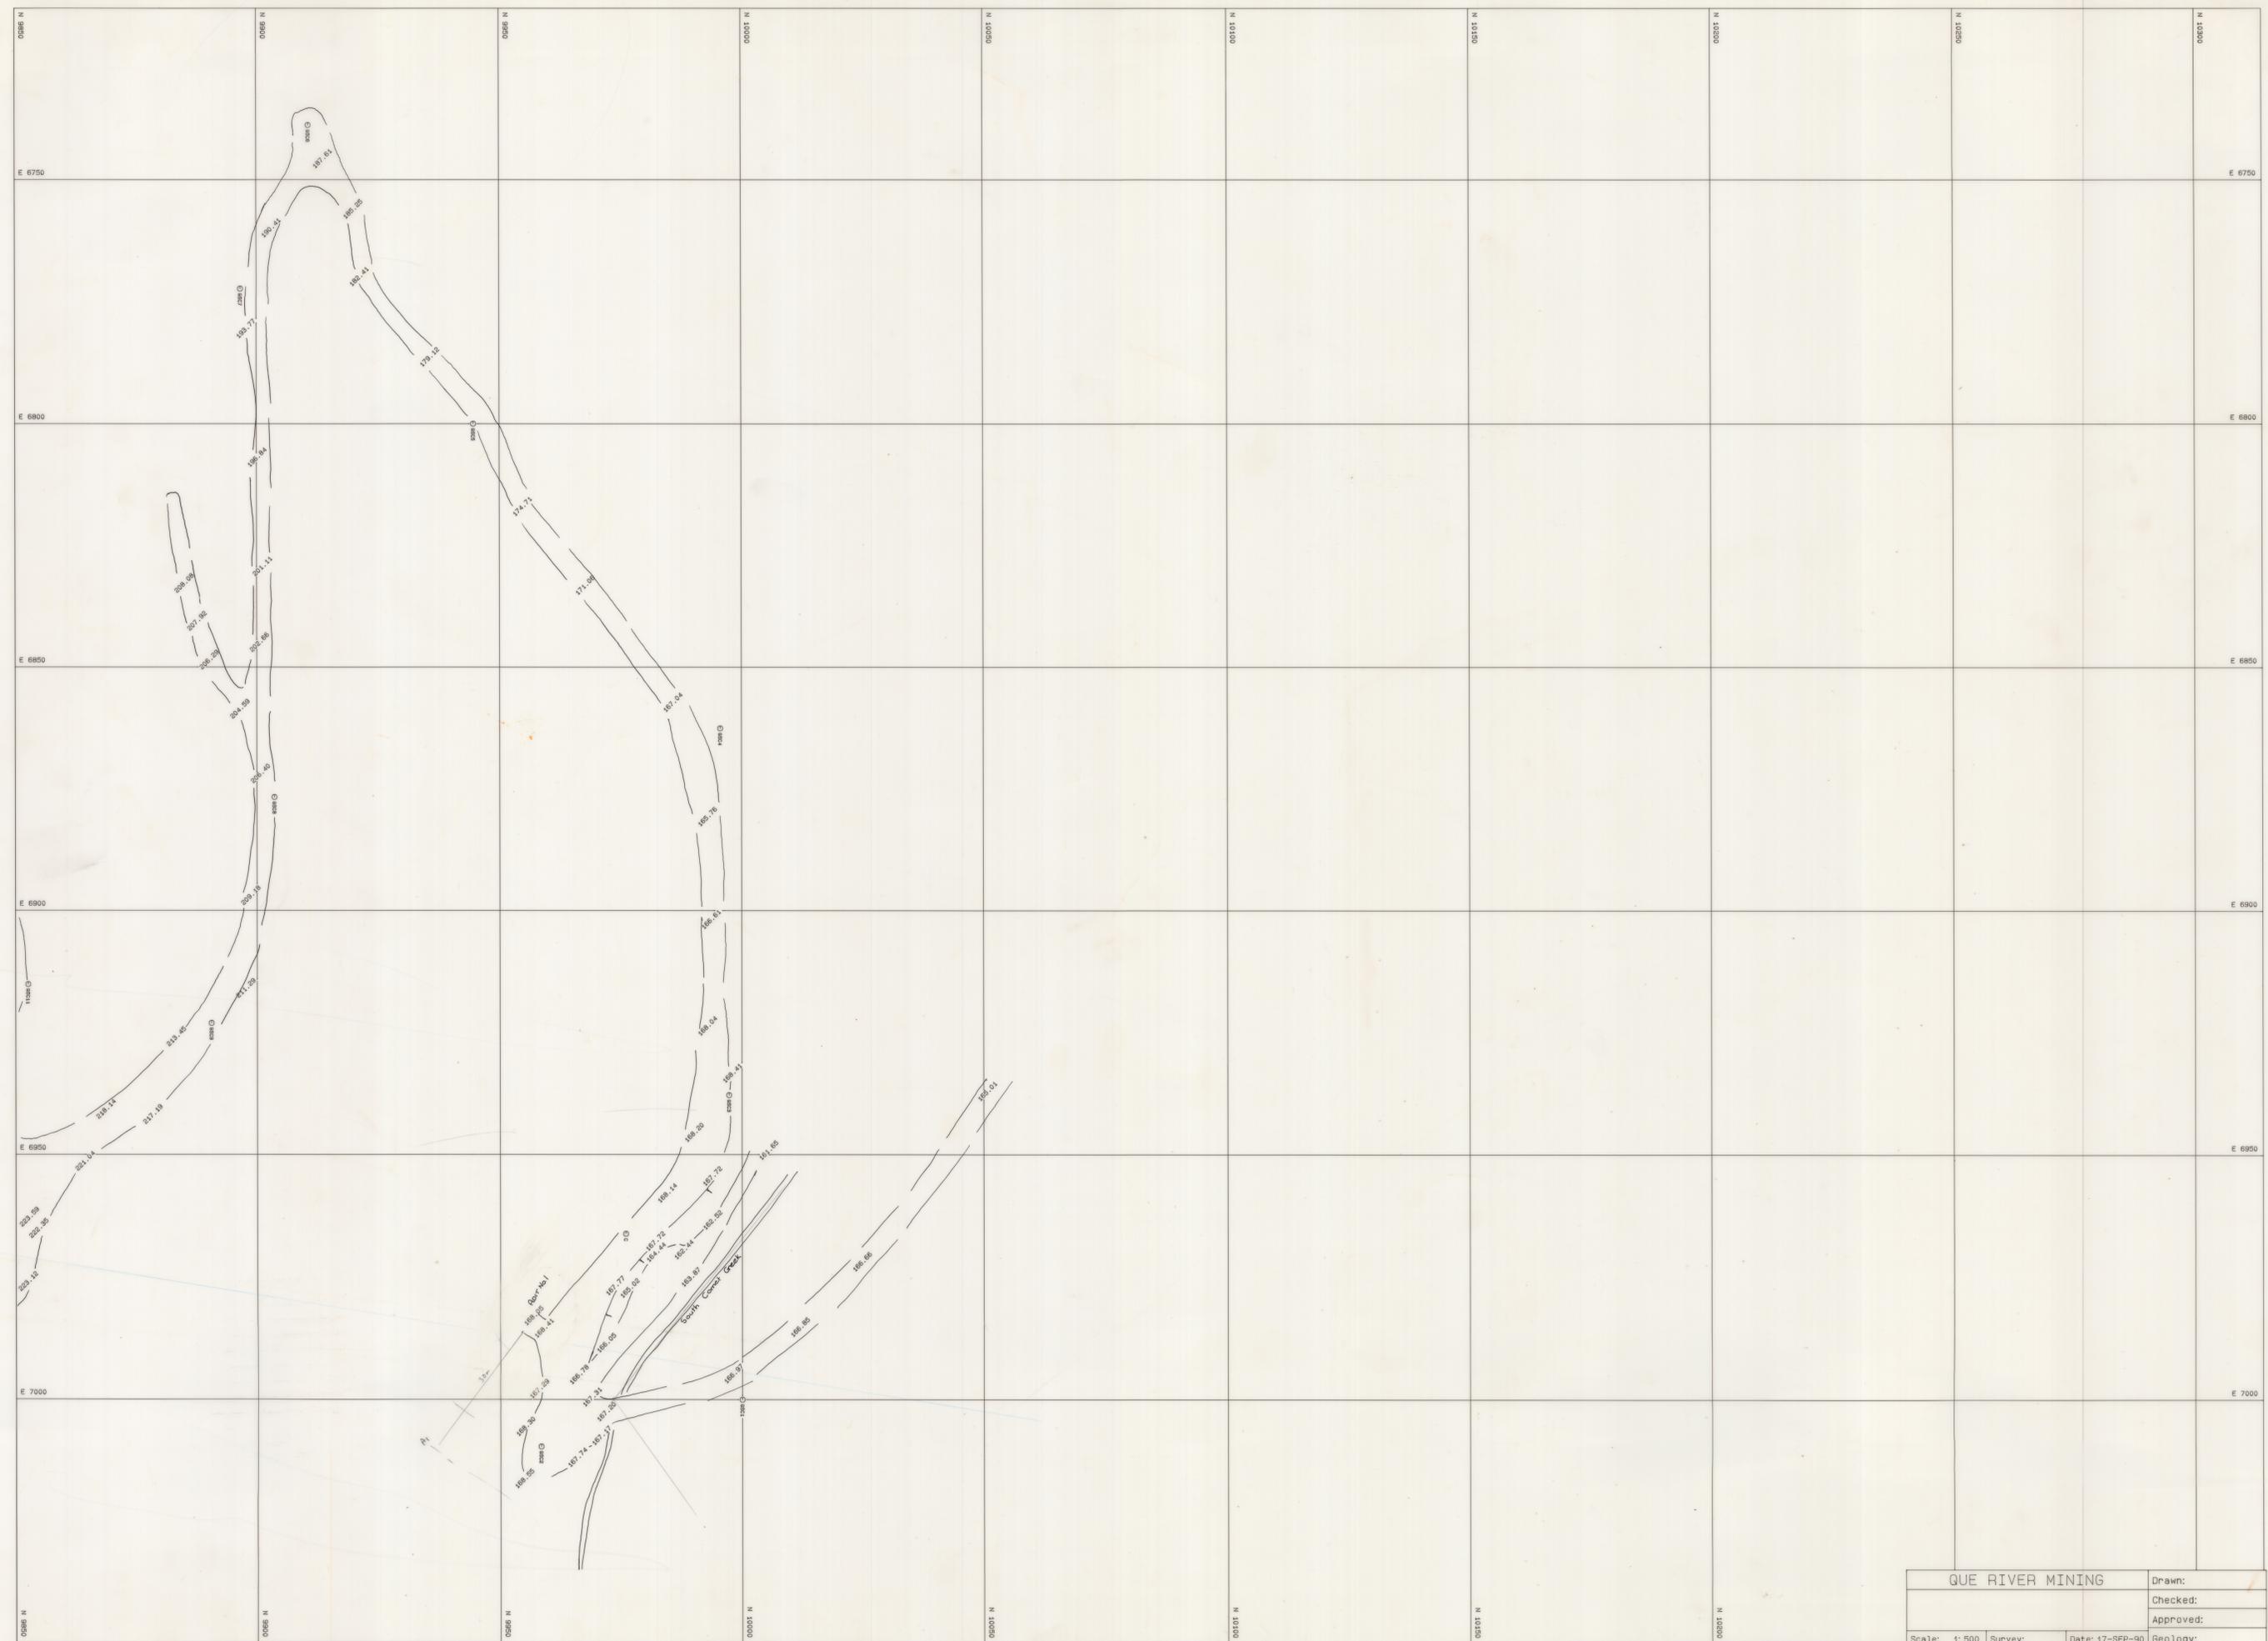

QUE RIVER MINING		Drawn:
		Checked:
		Approved:
Scale: 1:500	Survey:	Date: 17-SEP-90
		Geology:

148-10