


X Section
1:250

0154-052
5 cm

2

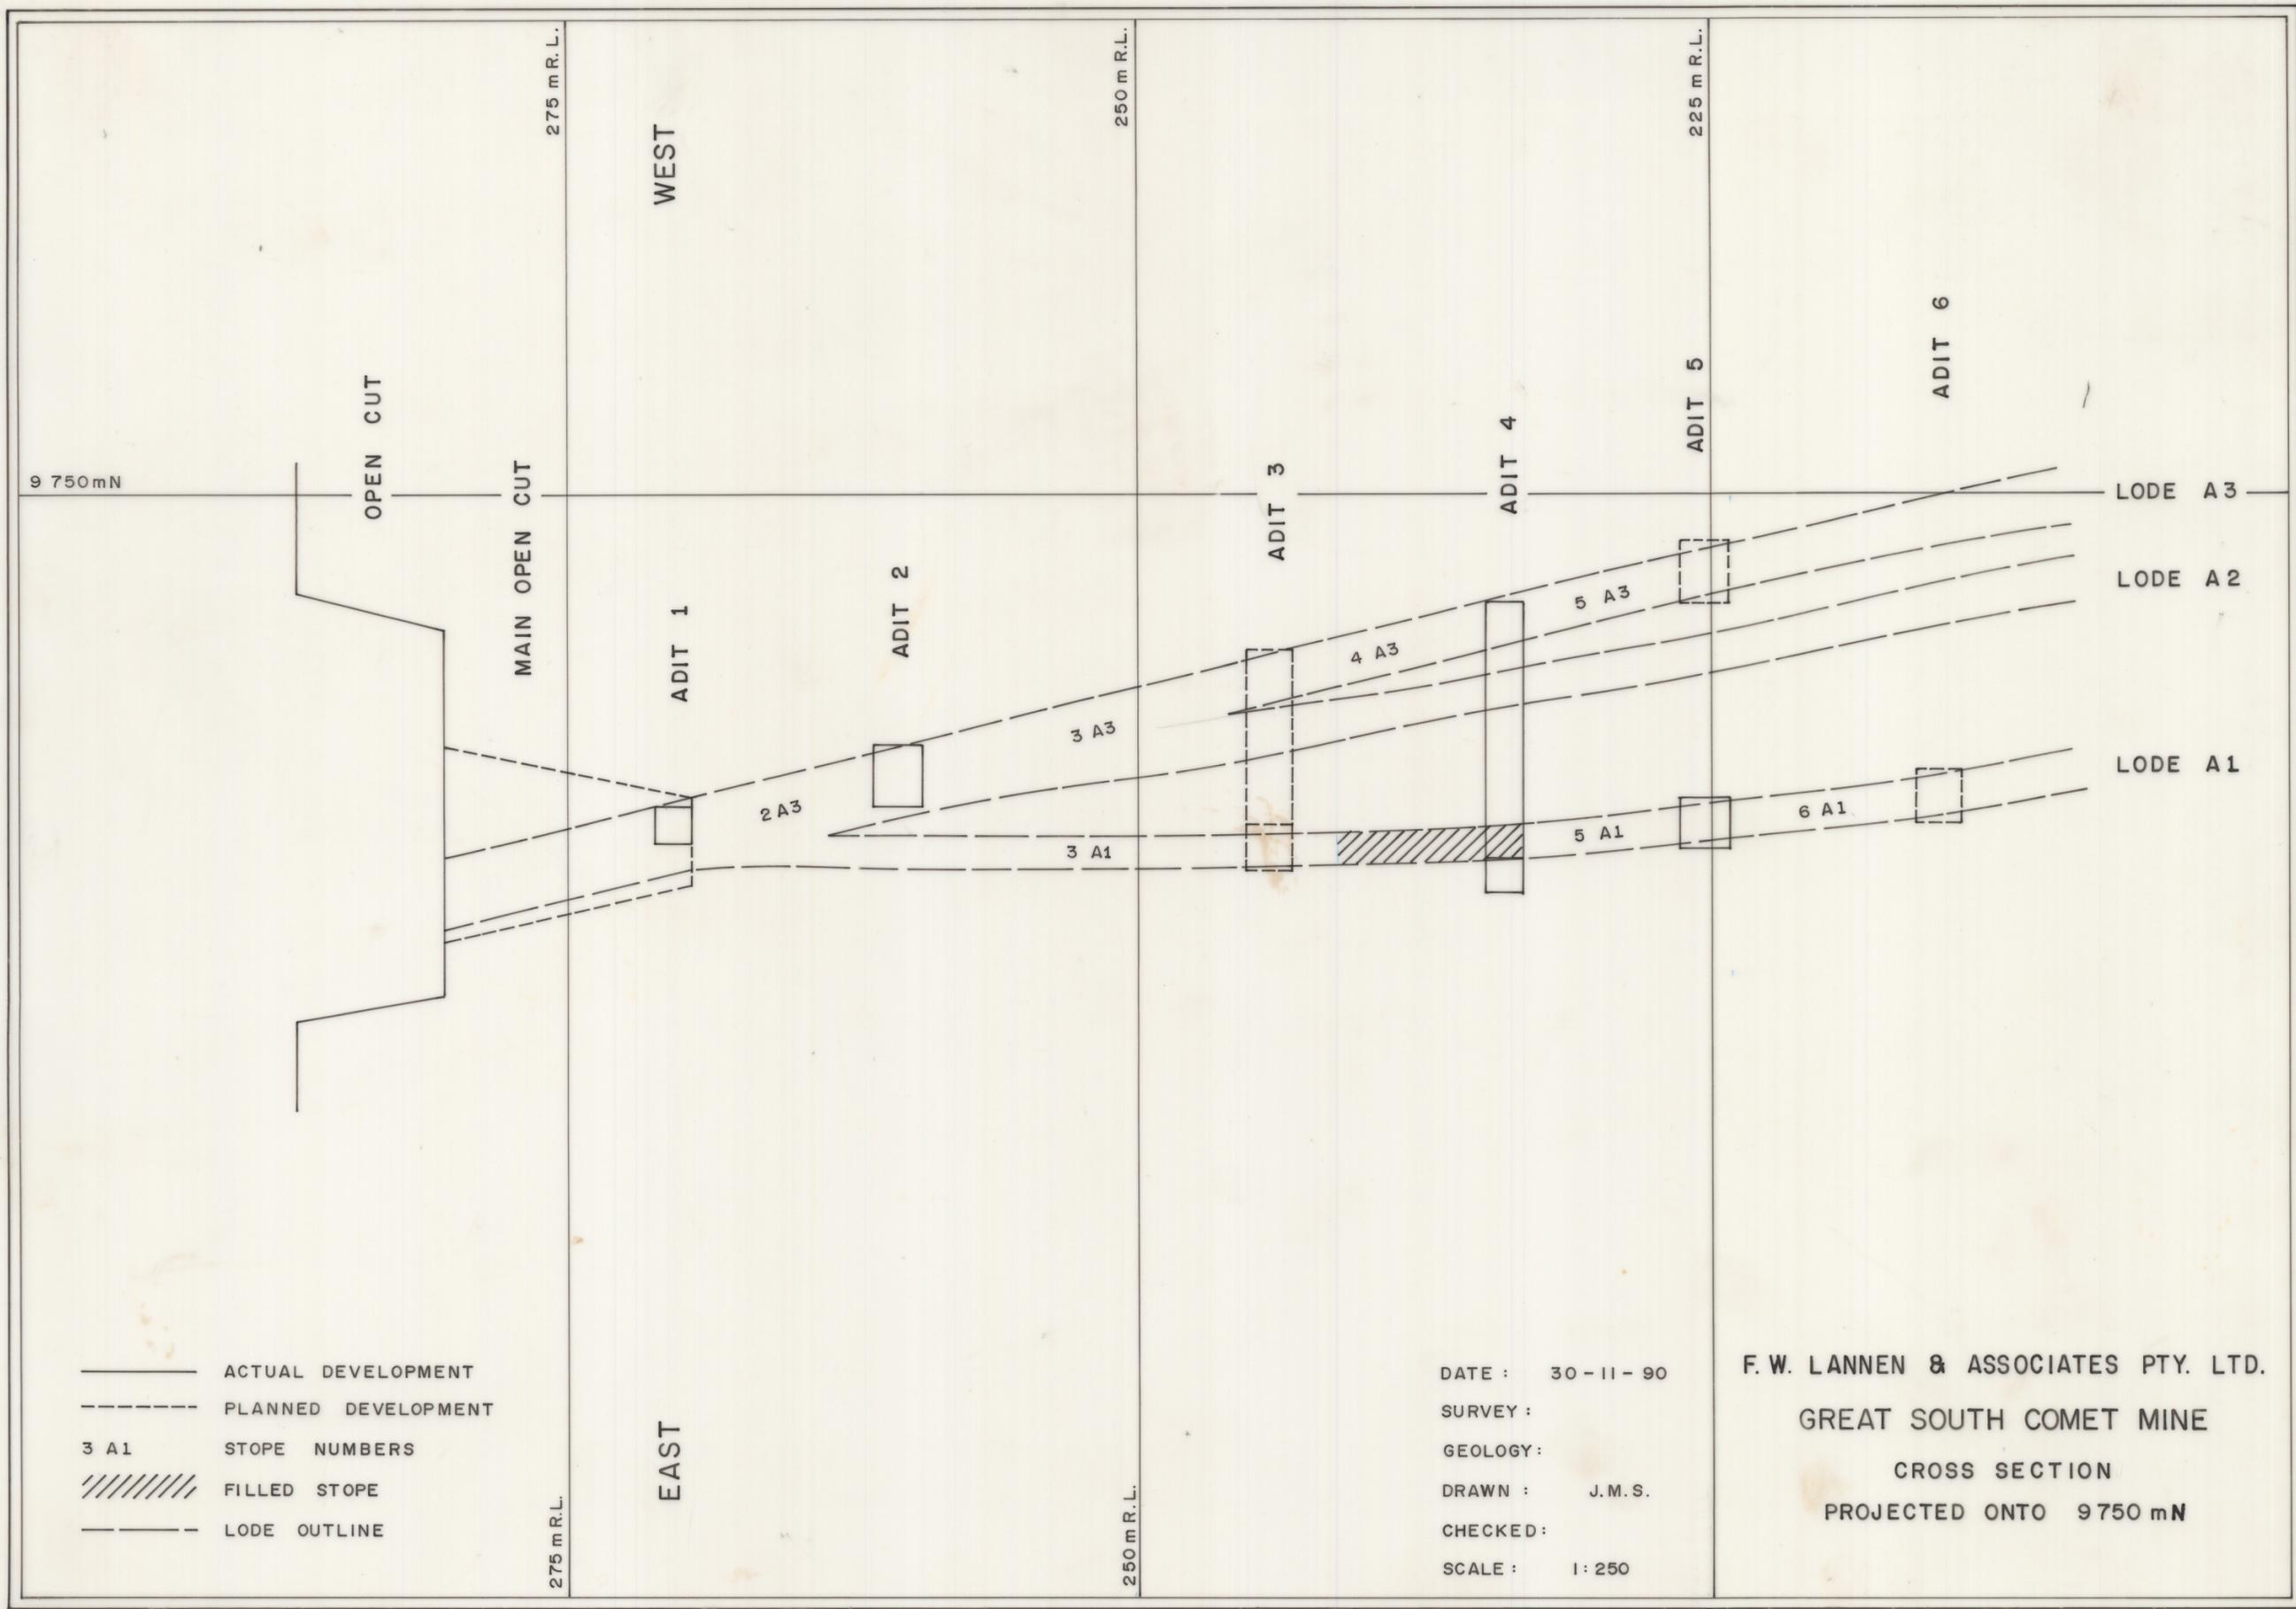

— ACTUAL DEVELOPMENT
- - - PLANNED DEVELOPMENT
3 A1 STOPE NUMBERS
//// FILLED STOPE
- - - LODE OUTLINE

DATE : 30-11-90
SURVEY :
GEOLOGY :
DRAWN : J.M.S.
CHECKED :
SCALE : 1:250

F.W. LANNEN & ASSOCIATES PTY. LTD.
GREAT SOUTH COMET MINE
CROSS SECTION
PROJECTED ONTO 9750 mN