


1888 Mt Zeehan Tasmania

155-01

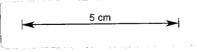


NE

PLAN MOUNT ZEEHAN BRITISH

BLOCK 3

SCALE 30 FEET TO 1 INCH.

TAS

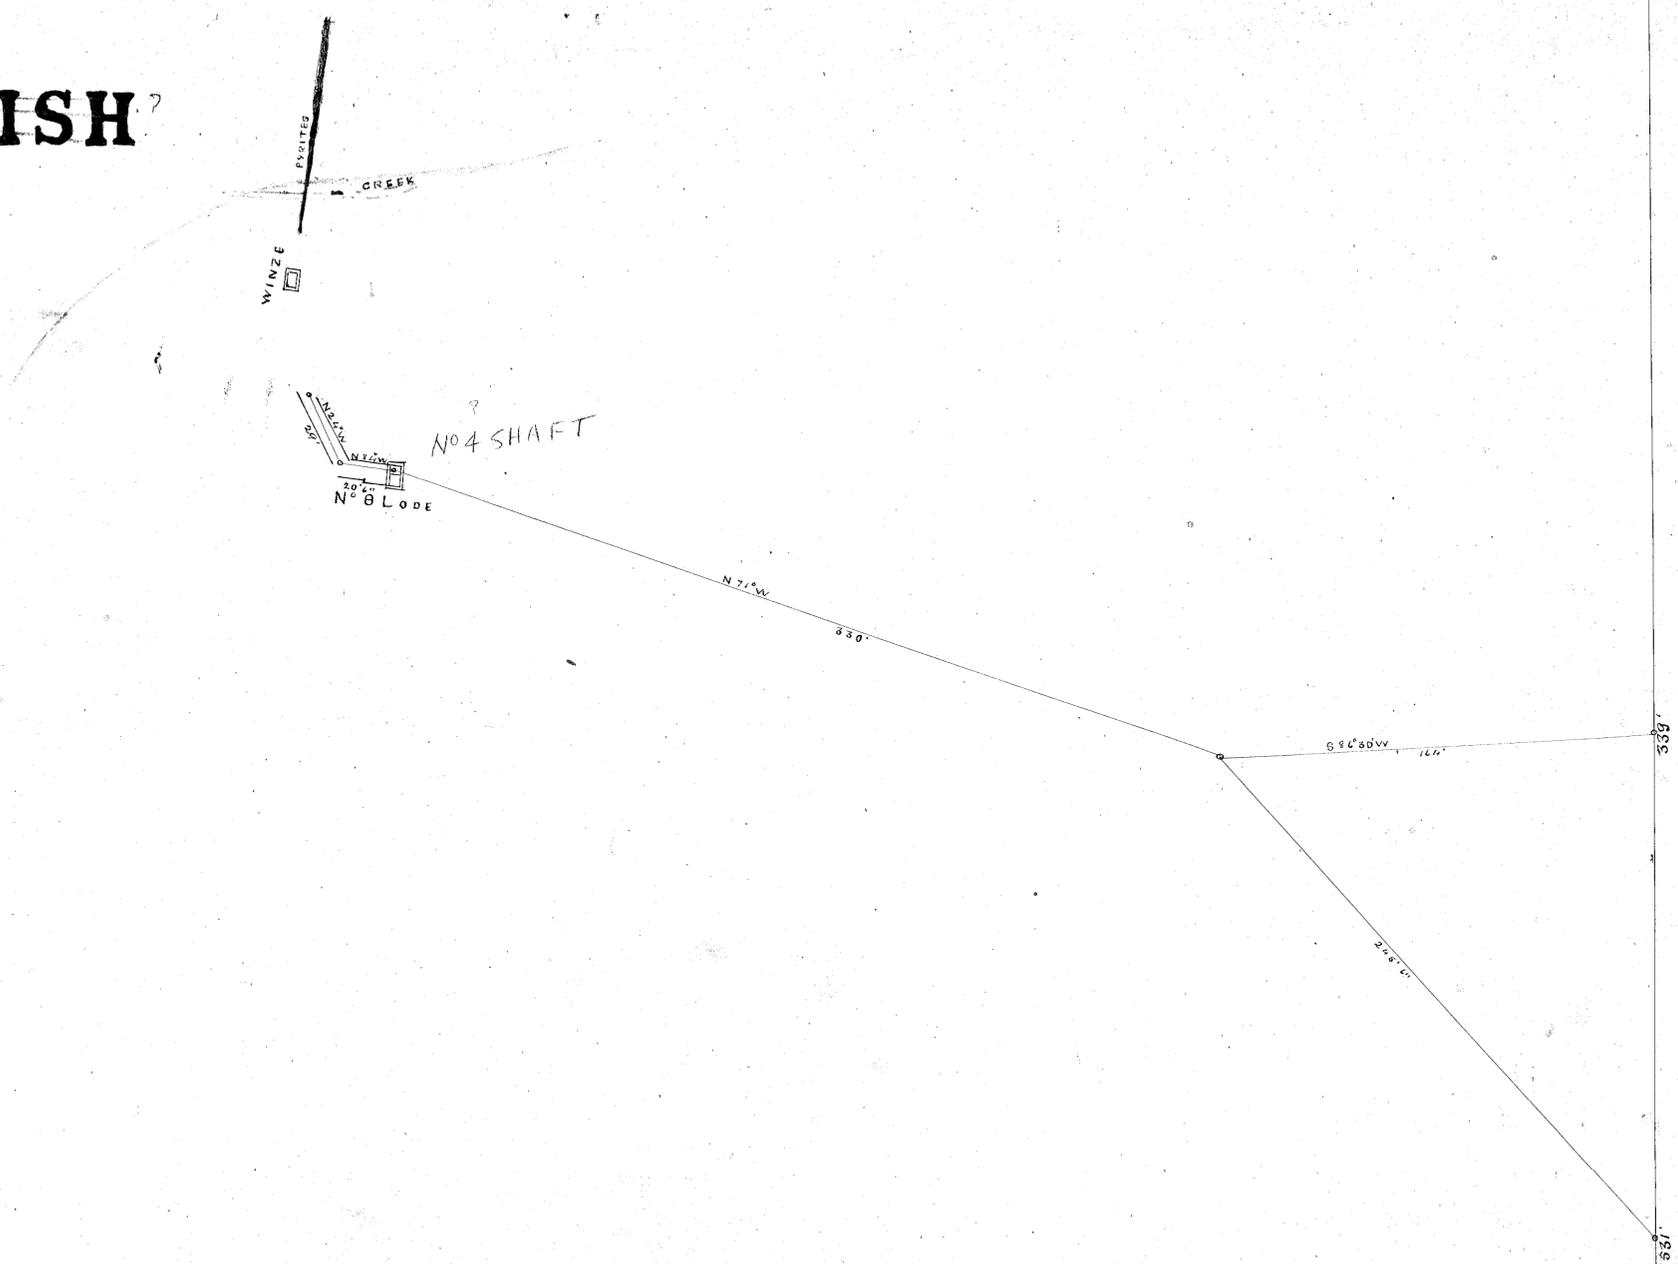

T. Vincent 4/4/98

5

12