

THE M^r. ZEEHAN (TAS). S. L. MINES, L^d.




GENERAL PLAN.

SCALE—2 CHAINS TO 1 INCH



DIAGRAM
OF
HEIGHTS OF SHAFT COLLARS AND DEPTHS OF LEVELS
SCALE—60 FEET TO 1 INCH

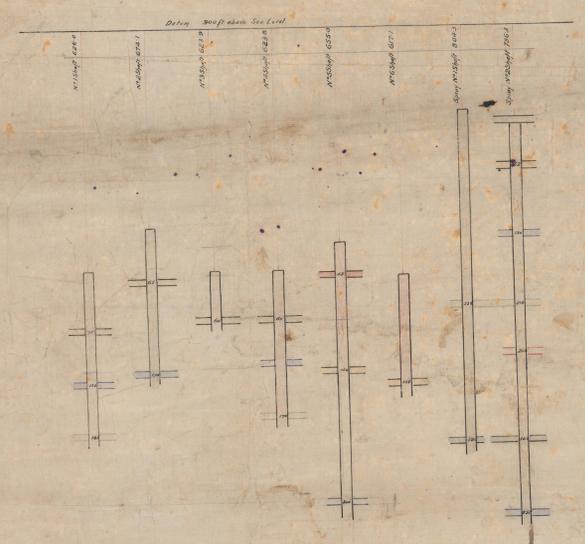

195