



155-02
TOO LARGE

155-03

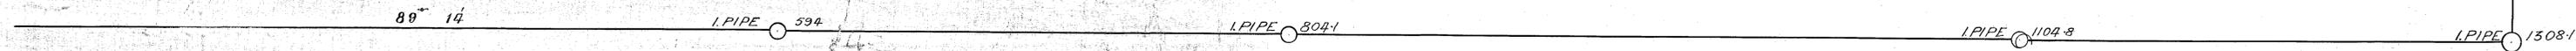

L.P.I.P.E. 77-2

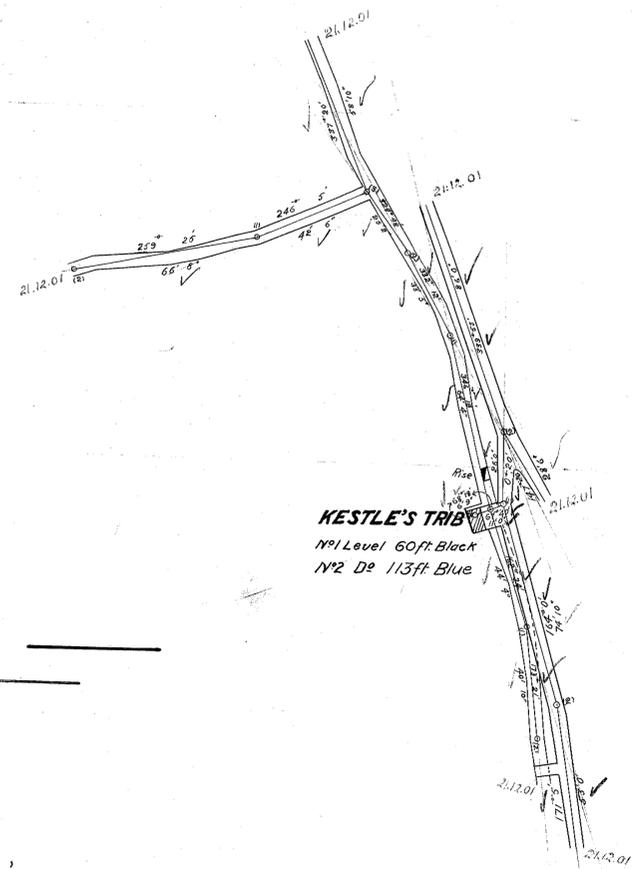

180° 25

L.P.I.P.E. 1402-2

L.P.I.P.E. 530 89° 58

MOUNT ZEEHAN (TAS) S. L. MINES LTD.

BALSTRUP'S SECTION 1209/M

SCALE—30 FEET TO 1 INCH

MANAGER *[Signature]*



Handwritten notes at the bottom right corner, including 'Kestle's trib', 'Nº1 Level 60ft Black', and 'Nº2 Dº 113ft Blue'.