



Longitudinal Section

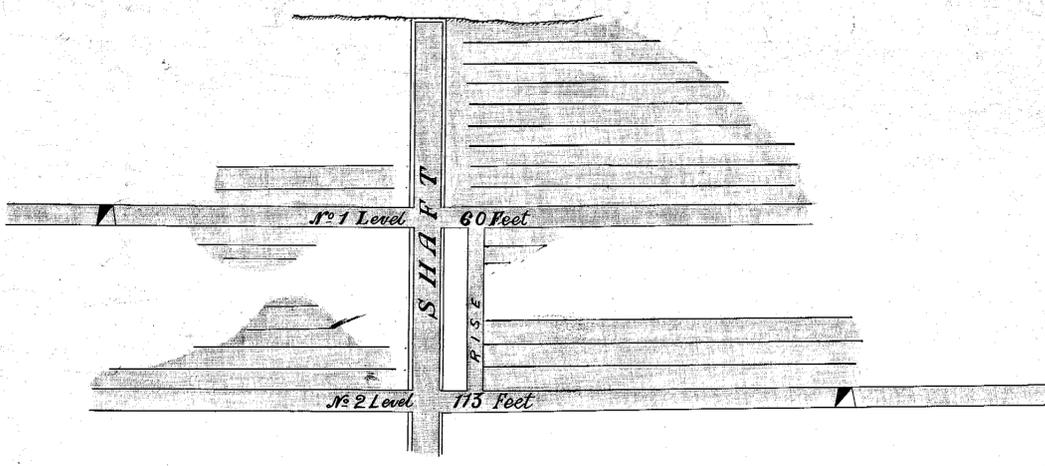

Cross Section

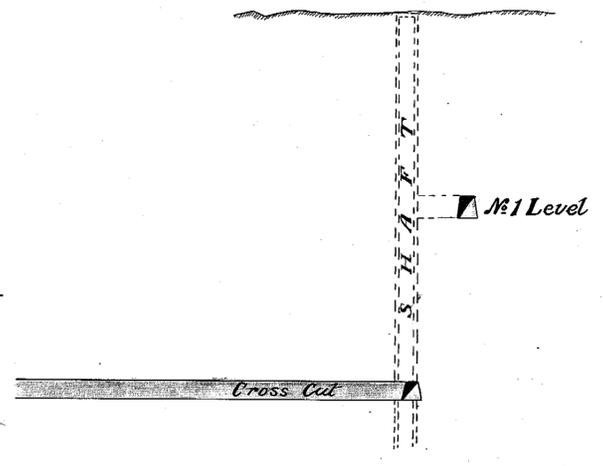

THE M<sup>r</sup> ZEEHAN (TAS) S. L. MINES LTD

**KESTLE'S TRIBUTE WORKINGS**

BALSTRUP'S SECTION <sup>1269</sup>/<sub>M</sub>

SCALE 30 FT TO 1 INCH

MANAGER

*[Signature]*

2/12/01

