


1891  
155-05  
SILVER QUEEN EXT.  
155-05



155-05

— PLAN —  
OF  
— UNDERGROUND WORKS —  
— LEECHAN (TAS) SILVER LEAD MINES —  
— (SILVER QUEEN EXTENDED) —  
*Scale 50 feet to one inch*

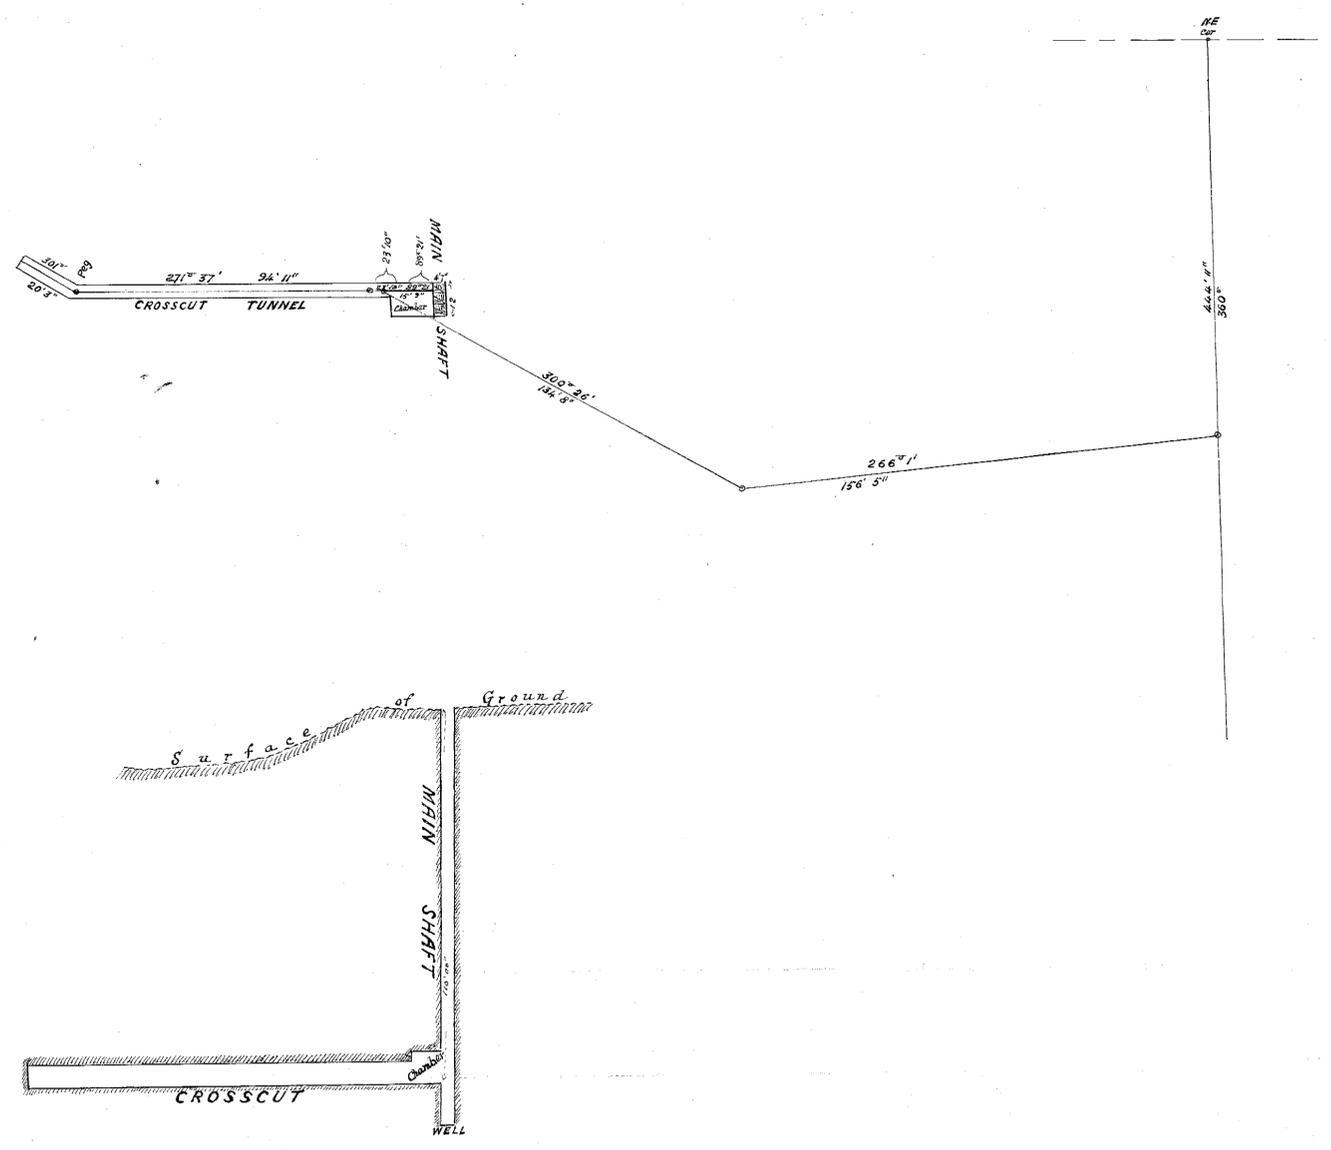

*Chas. Lorez  
Capt Surveyor  
Mt Zeehan  
January 1891*

10

10