



155-06  
155-06

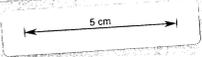

# ARGENT SECTION N° 5.

N°2 SHAFT

== SCALE ==  
== 30 FEET TO ONE INCH ==

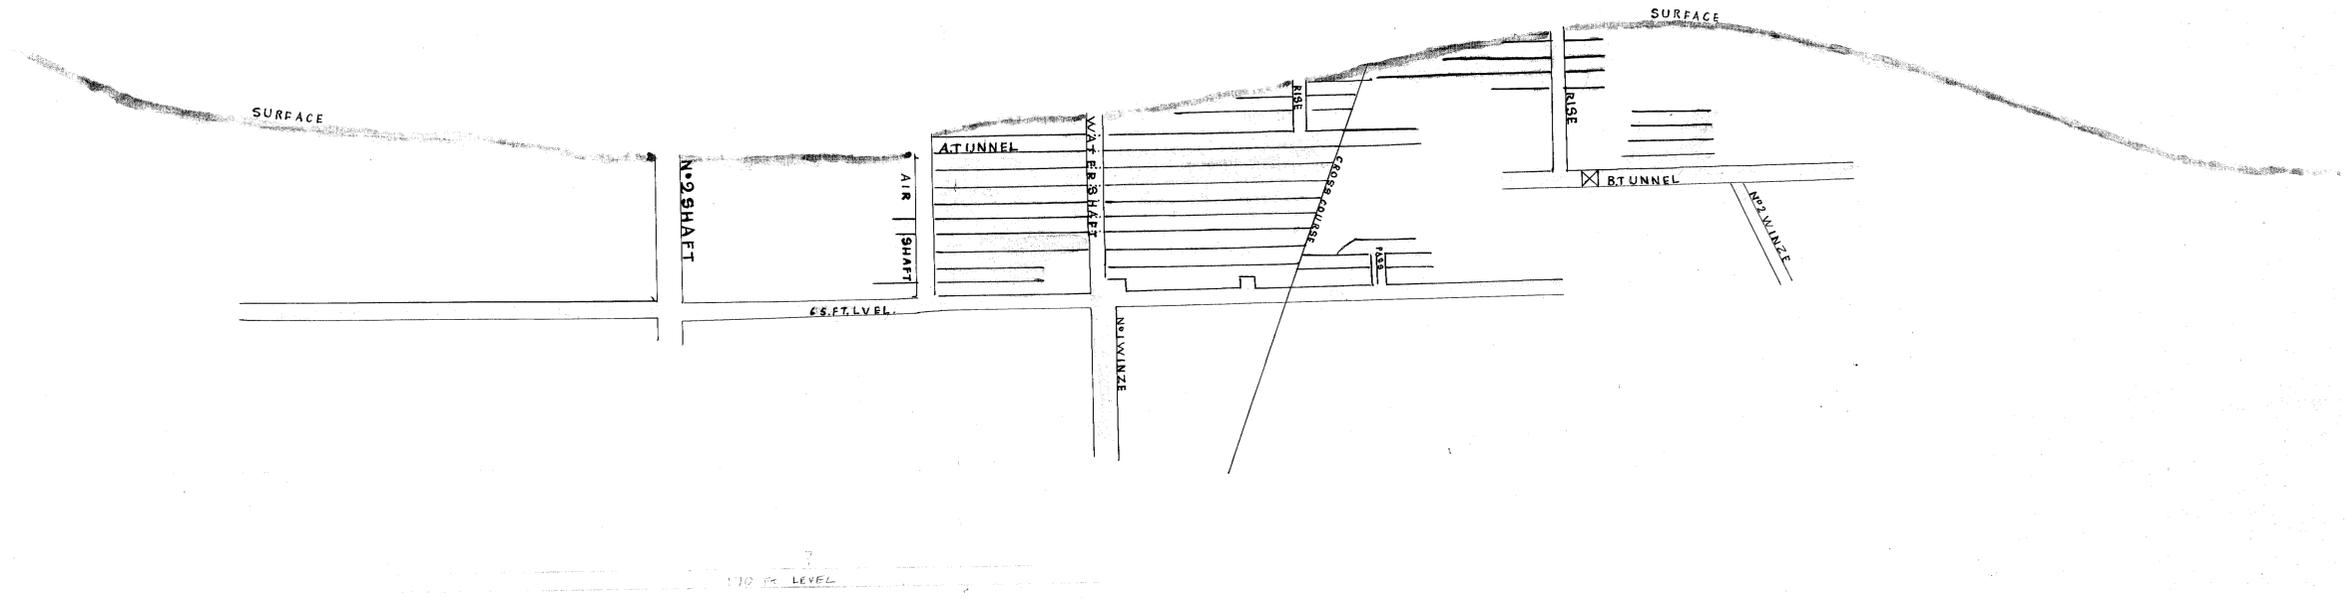

- ▬ TRIBUTORS WORK 1895-1896
- ▬ COMPANYS WORK 1897

7  
27/1/98