

THE MOUNT ZEEHAN
(TAS.) SILVER LEAD MINES LIM^d

ARGENT SECTION N^o 2.

40 ACRES




SECTIONS OF UNDERGROUND WORKS.

SCALE 30 FEET TO 1 INCH.

INSTRUMENT USED: THEODOLITE

72 FEET LEVEL BLACK LINES

132 FEET LEVEL READ LINES

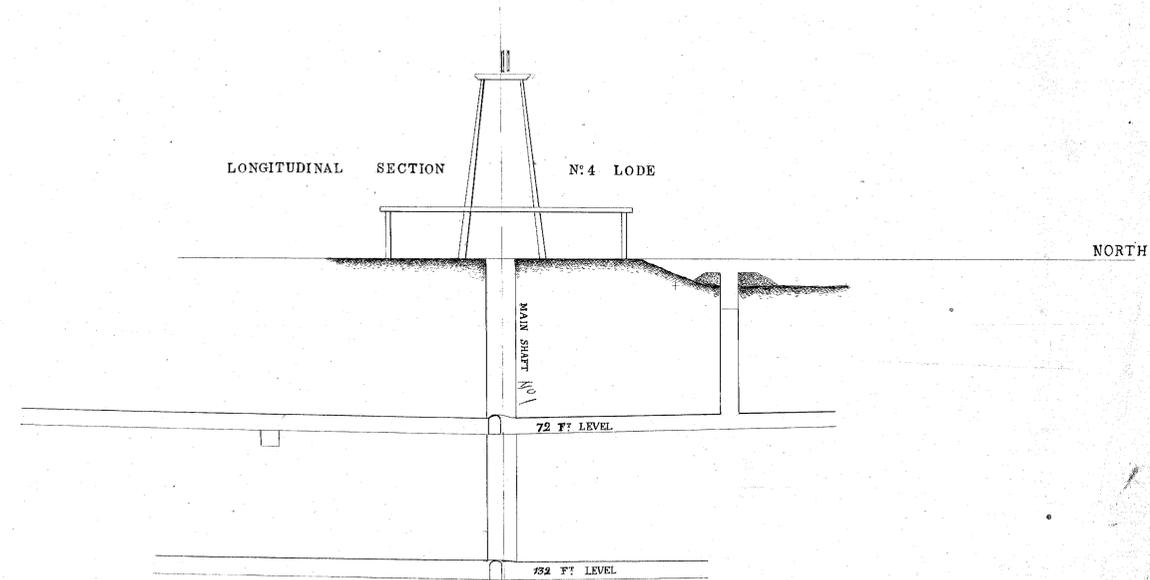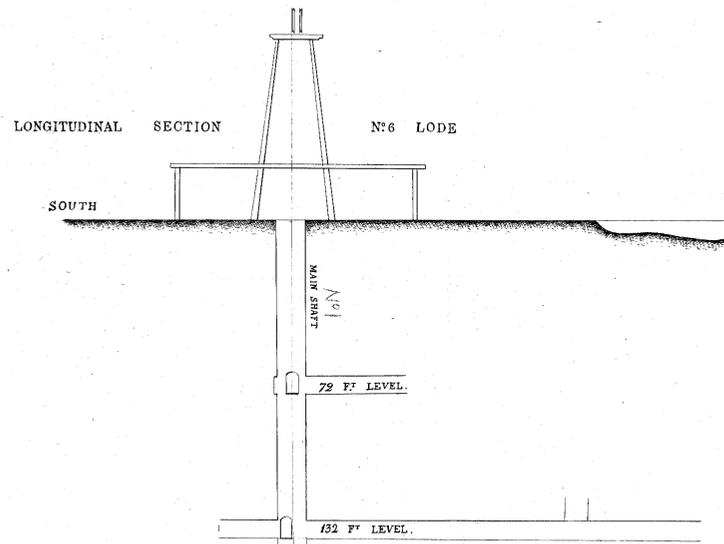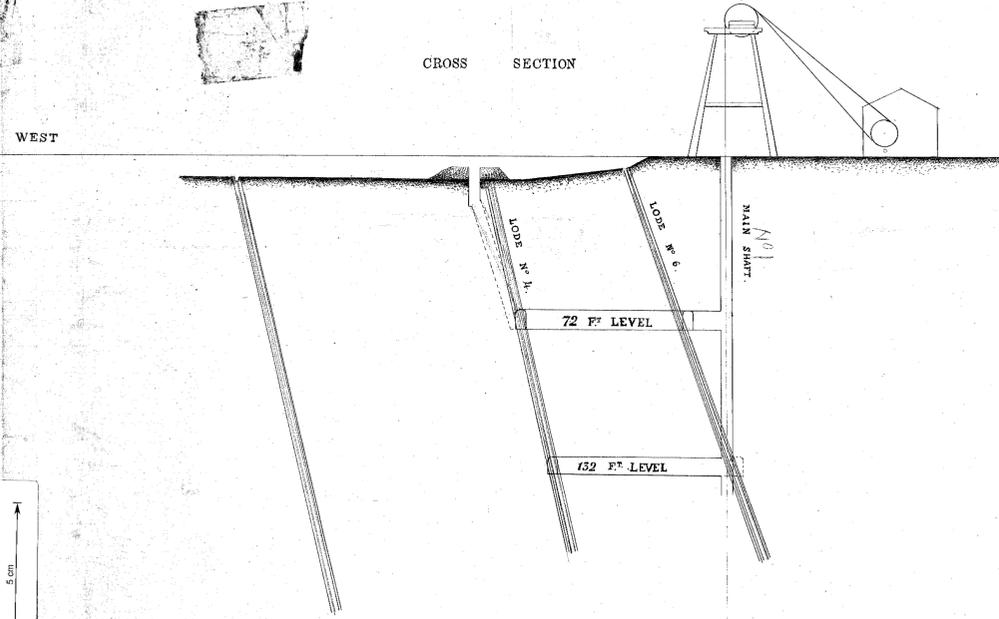

Henry Joy, M.C.
Surveyor

V. Vincent, Mining Manager
16th Feb 1898

1898