
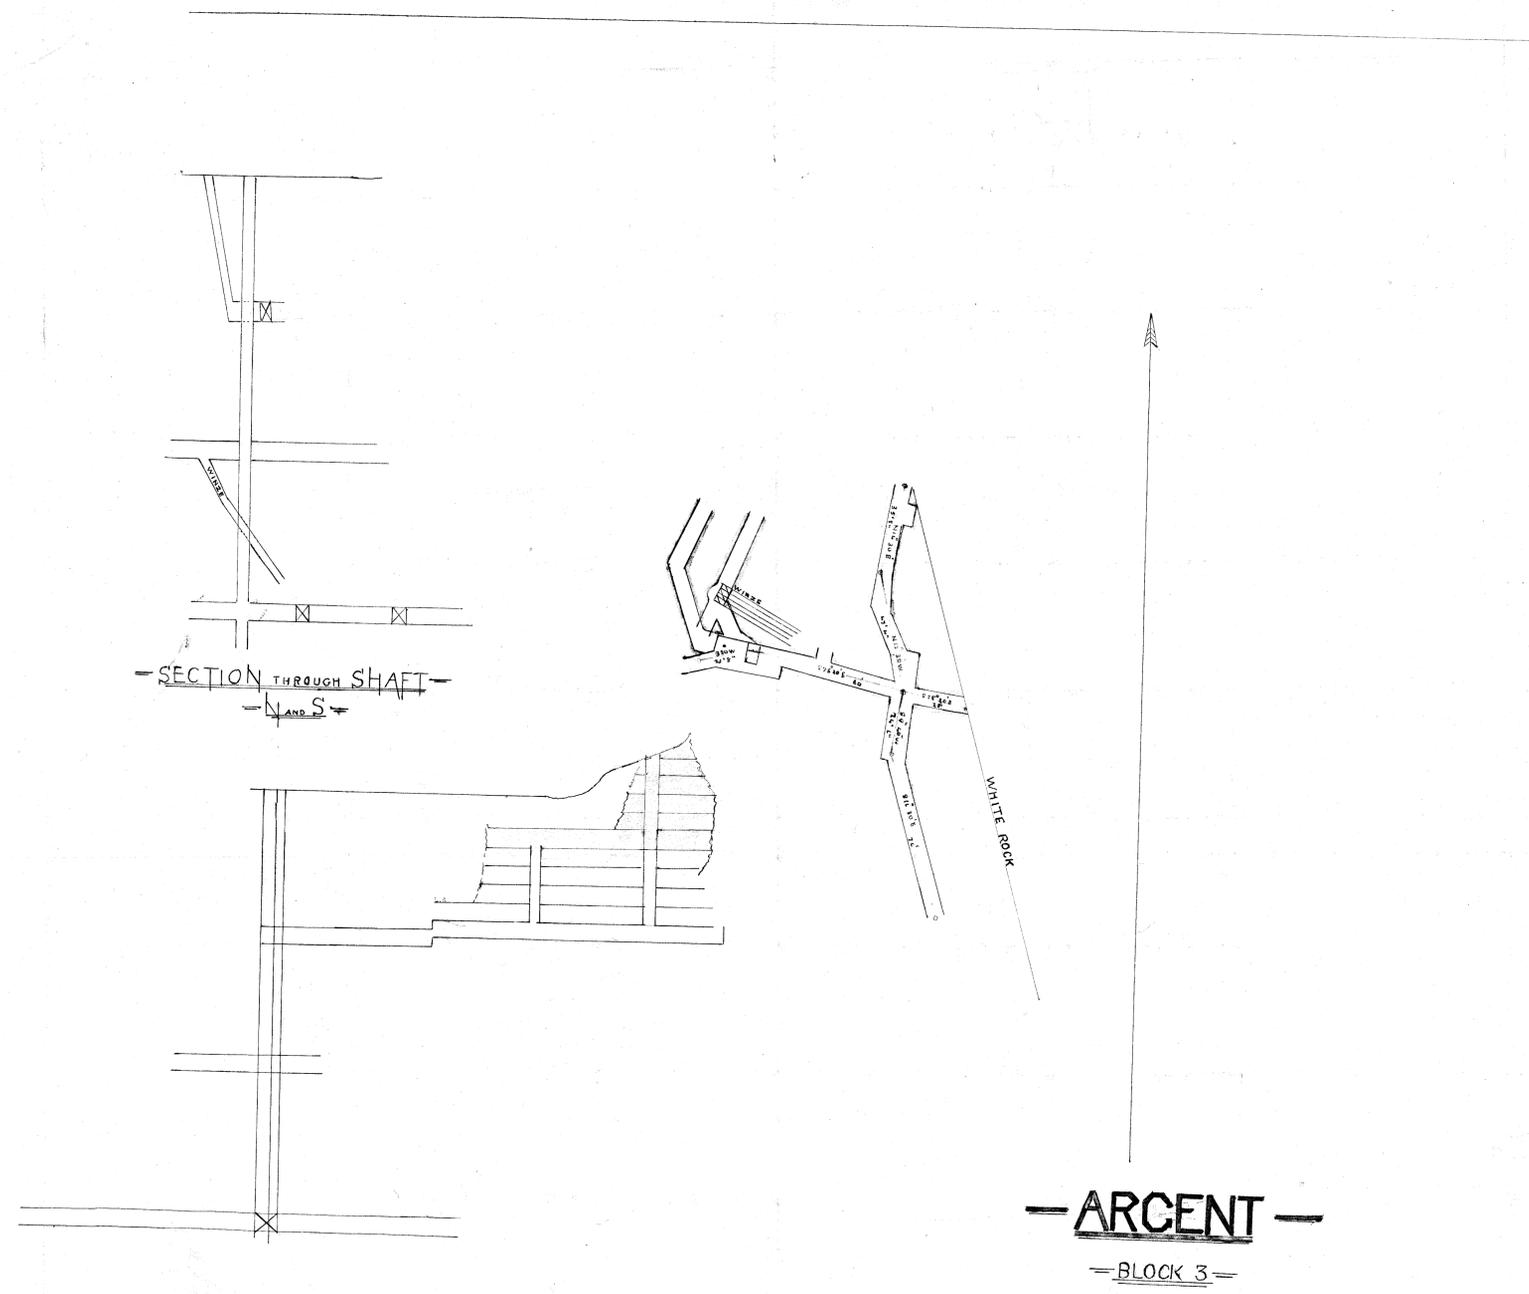


155-10

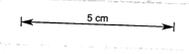

**— ARCENT —**

**— BLOCK 3 —**

**— No. 4 SHAFT No. 8 LODE —**

**— SCALE —**

**— 30 FEET TO ONE INCH —**

- No 1 Level 60 Ft
- No 2 Level 110 Ft
- No 3 Level 172 Ft

24/1/07

Surveyed 8th June 1897  
J. Vincent

M. S. Vincent & Co. Surveyors  
183, W. Beach Road, Singapore