


Mr. J. H. ...
1001
1001

1001
1001



155-11

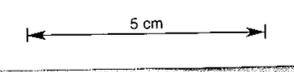

THE
MOUNT ZEEHAN (TAS) S. L. MINES LTD

ARCENT SECTION No 192
87M

BRAMPTON'S TRIBUTE No 6 ARCENT
Scale 30F to 1 in.

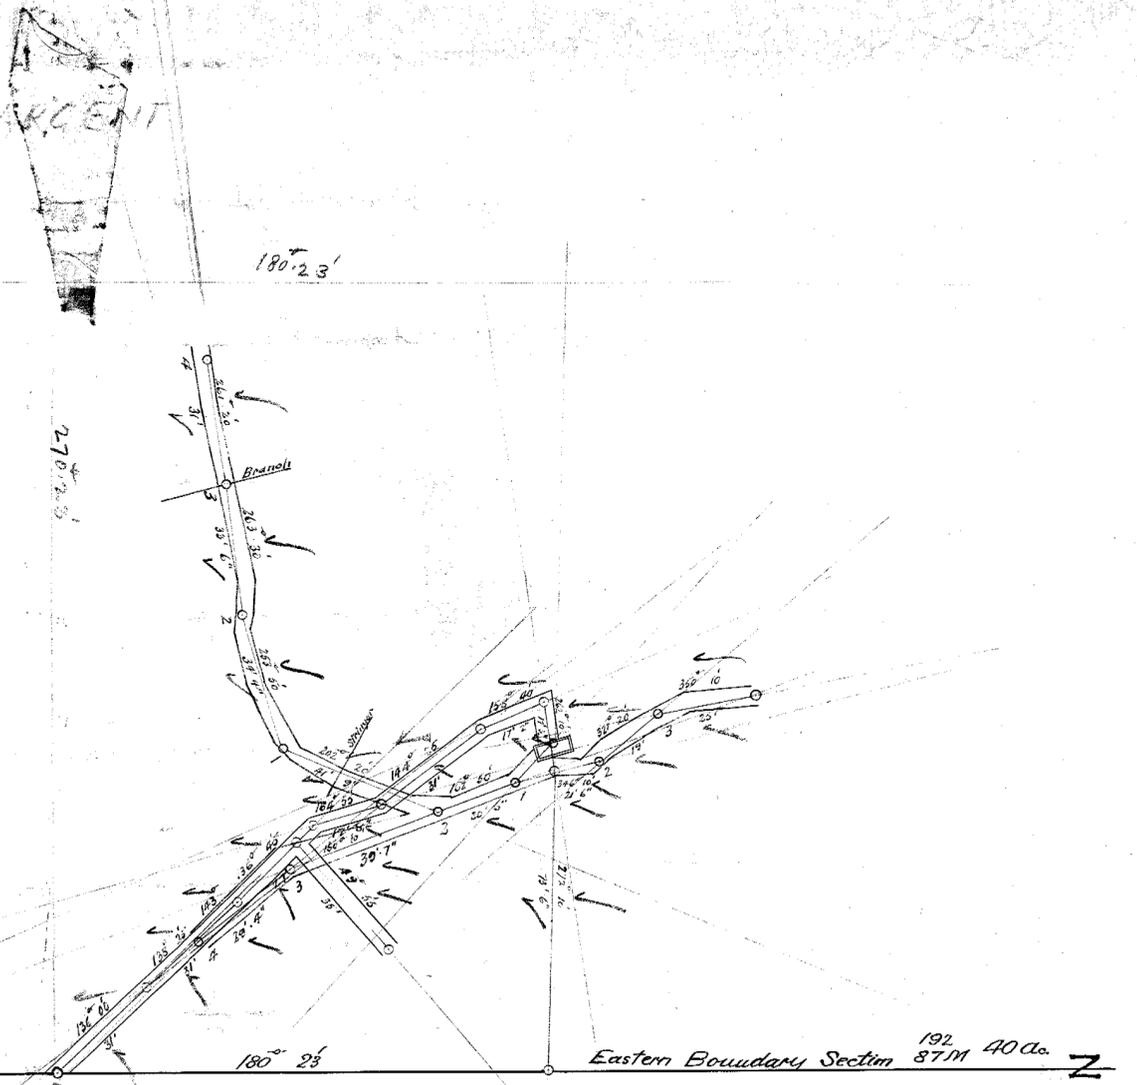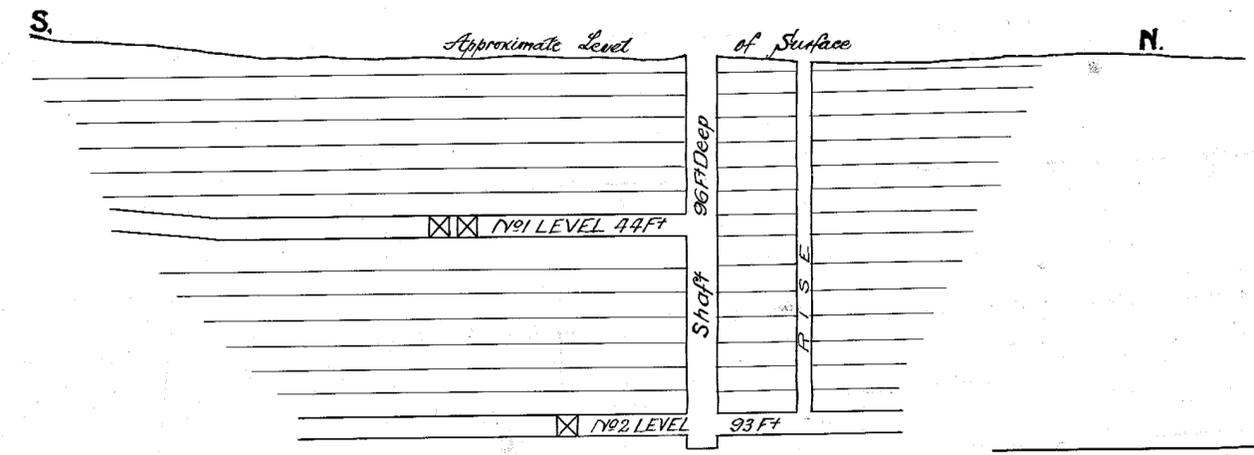

J. O'Connell
24/1/00
21/2/04
MANAGER