


155-12

5 cm

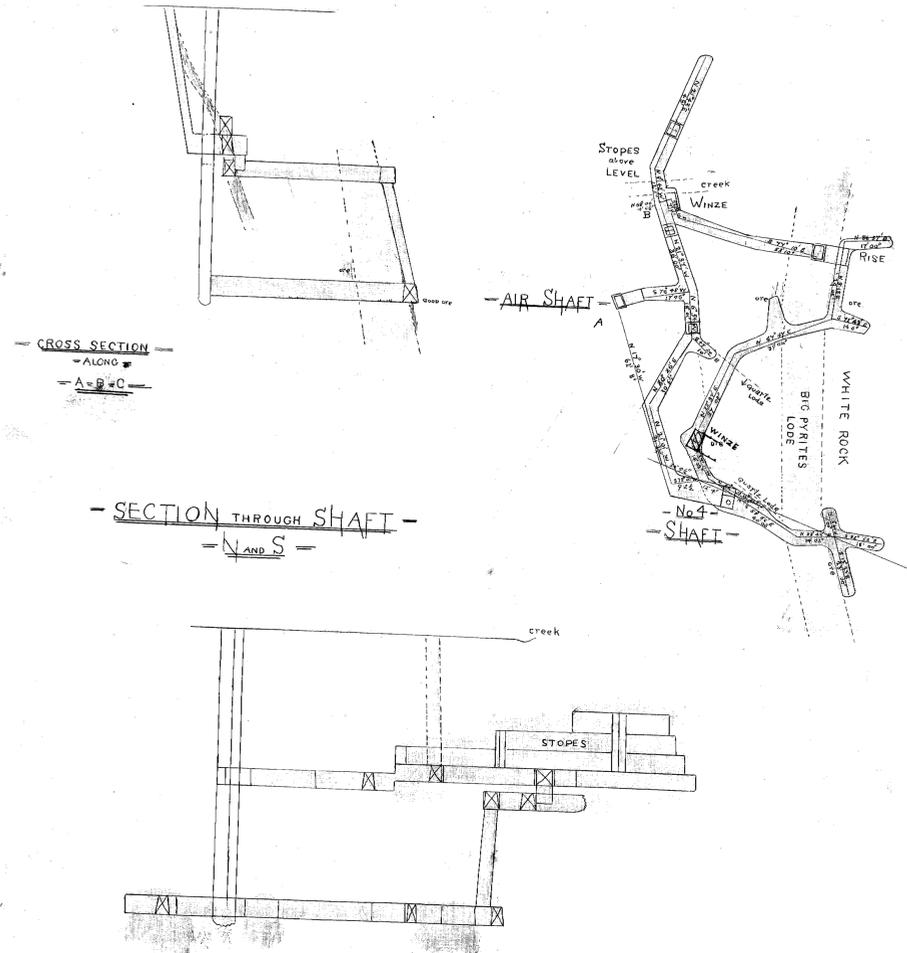

- No 1 Level 60 Ft
- Intermediate
- No 2 Level 110 Ft
- Galena

- ARCENT -

- BLOCK 3 -

- No 4 SHAFT No 8 LODE -

- SCALE -
- 30 FEET TO ONE INCH -

Surveyed Jan 14th 1896
E. M. Weston

912
1896

Peg No 1
339

Peg No 2
341

W. F. ...
1896