
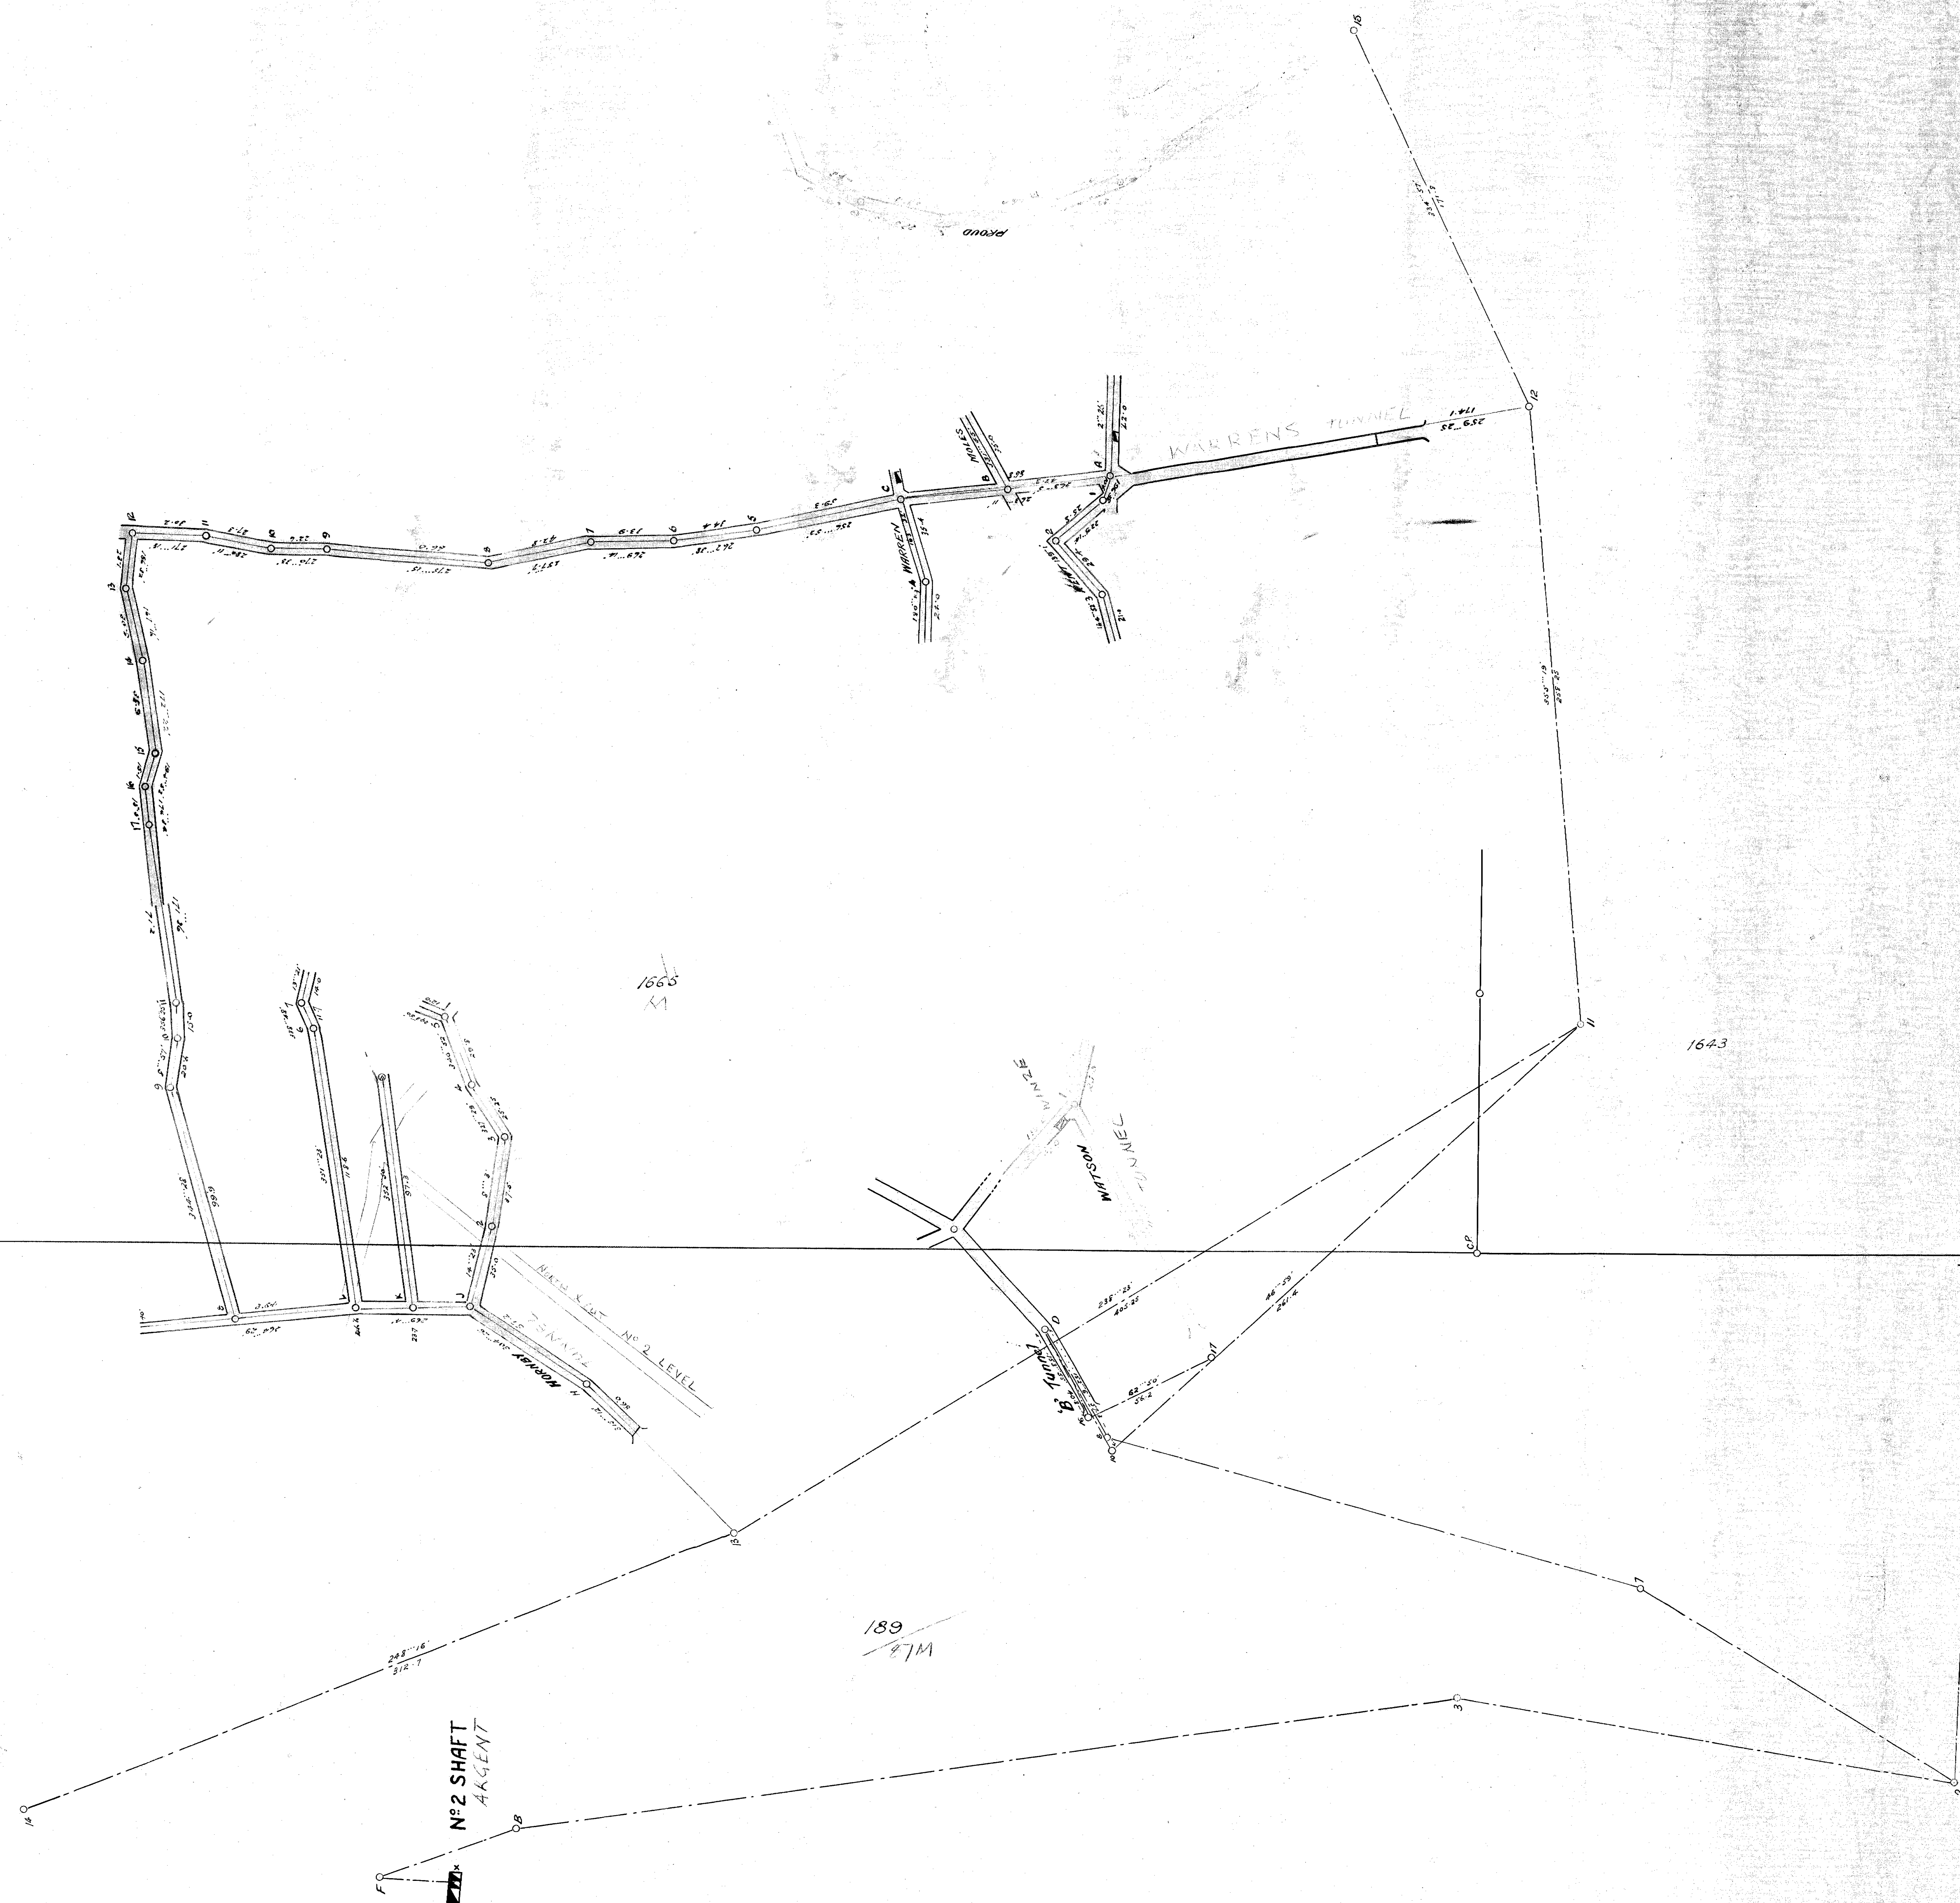


N^o 2 Shaft Tribute Workings

SCALE 

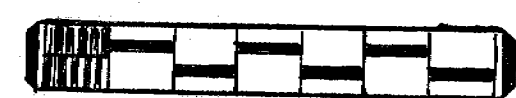

General Manager
29/8/11

[Handwritten notes:]

UW
H. H. H. H. H.
M. H. H. H. H.