

155-17

BRITANNIA MINE


Scale 40 Ft. = 1 Inch.



WEST BOUNDARY.

41-551

5 cm

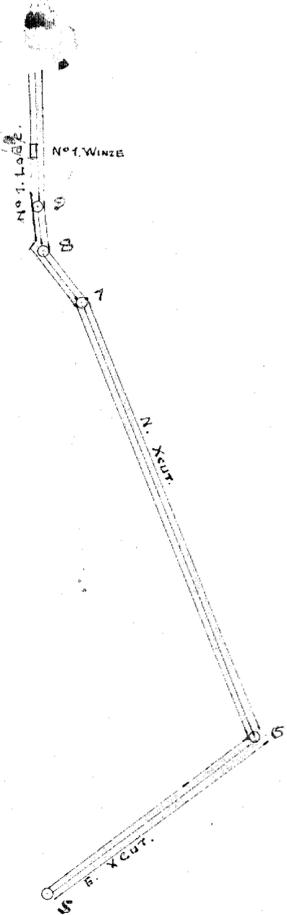

SECTION LINE

Egd
24-5-22.

31st Dec. 1921.
J. H. ...
Manager.