


155-18

BRITANNIA MINE

LONGITUDINAL SECTION

Scale 40 Ft = 1 Inch.

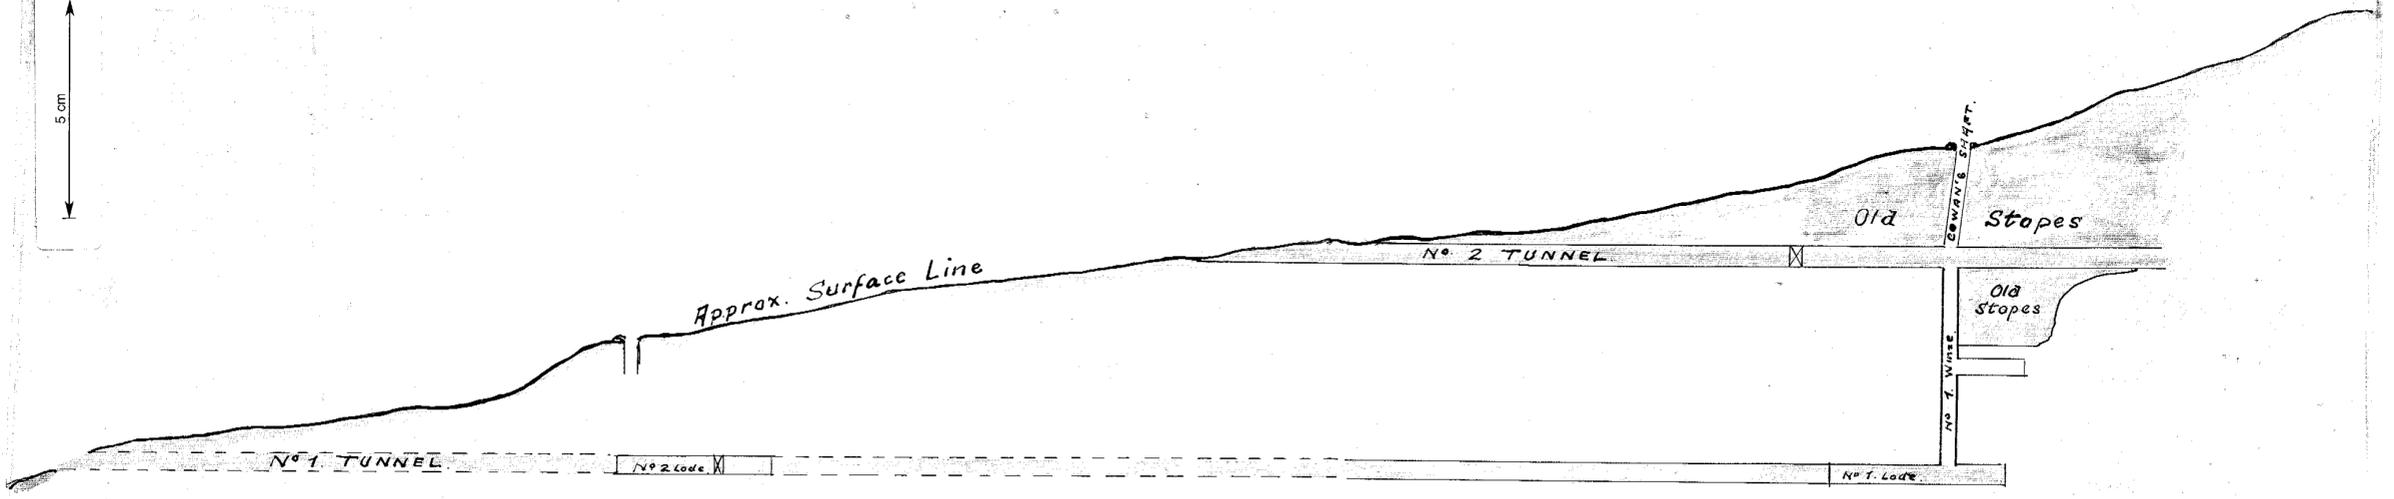

155-18

31/12/21.

*[Handwritten signature]*