
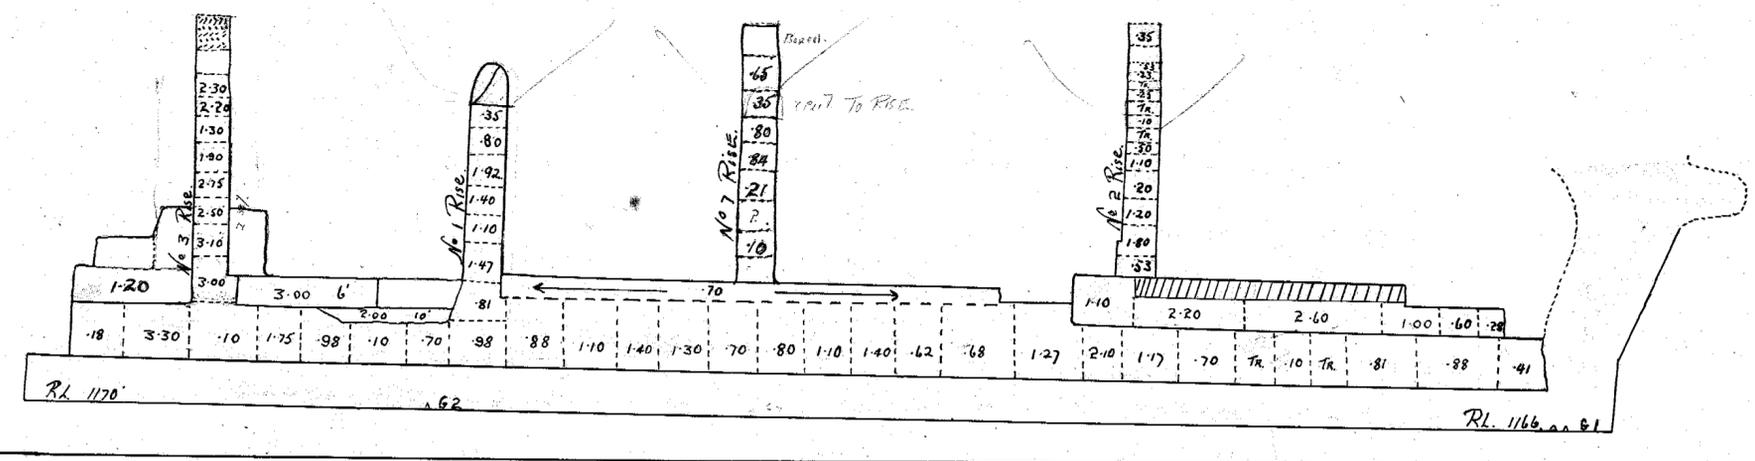


155-22

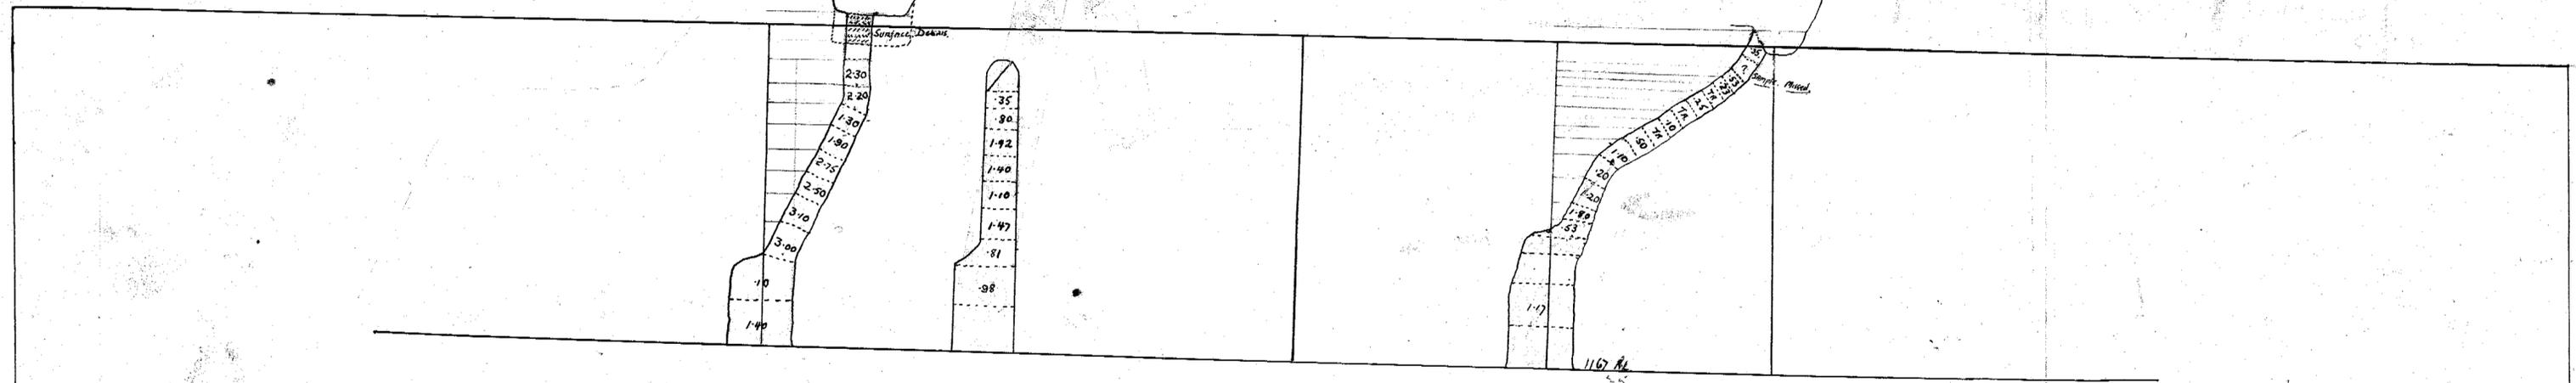

Stoping & Assay Plan of Griesan Lode 15-11-45

Scale 20' = 1" WITH 270 Tons Ore sent to Revision Bell. 68% Chemical Assay.

[Signature]

704
6 1.12