
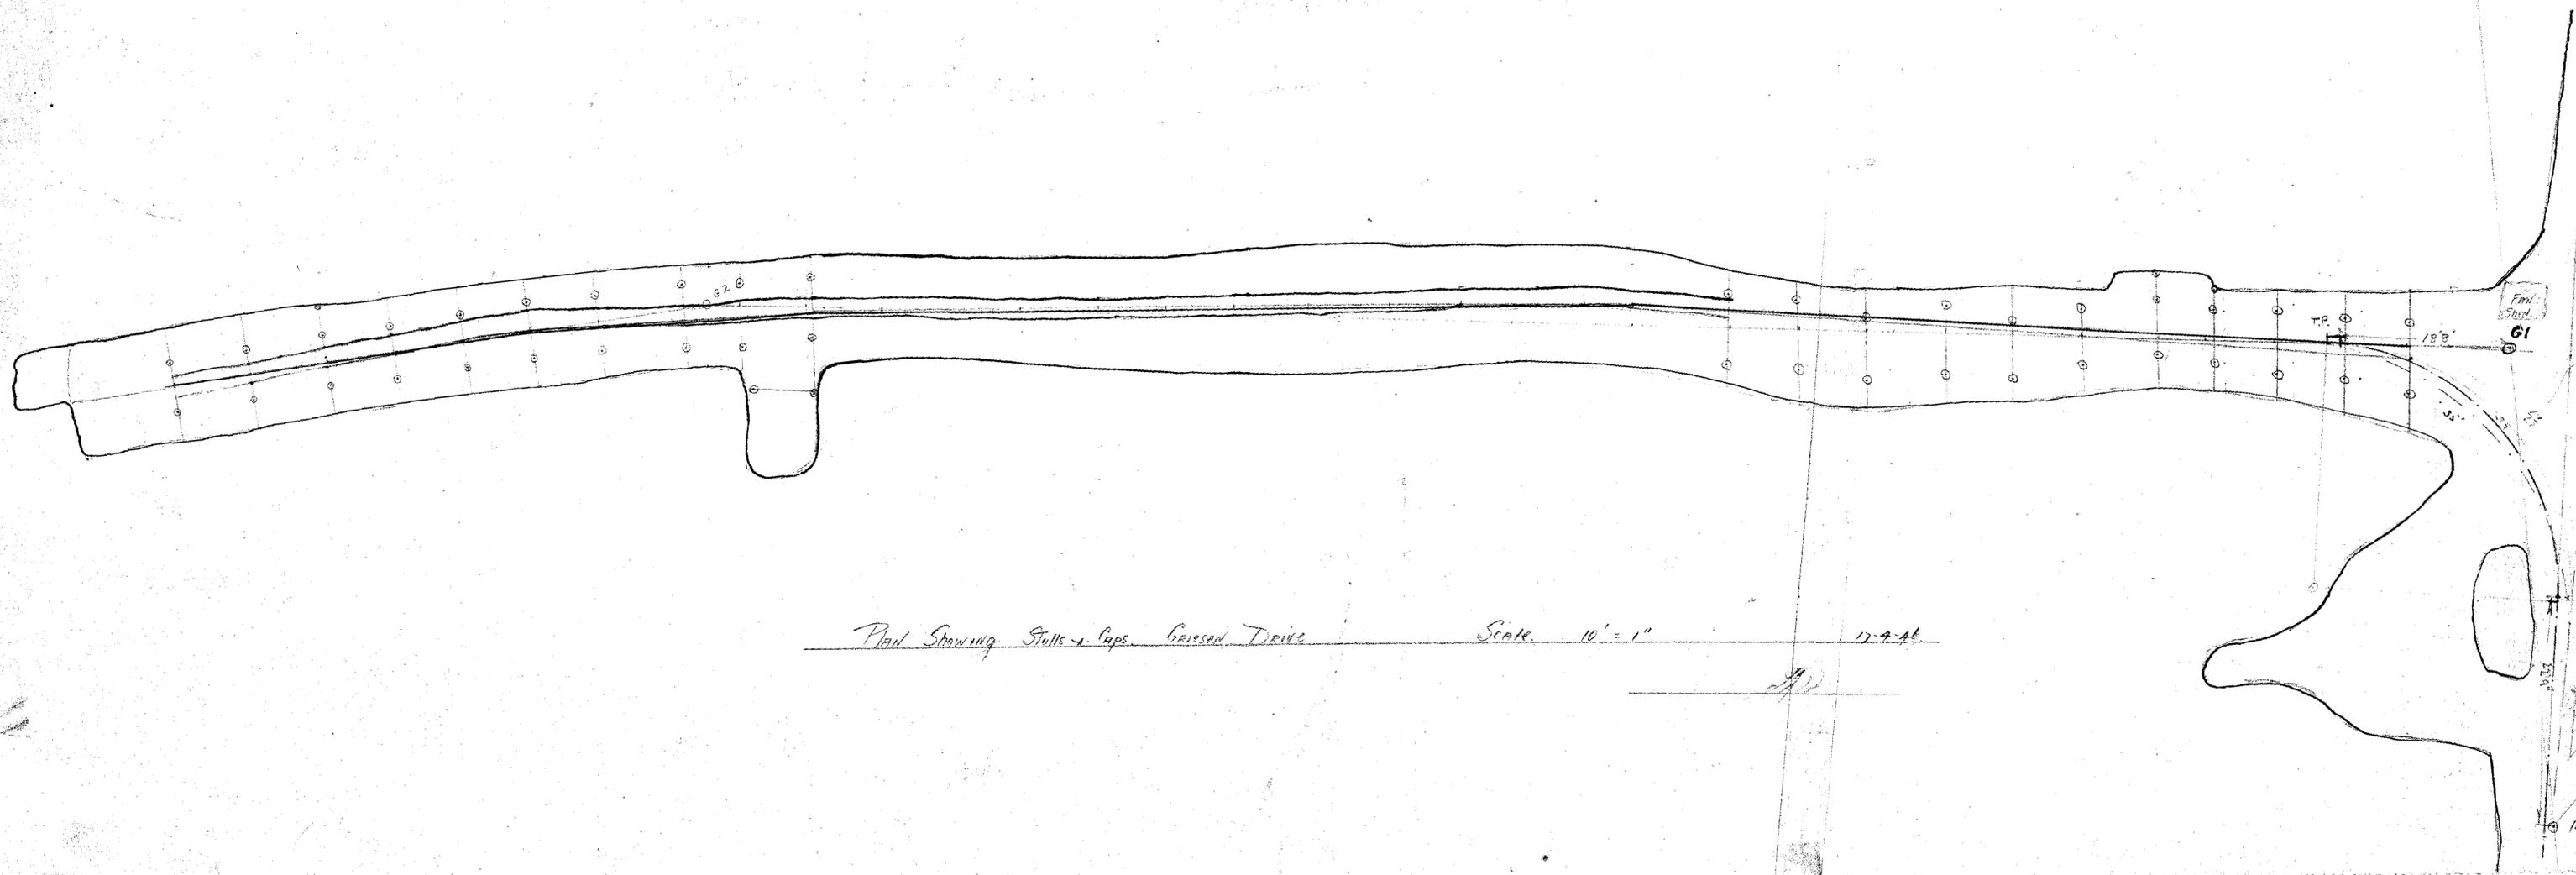


155-23

155-23

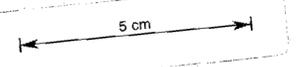

518
7
136

Plan Showing Stalls & Caps. Grissen Drive Scale 10' = 1" 12-9-46

Fail. Spot. 61

Mail Tunnel

M. 1