


156-d

2624 -93 M 80 Ac

W. P. Matton

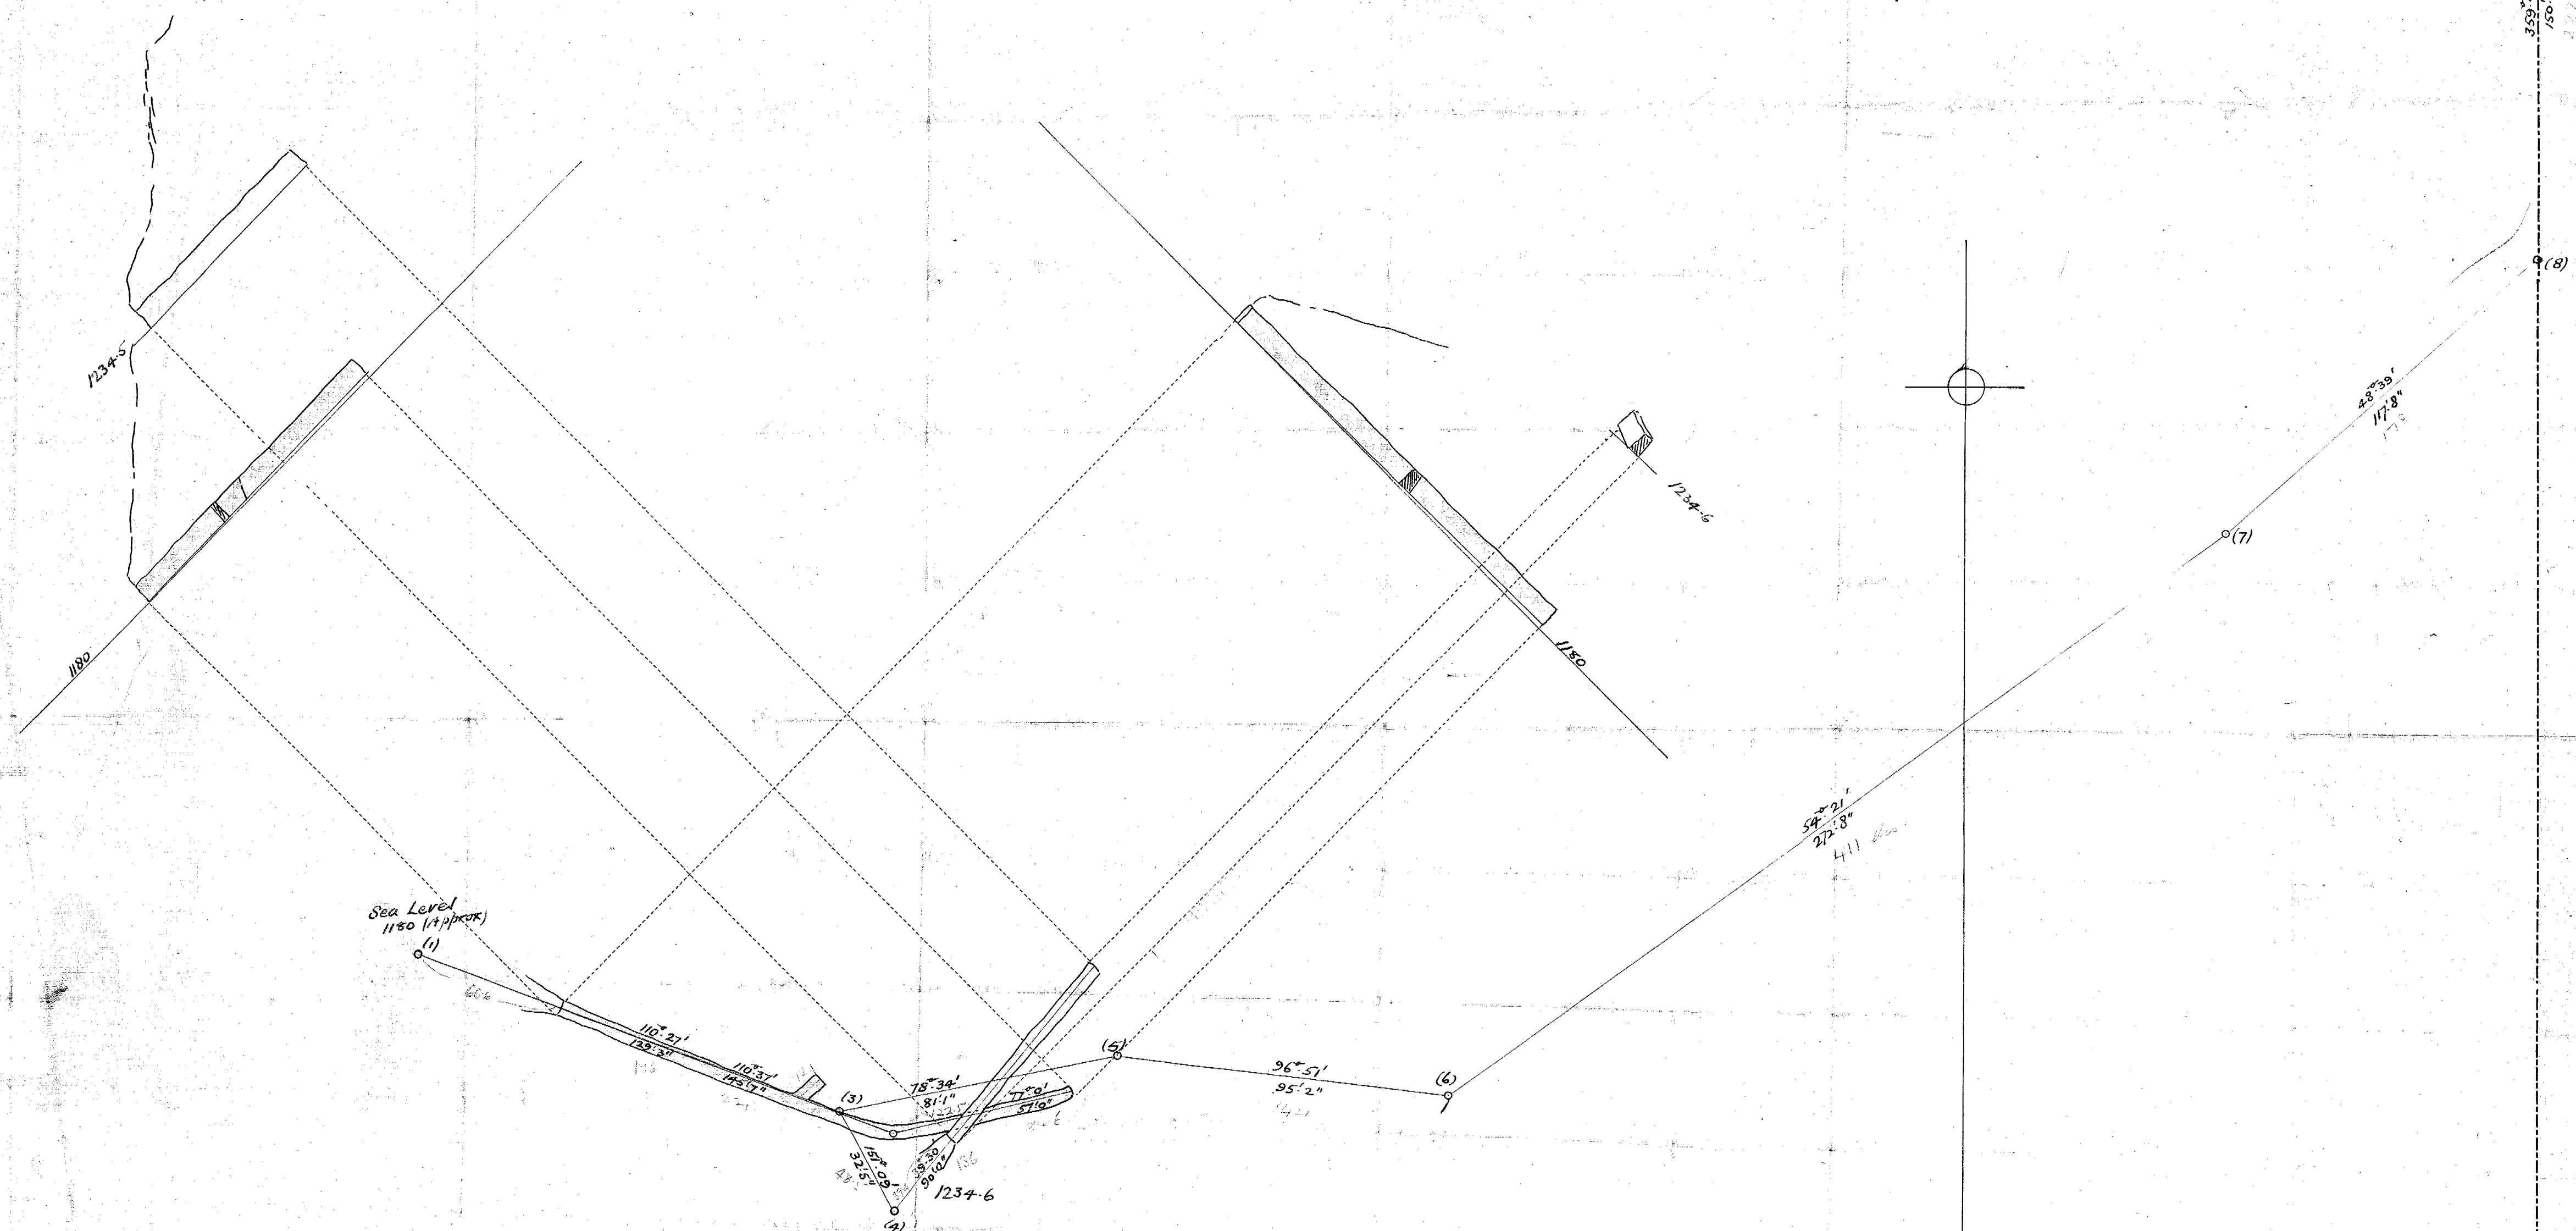

Underground Workings - 1899

The Duke Lyell C.S. & C. Mining Co. N.L.

Scale Thirty Feet to One Inch.

Surveyed with Theodolite & Steel Band M. M. Waller.
Auth. Survey
July 15 '00.

