


PLAN AND SECTIONS OF WORKINGS.

W.F.BELSTEAD ESQ.
Secretary for Mines
Hobart.

THE COPPER MINES OF MOUNT LYELL WEST, LIMITED.

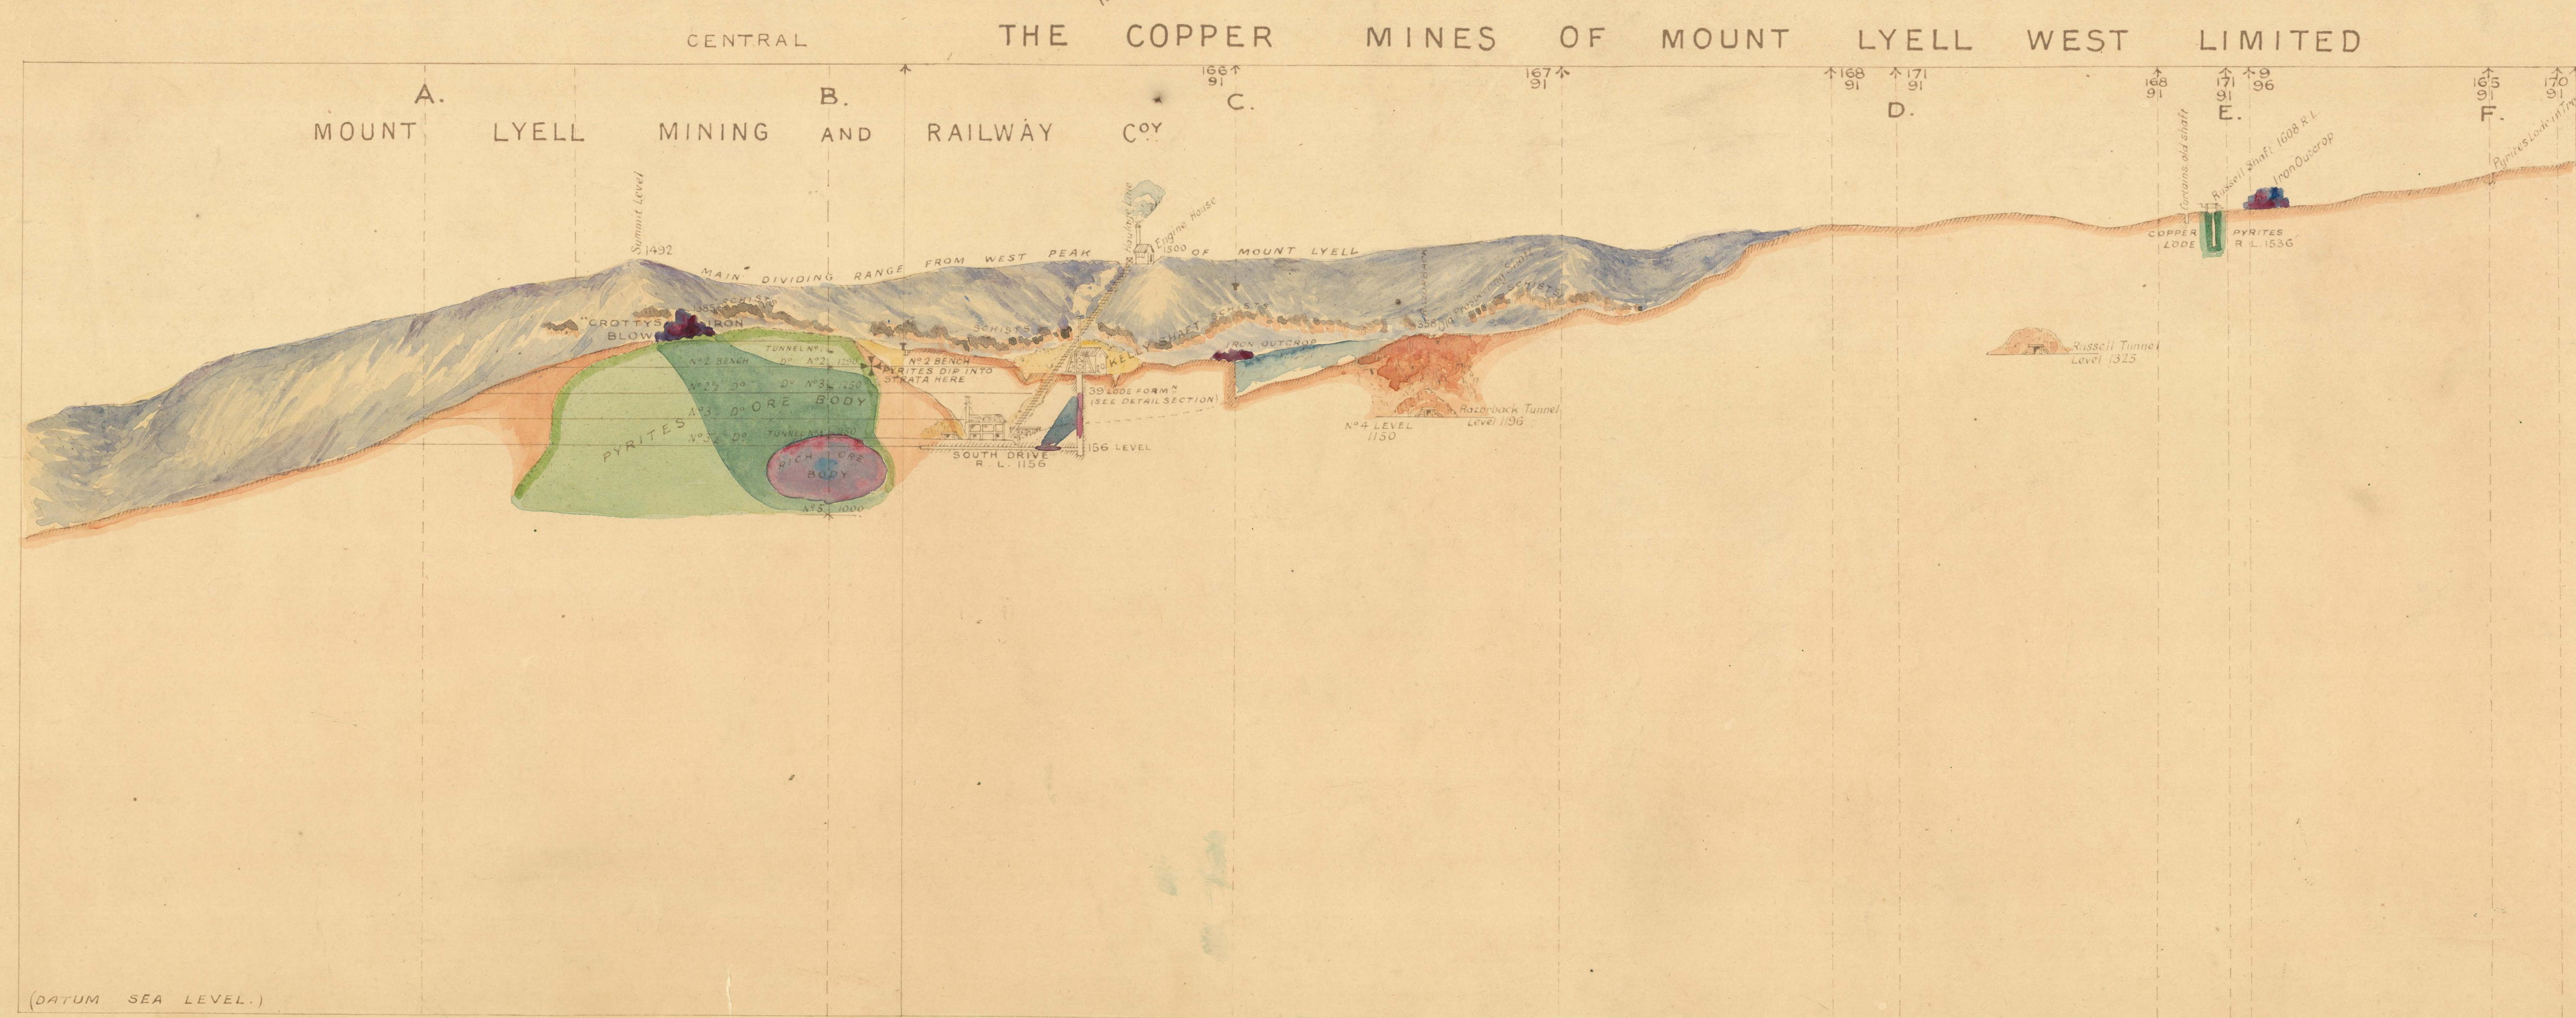

LONGITUDINAL SECTION ON LINE A. B. C. D. E. F.

— SECTION THROUGH KELLY SHAFT & DRIVE.—

