

1001  
157-94



RAZORBACK TUNNEL  
Datum Line

The Copper Mines of Mt Lyell West Ltd  
167-91

The Copper Mines of Mt Lyell West Ltd  
169-91


The Mount Lyell M. & R. Co Ltd

The Copper Mines of Mt Lyell West Ltd  
Underground Survey 1900

Scale—25 Feet to 1 Inch—

Survey made with theodolite & steelband chain

John Power  
Authorized Surveyor  
February 1901

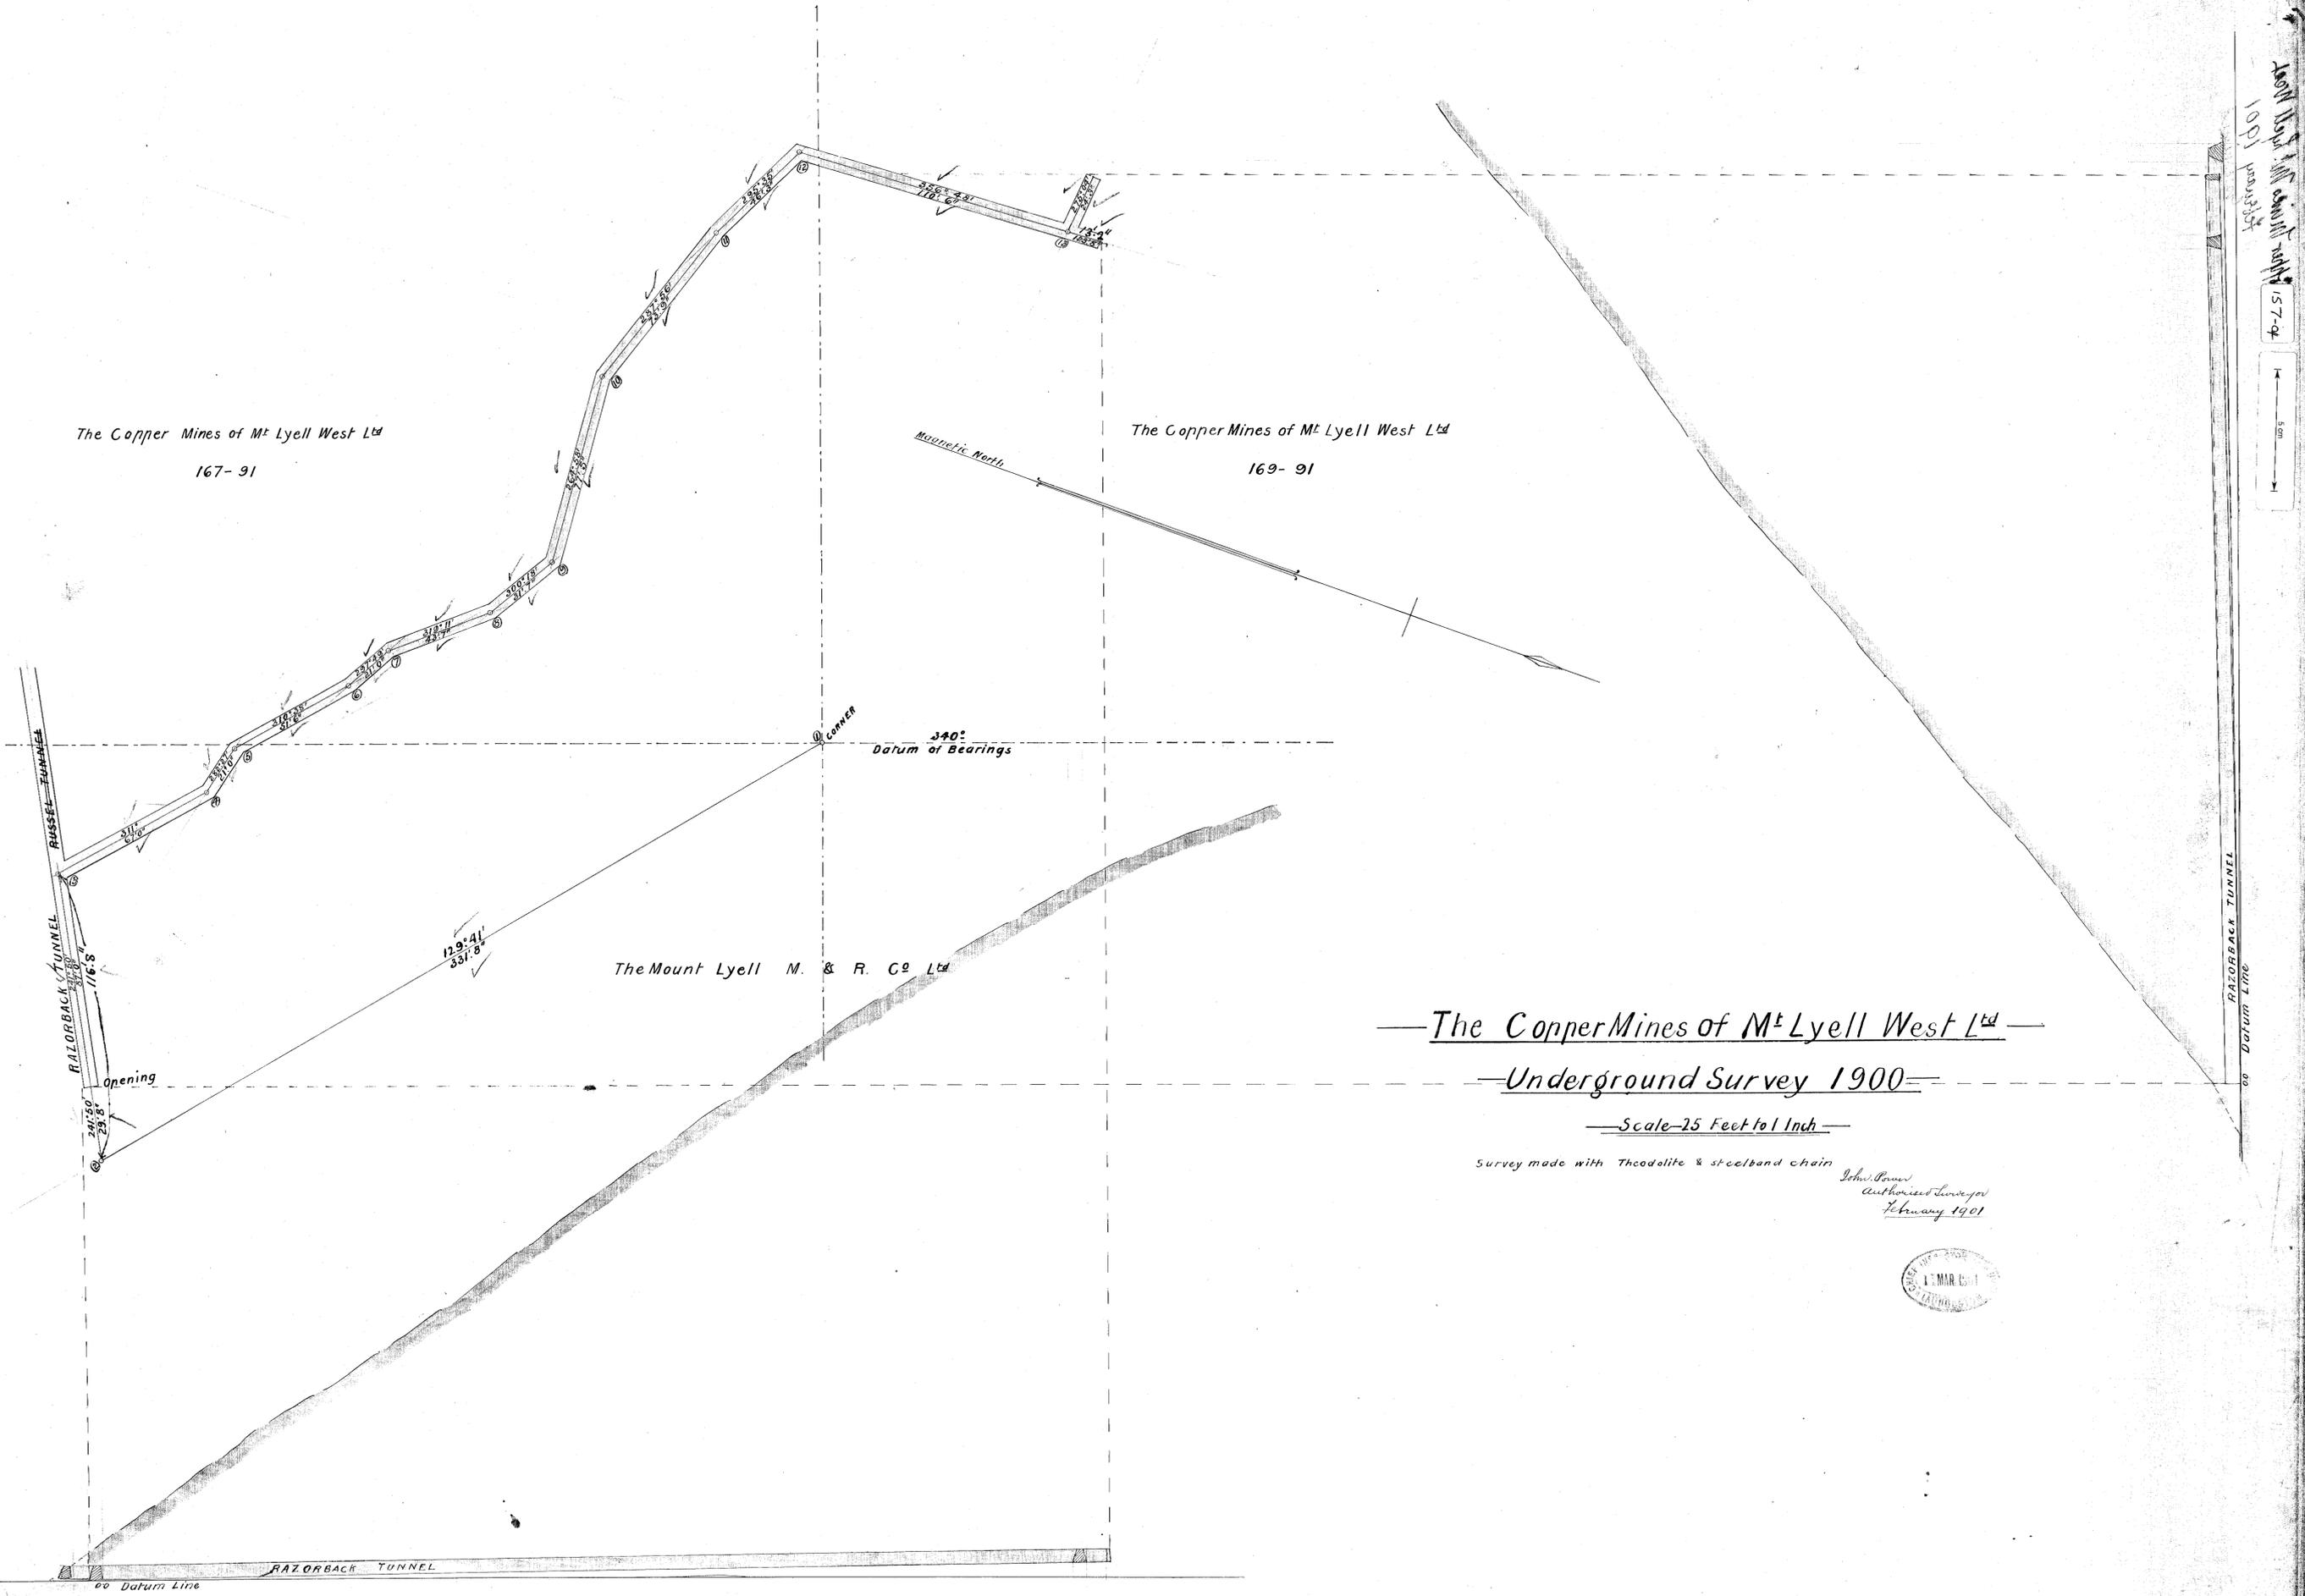

70-451