


The Copper Mines of Mt Lyell West Ltd

168-91

The Copper Mines of Mt Lyell West Ltd
165-91

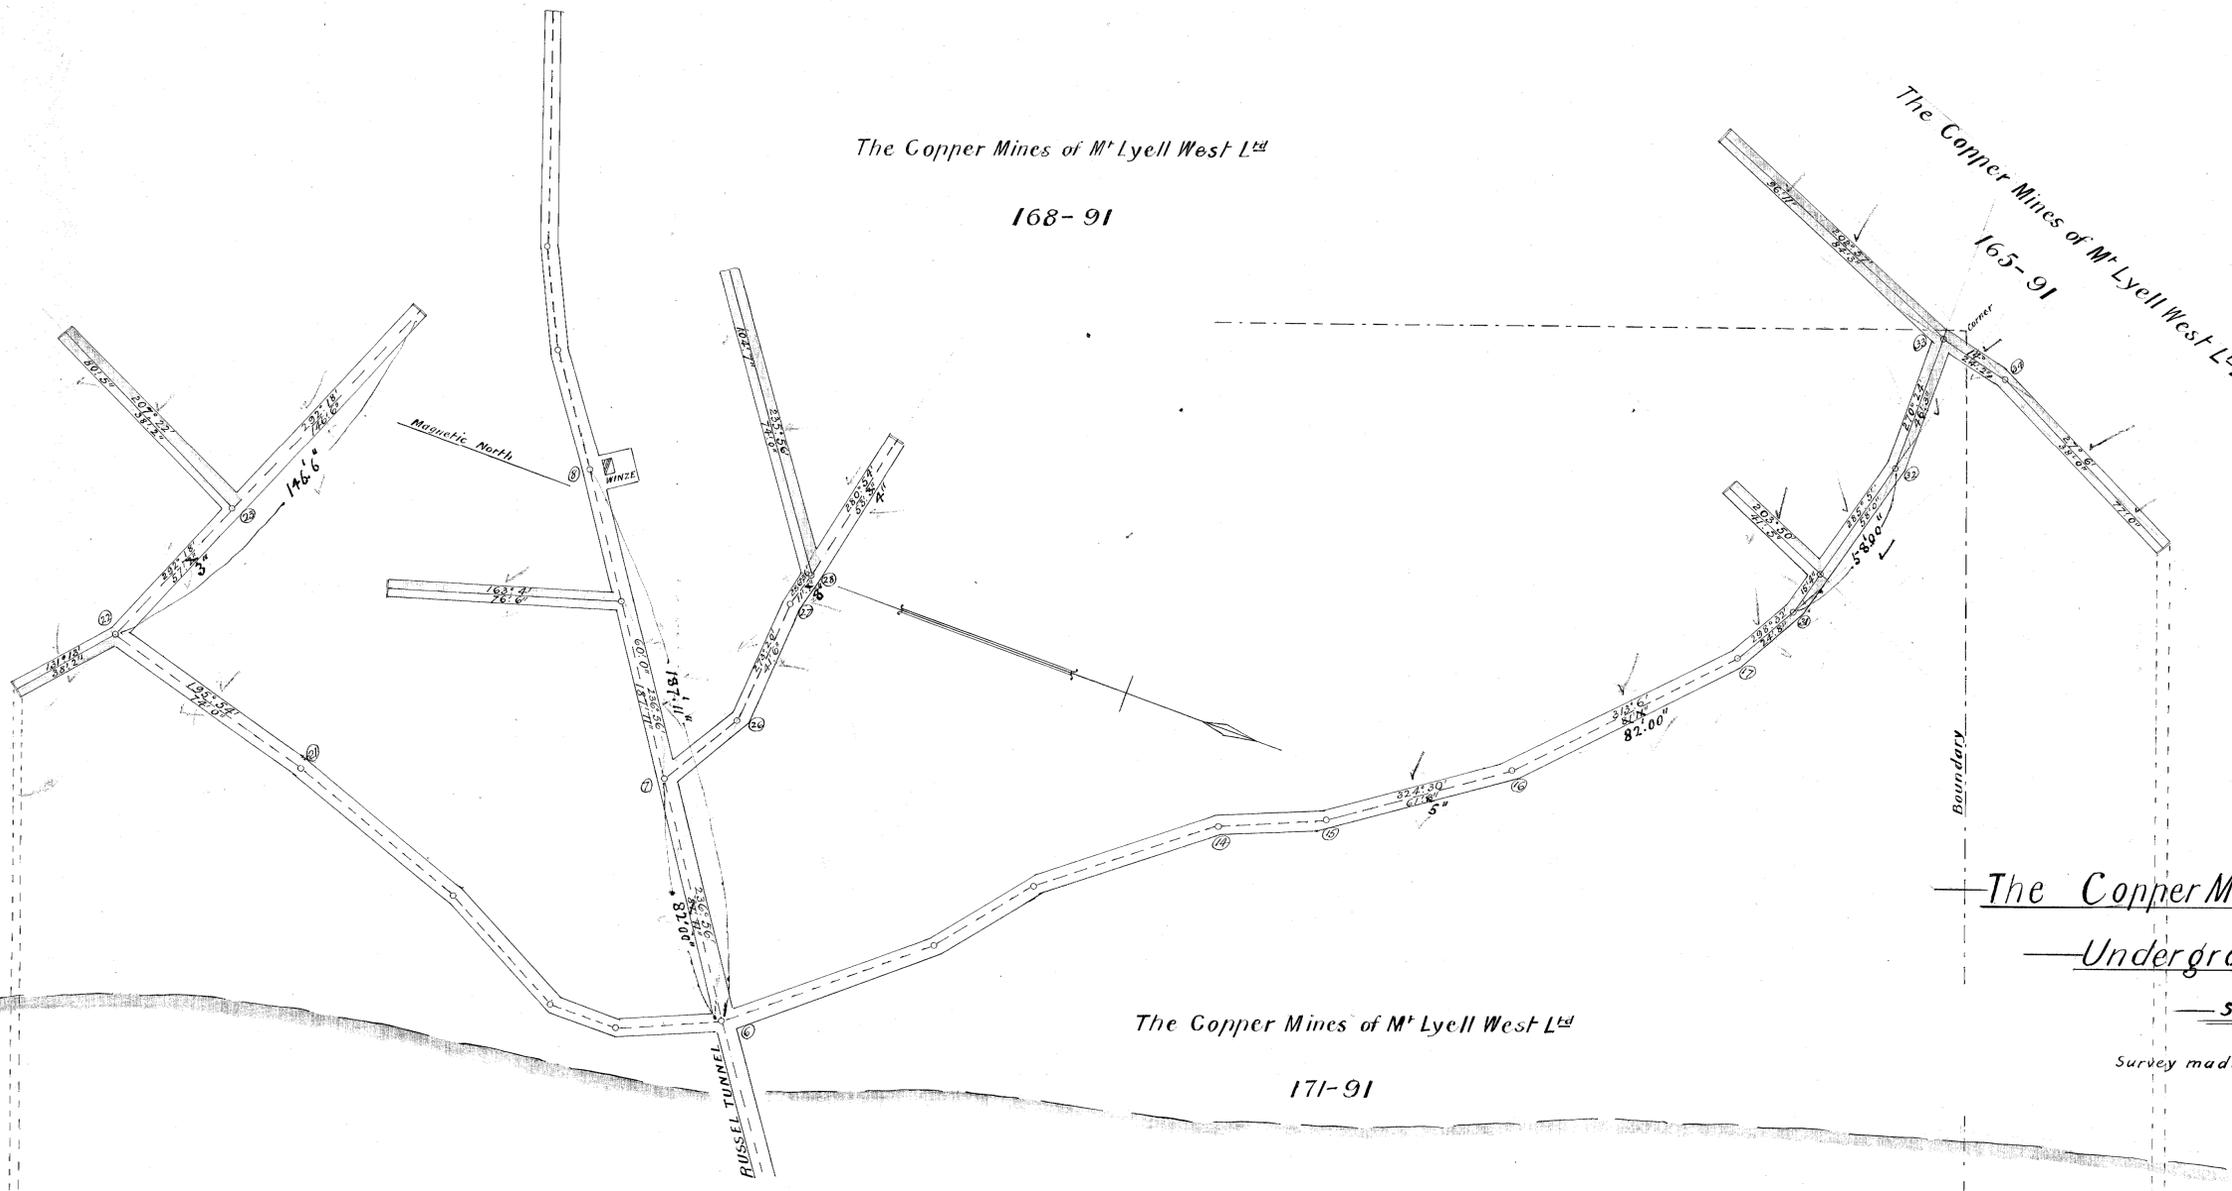

The Copper Mines of Mt Lyell West Ltd

171-91


The Copper Mines of Mt Lyell West Ltd

Underground Survey 1900

Scale - 25 Feet to 1 Inch

Survey made with Theodolite & Steelband chain

Johannes
Authorised Surveyor
February 1901

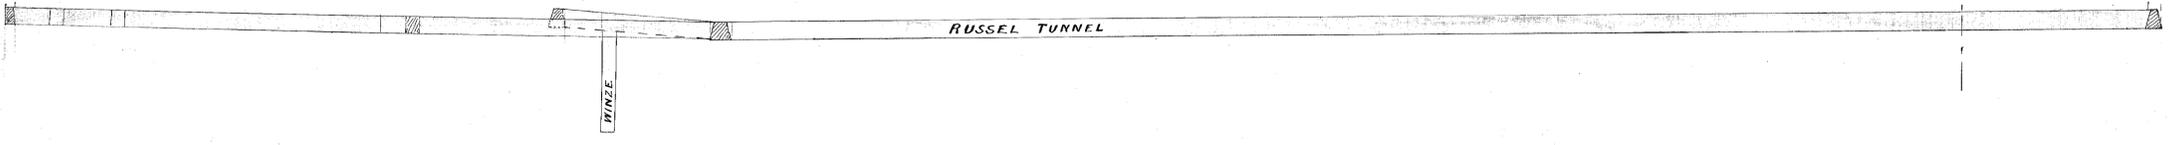

Razorback
Datum Russel Tunnel