



—Copper Mines of Mount Lyell West—
 —Drive From Prince Lyell Tunnel—
 —Underground Survey 1899—

—Scale— 25 Feet to an Inch —

*John P. Rice,
 authorized Surveyor
 April 1900*

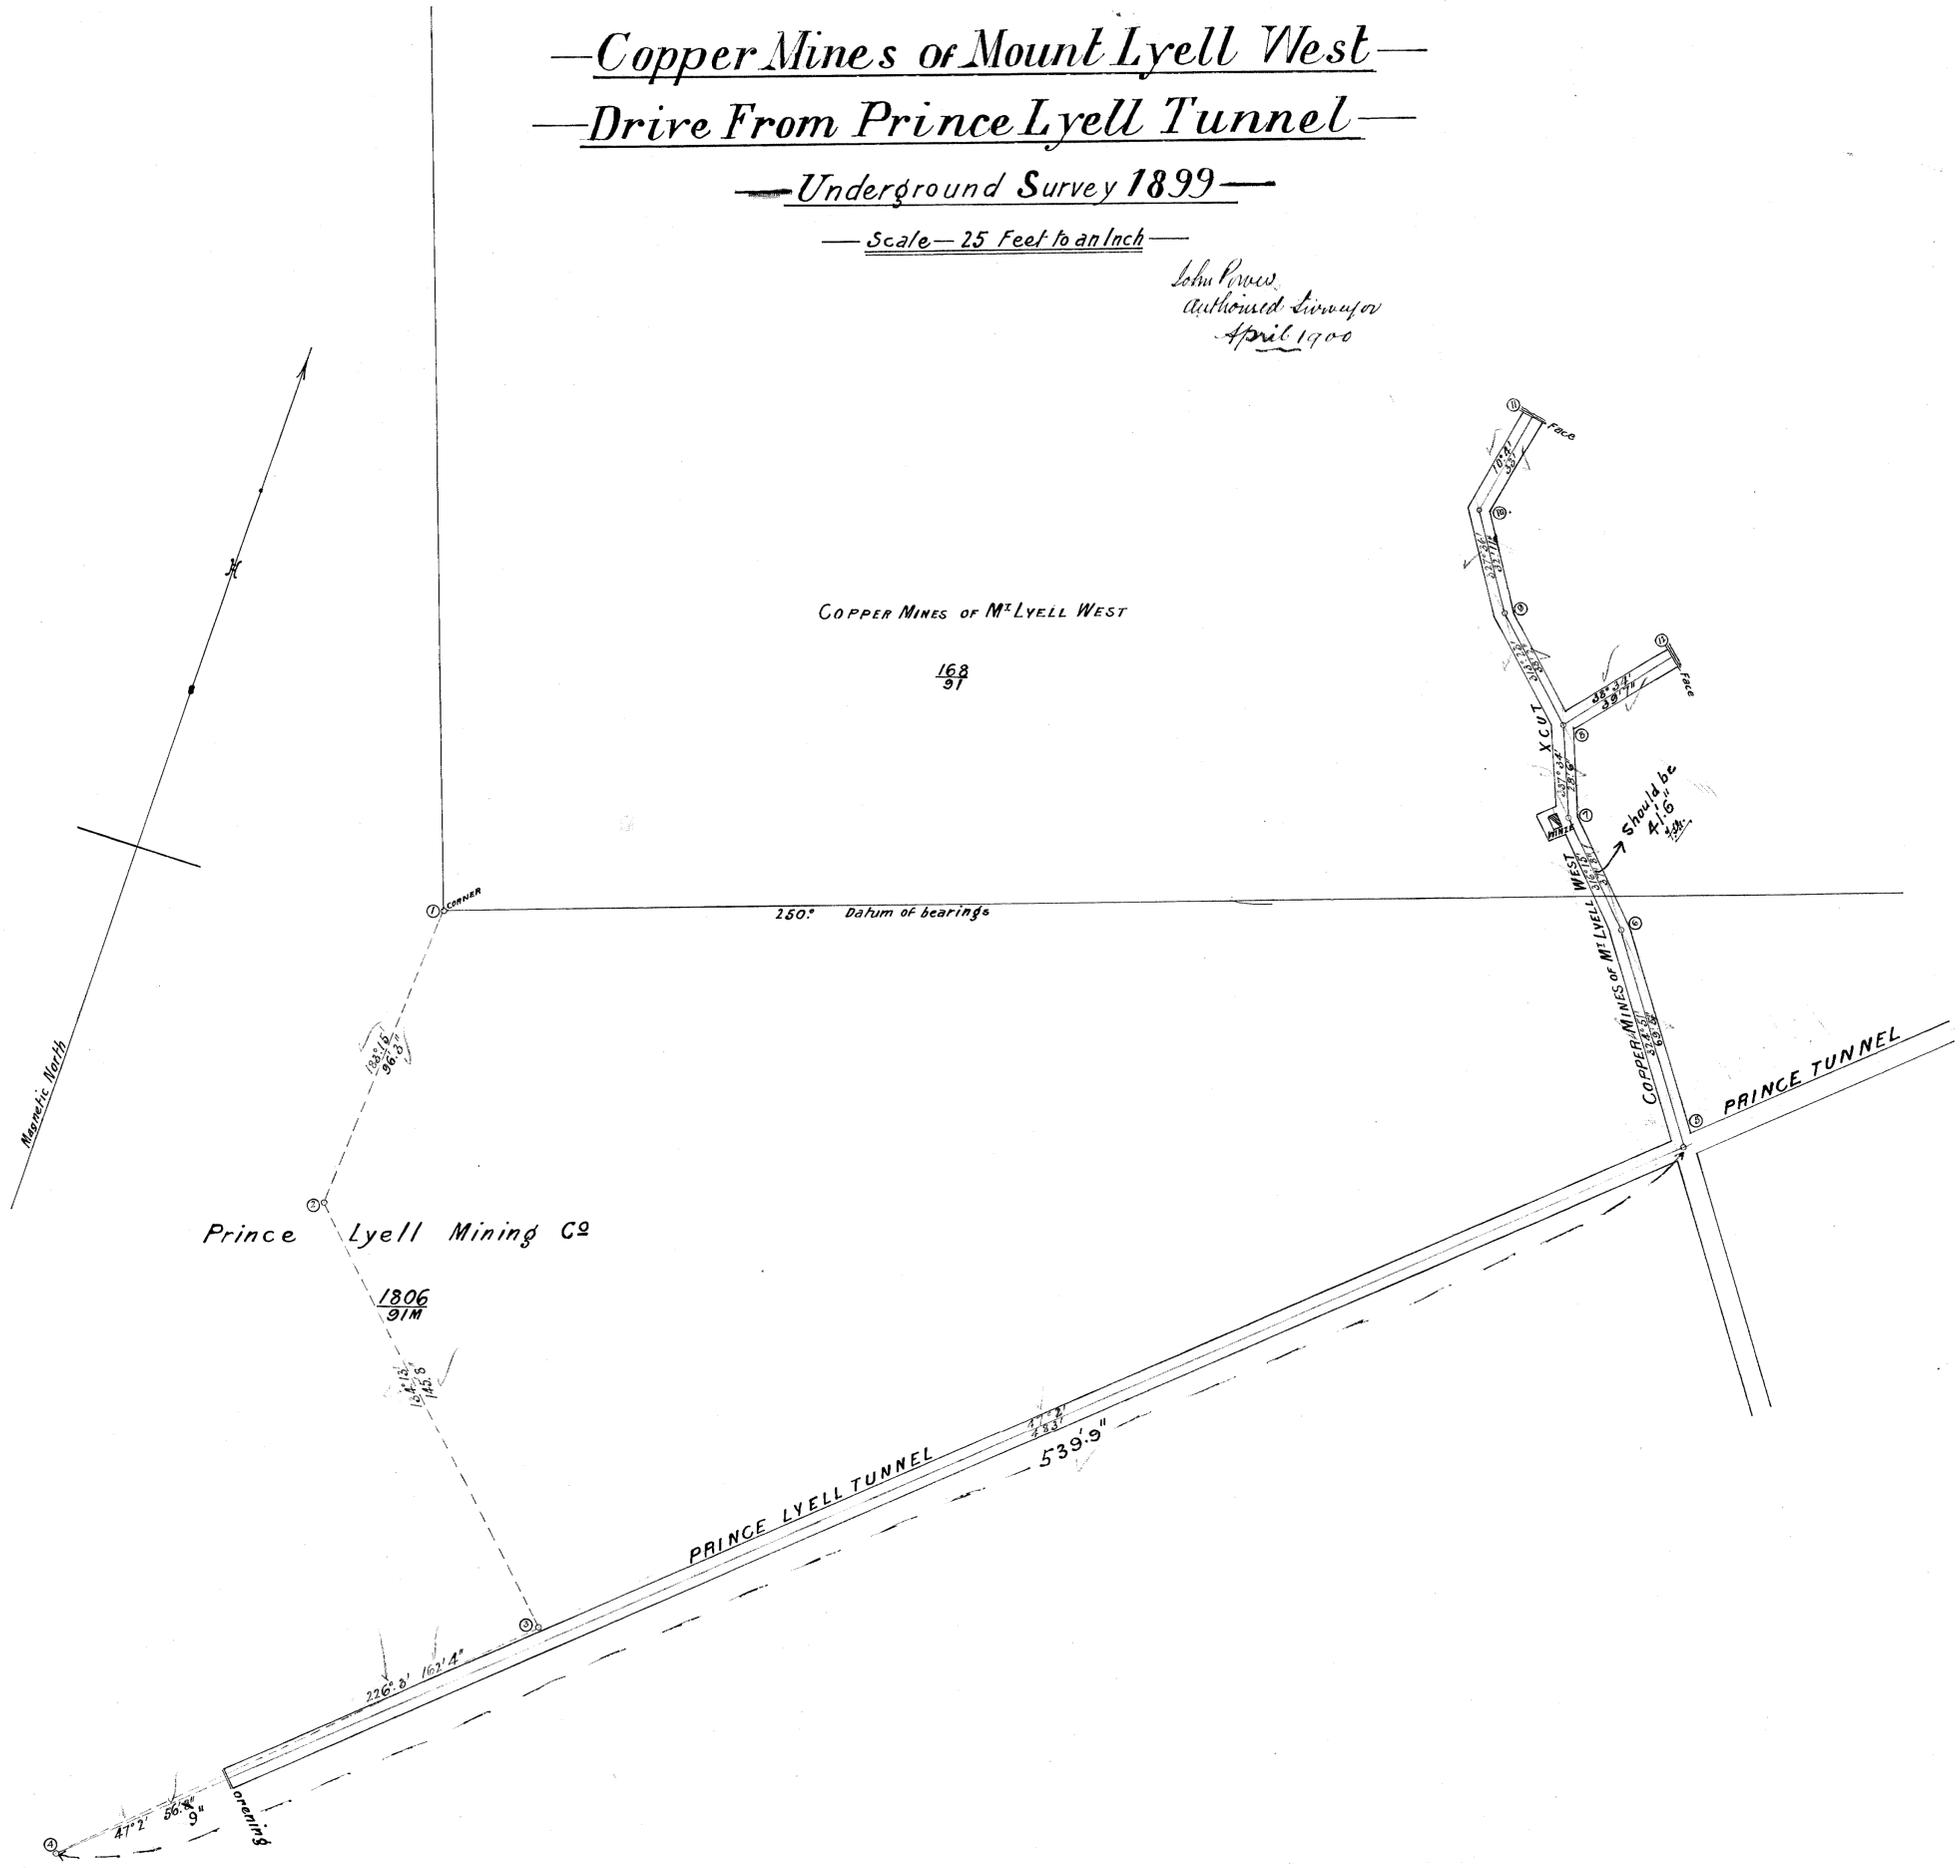

157-06

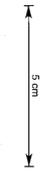

157-06