

157-08

Copper Mines of Mount Lyell West


Underground Survey 1901

Scale - 25 Feet to an Inch

John Power
Authn. Surveyor
March 1902



Handwritten notes:
Copper Mines Mt Lyell West
1805
Mt Lyell

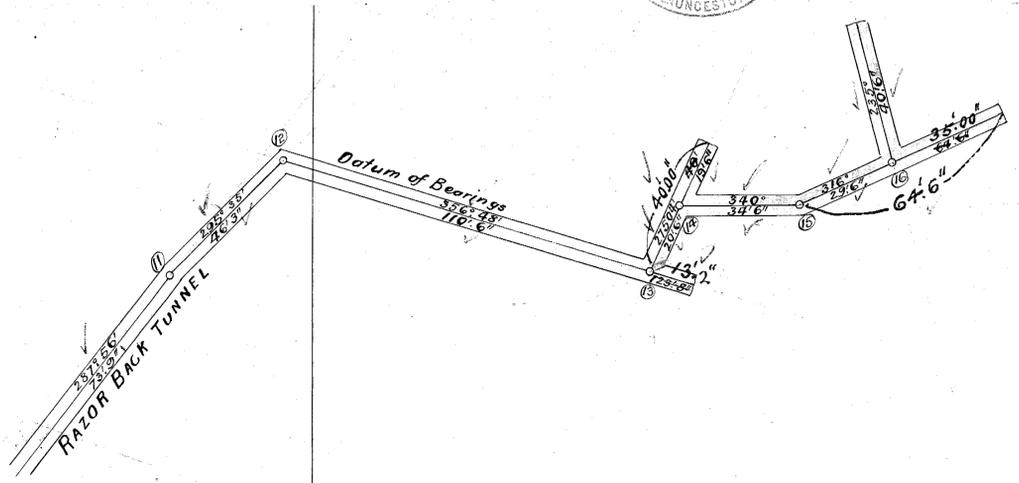

The Copper Mines of Mt Lyell West Ltd

167-91.

The Copper Mines of Mt Lyell West Ltd

169-91.

The Mount Lyell M. & R. Co. Ltd