
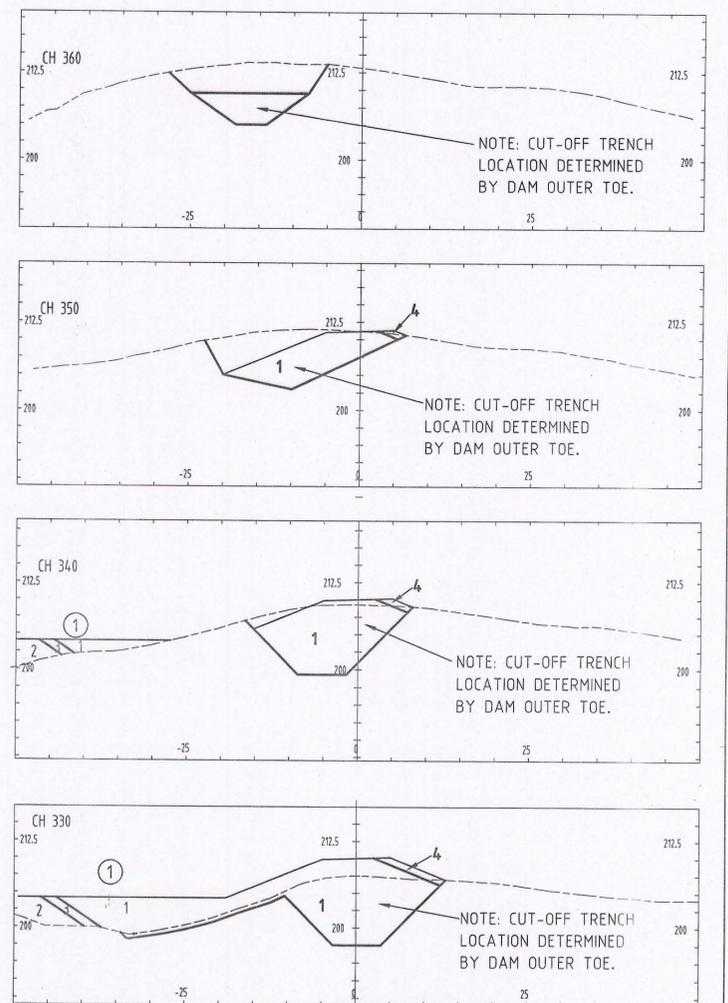
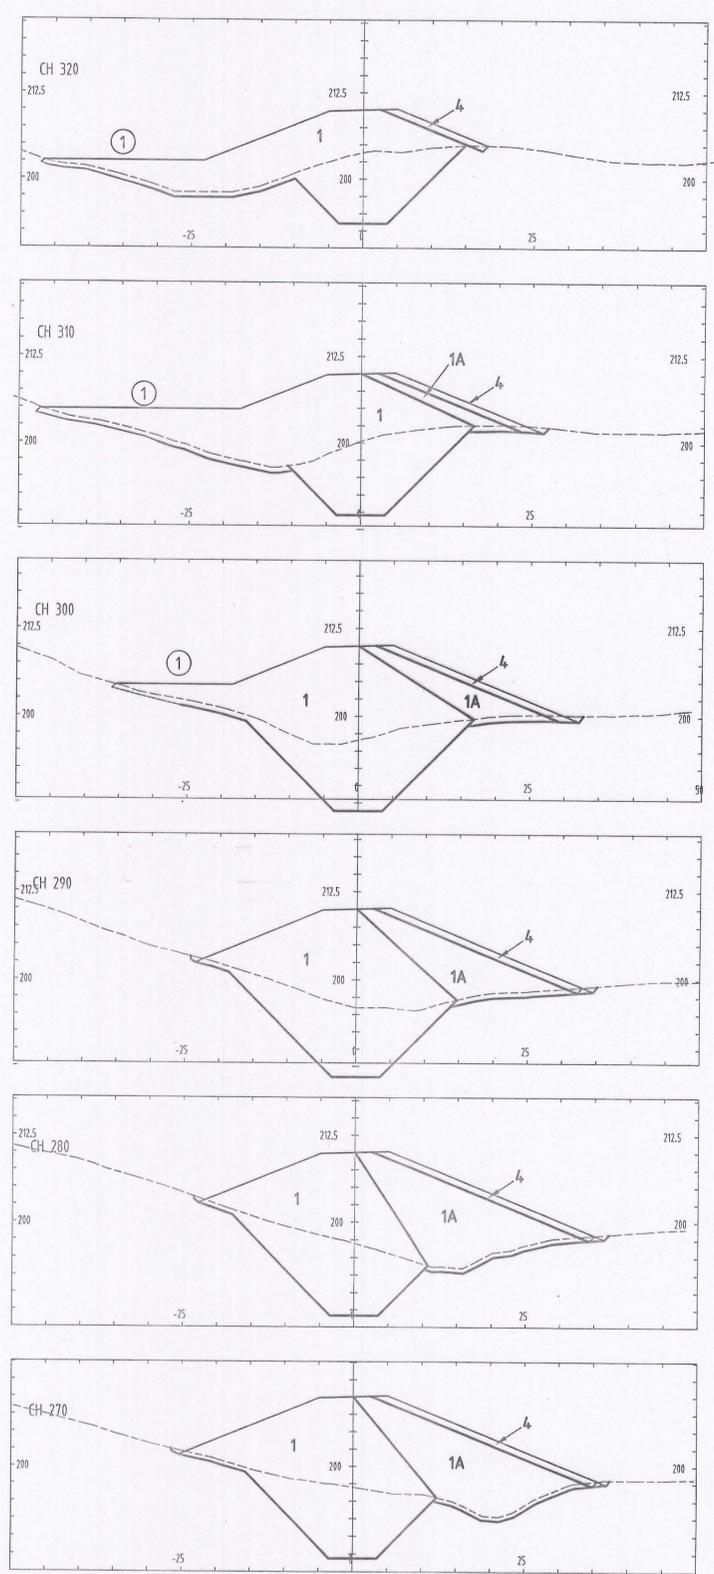


0157_045

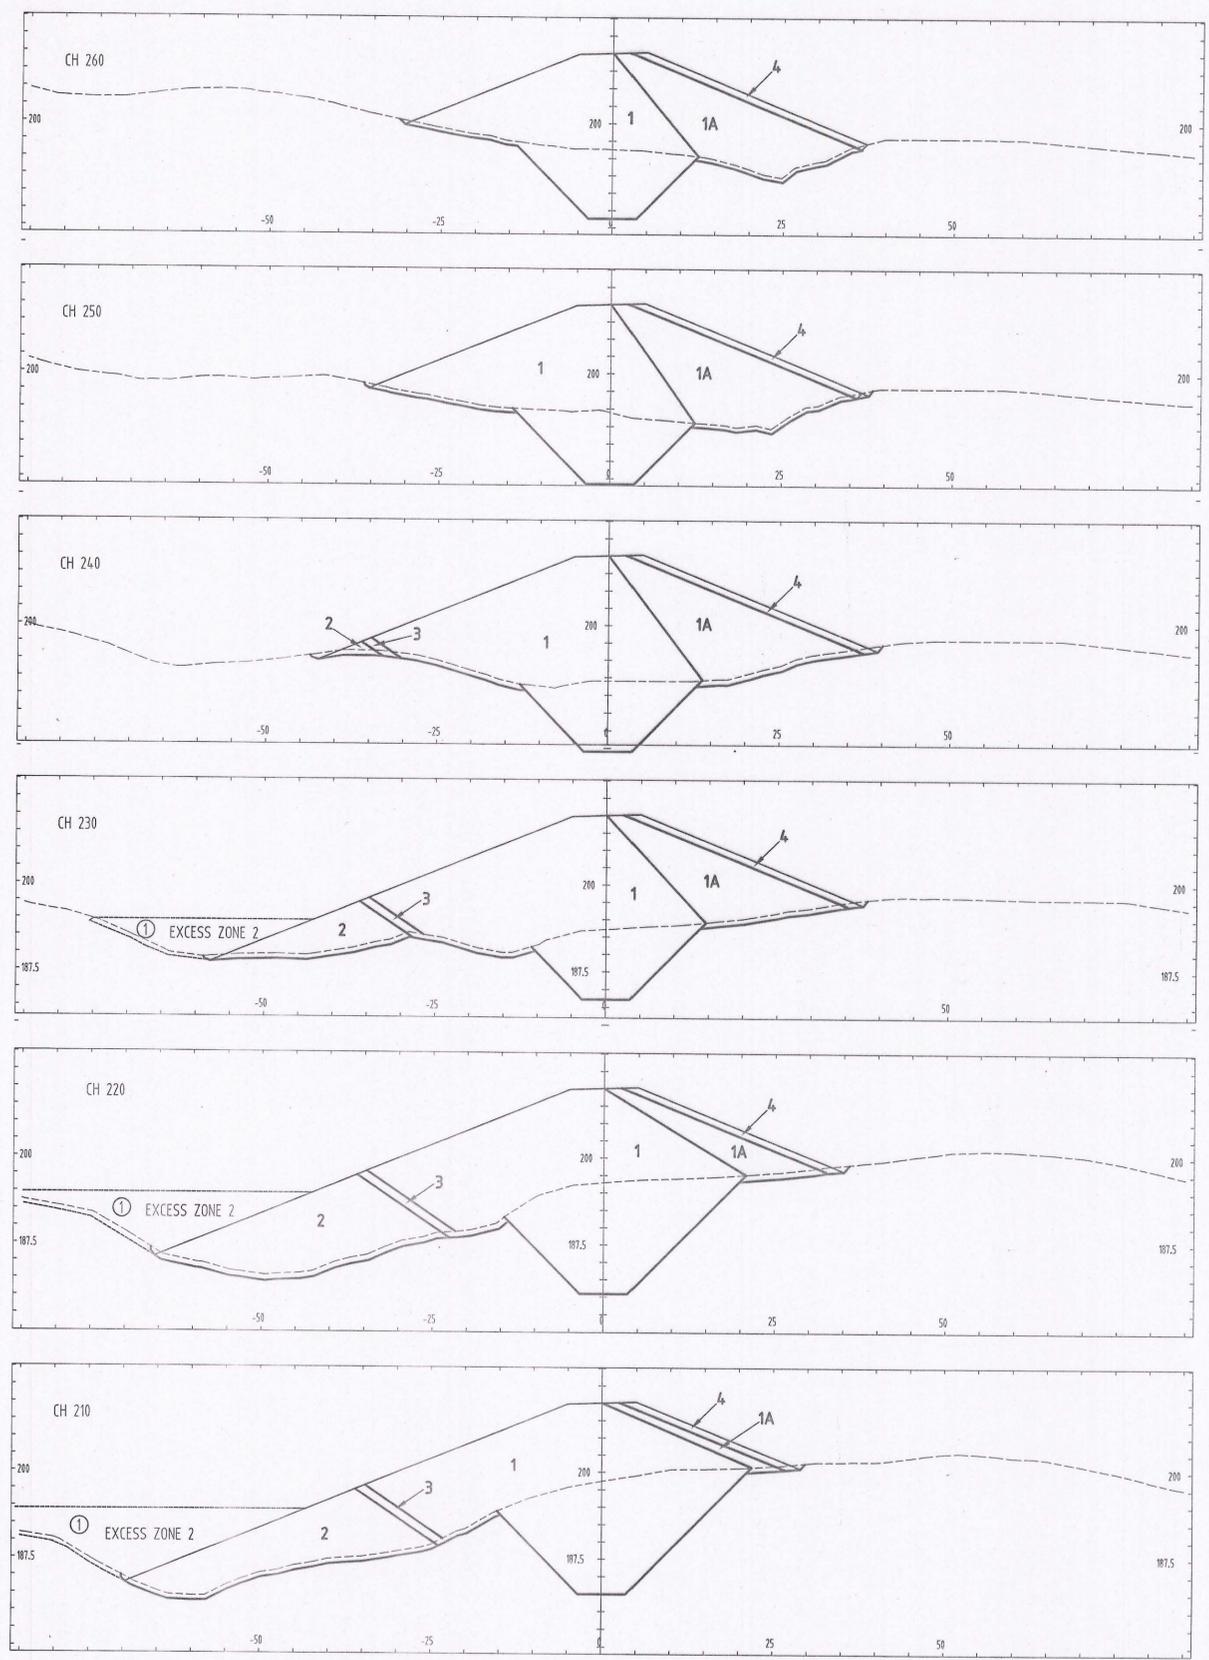

Rev. No.	Description	Date
1	EXCESS ZONE 2 ADDED	15-8-'95
0	ISSUED FOR TENDER	8-8-'95

Thompson & Brett Pty. Ltd.
 Consulting Engineers
 7 Bayfield Street, Rosny Park. 7018
 Phone (002) 446633 Fax. (002) 446221

Drawn B.W. Date JUL '95 Scale H 1 : 500 V 1 : 500
 Approved  Director
 File CMT 04 Geocomp 1234

Client & Project
 COPPER MINES OF TASMANIA PTY. LTD.
 MT. LYELL MINE REDEVELOPMENT
 TAILINGS MANAGEMENT STAGE 2

Drawing Title
 PRINCESS CK. TAILINGS DAM LIFT 1a
 CROSS SECTIONS CH. 200 TO CH. 330
 Drawing No. 95 - 1234 - 10 REV. 1