



THE WEST MOUNT LYELL CO

Plan showing Underground workings

Scale - 100 ft to an inch

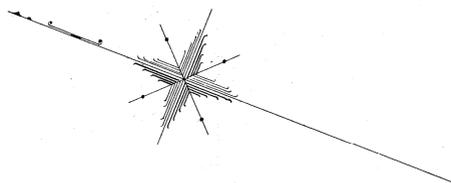

BRITISH MINING INSTITUTE
1881 1/6 1885
THE WEST MOUNT LYELL CO
LHE

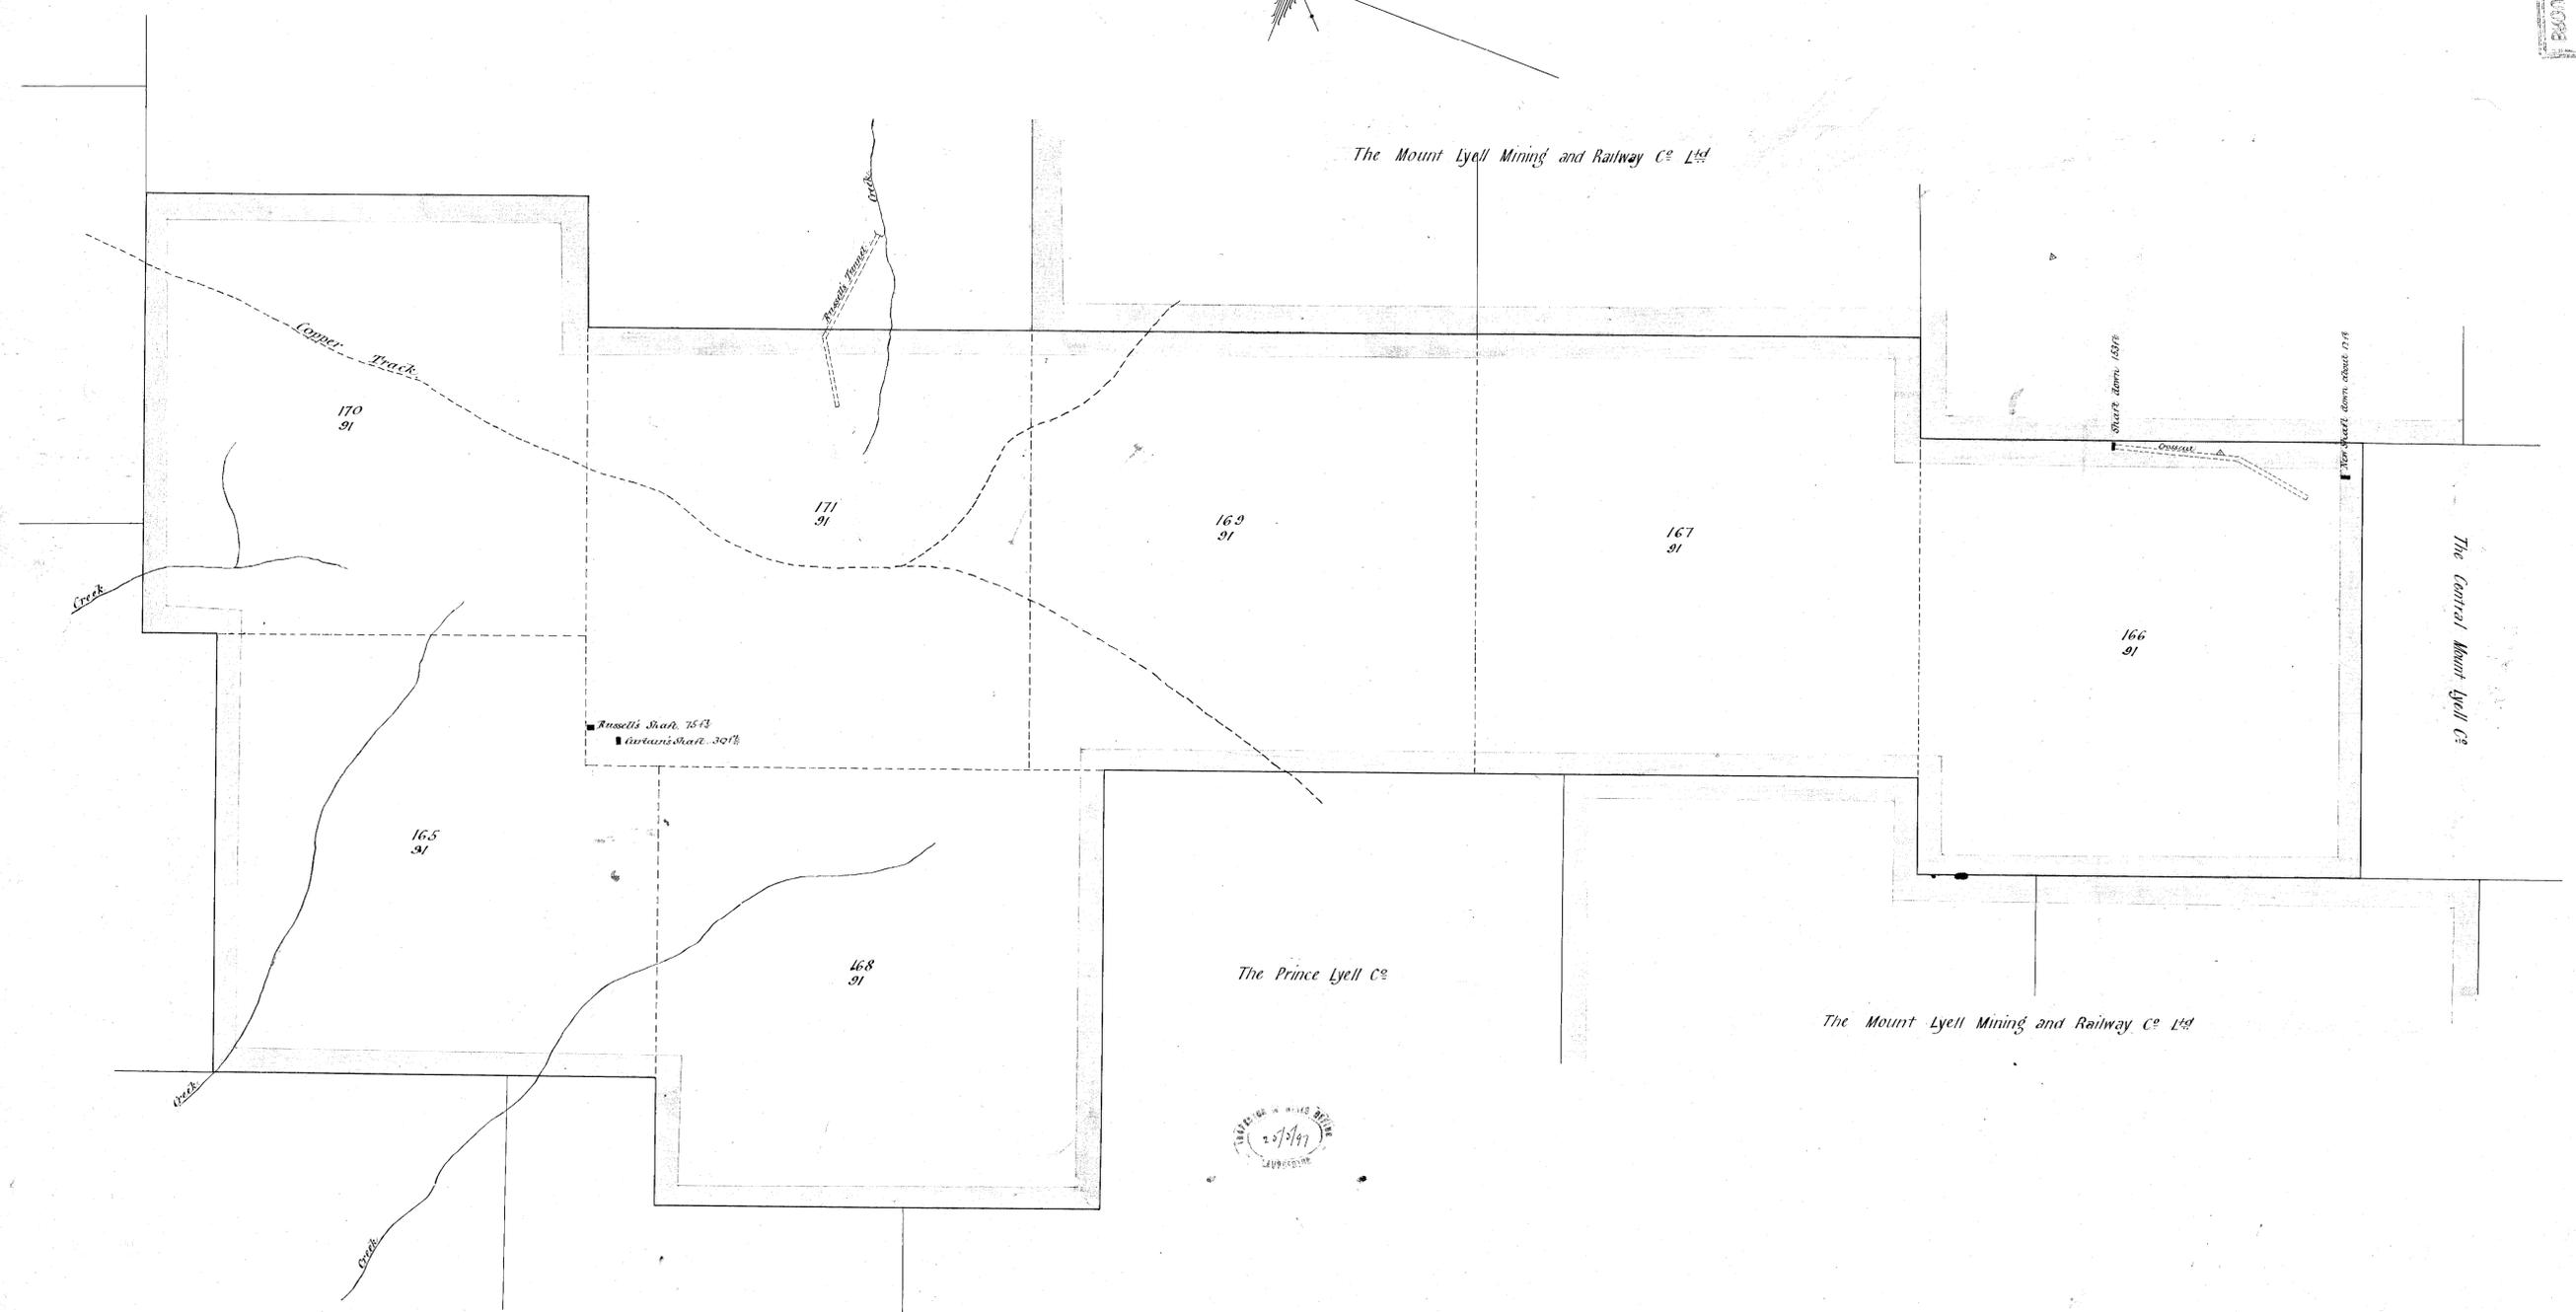

50 ft

10851

1897
LHE