


UNDERGROUND WORKINGS

MOUNT LYELL PROPRIETARY MINES LIM

SCALE OF FEET



1
99 10 AC

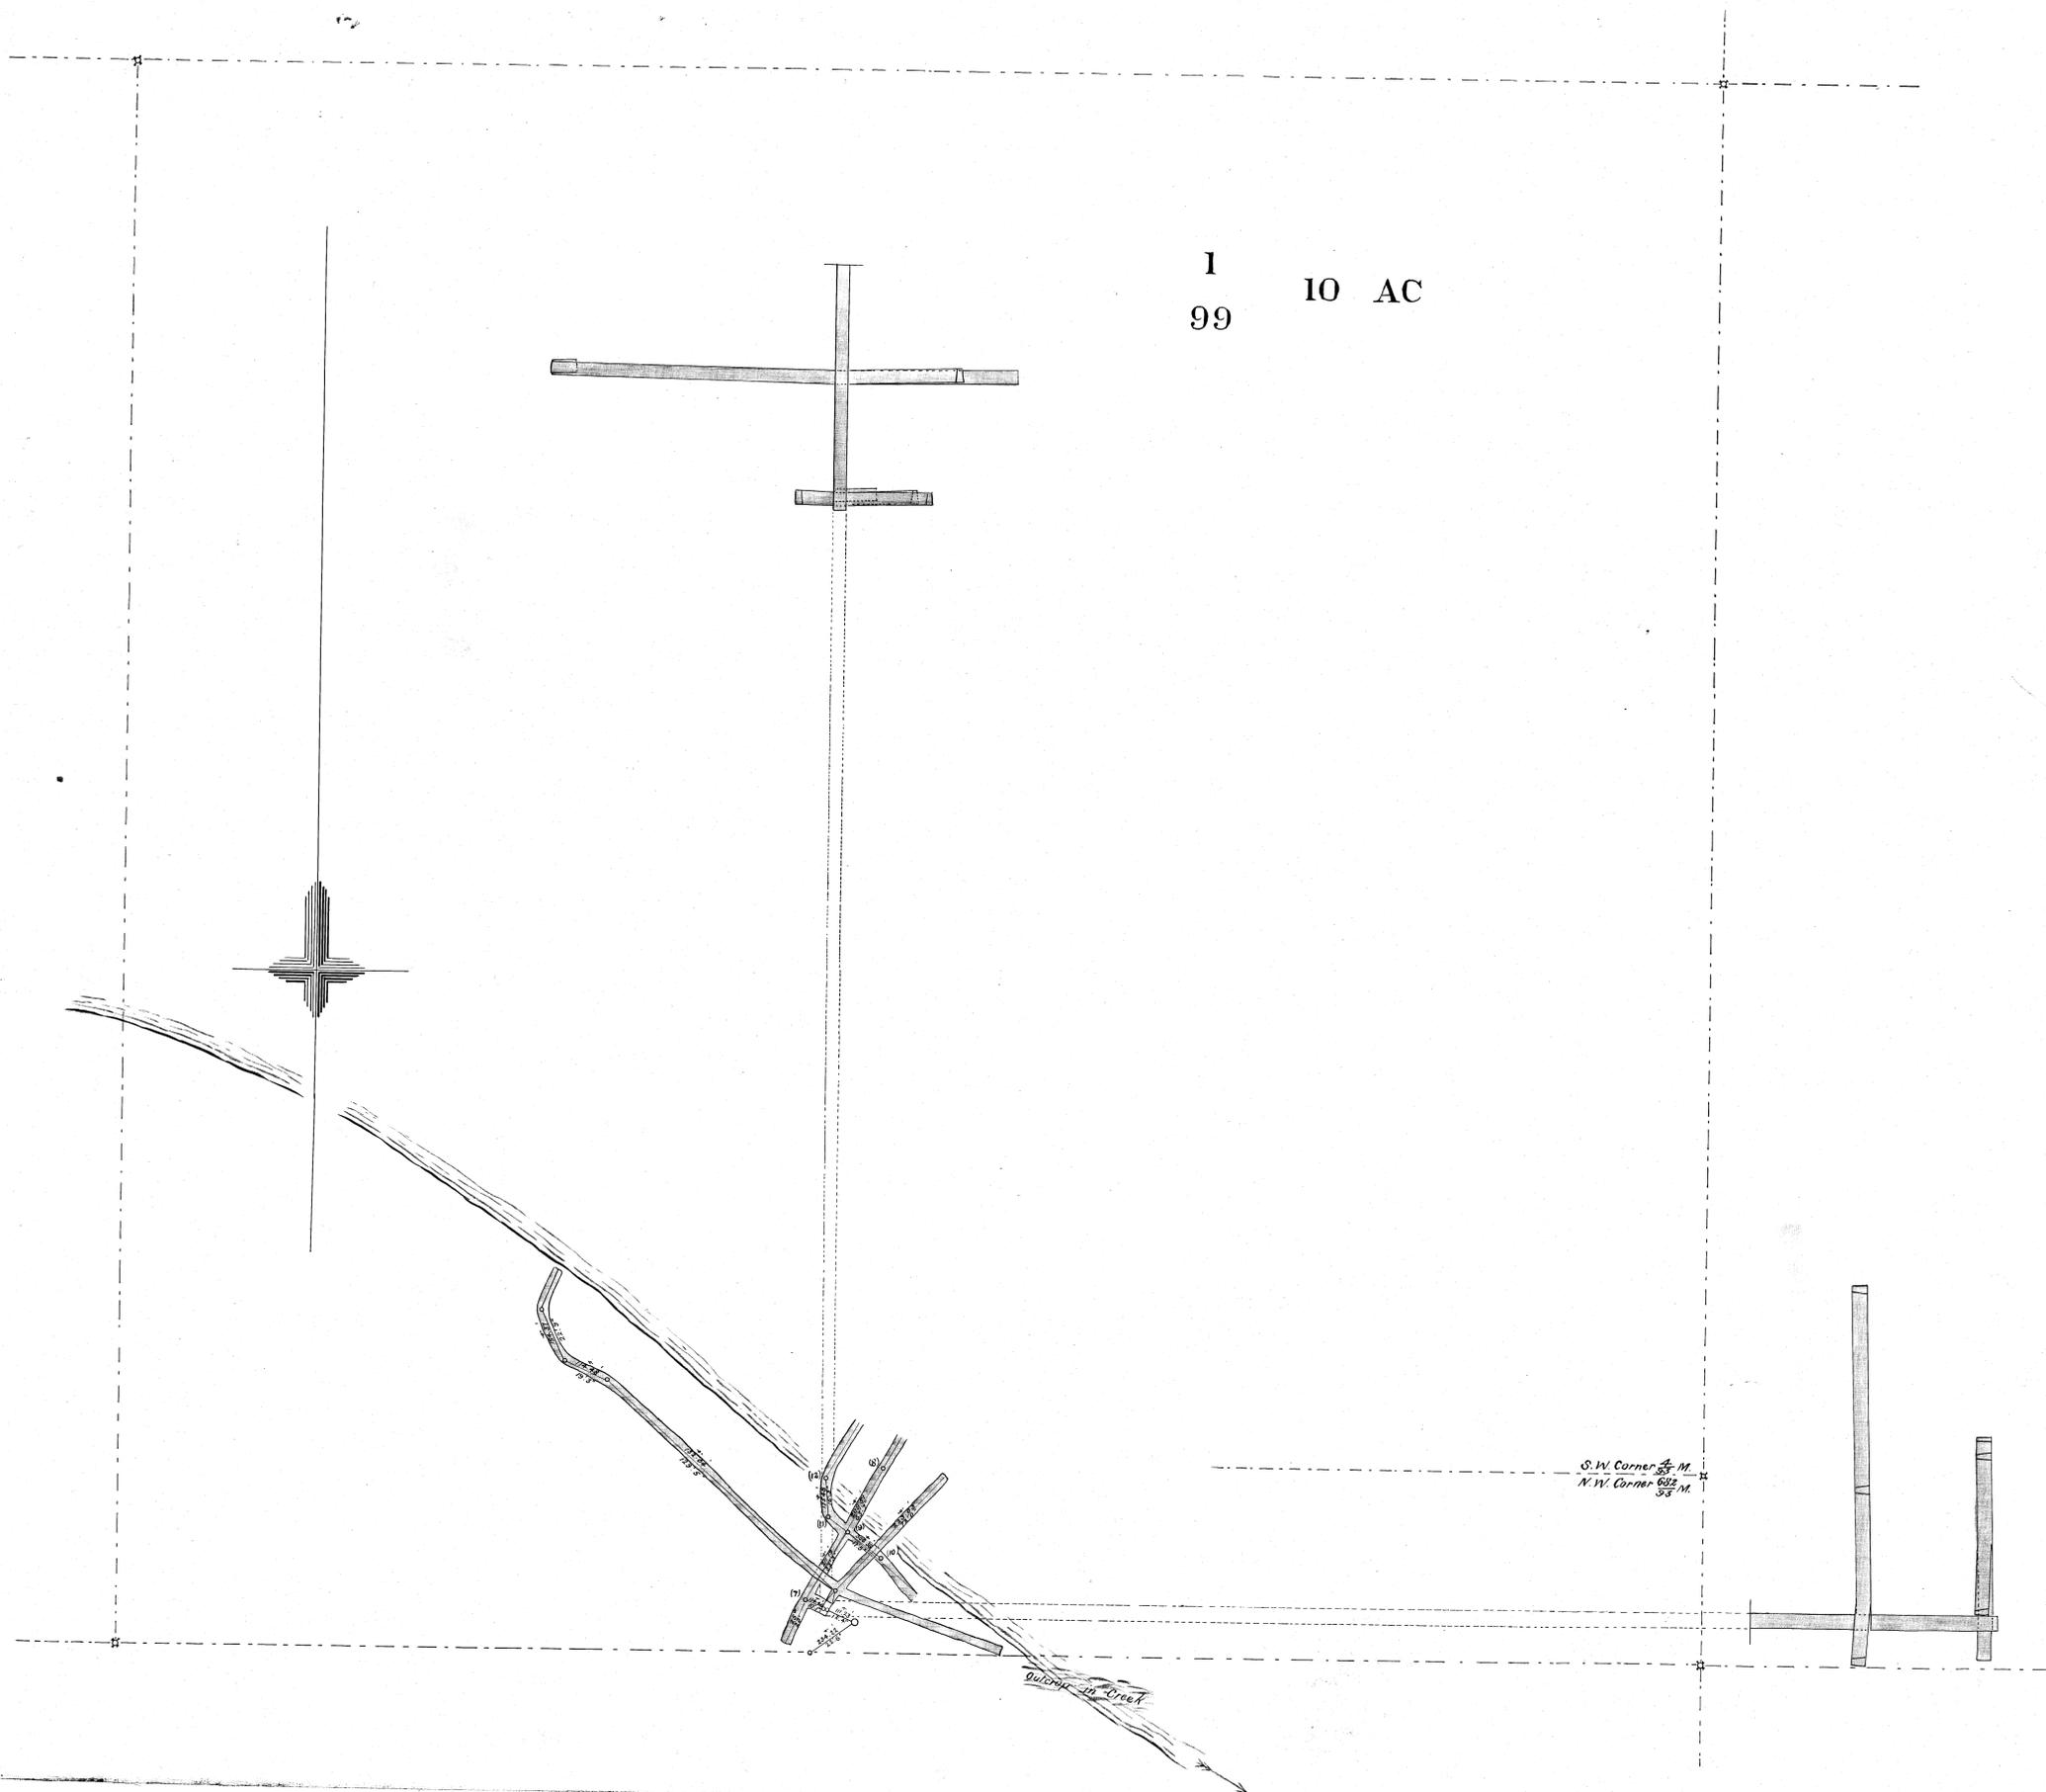

S.W. Corner 1/4 M.
N.W. Corner 1/4 M.

P. M. Walker
Author and Surveyor
Nov. 10. 99

187-07

5m

157-07

2000

1000

55