



UNDERGROUND WORKINGS

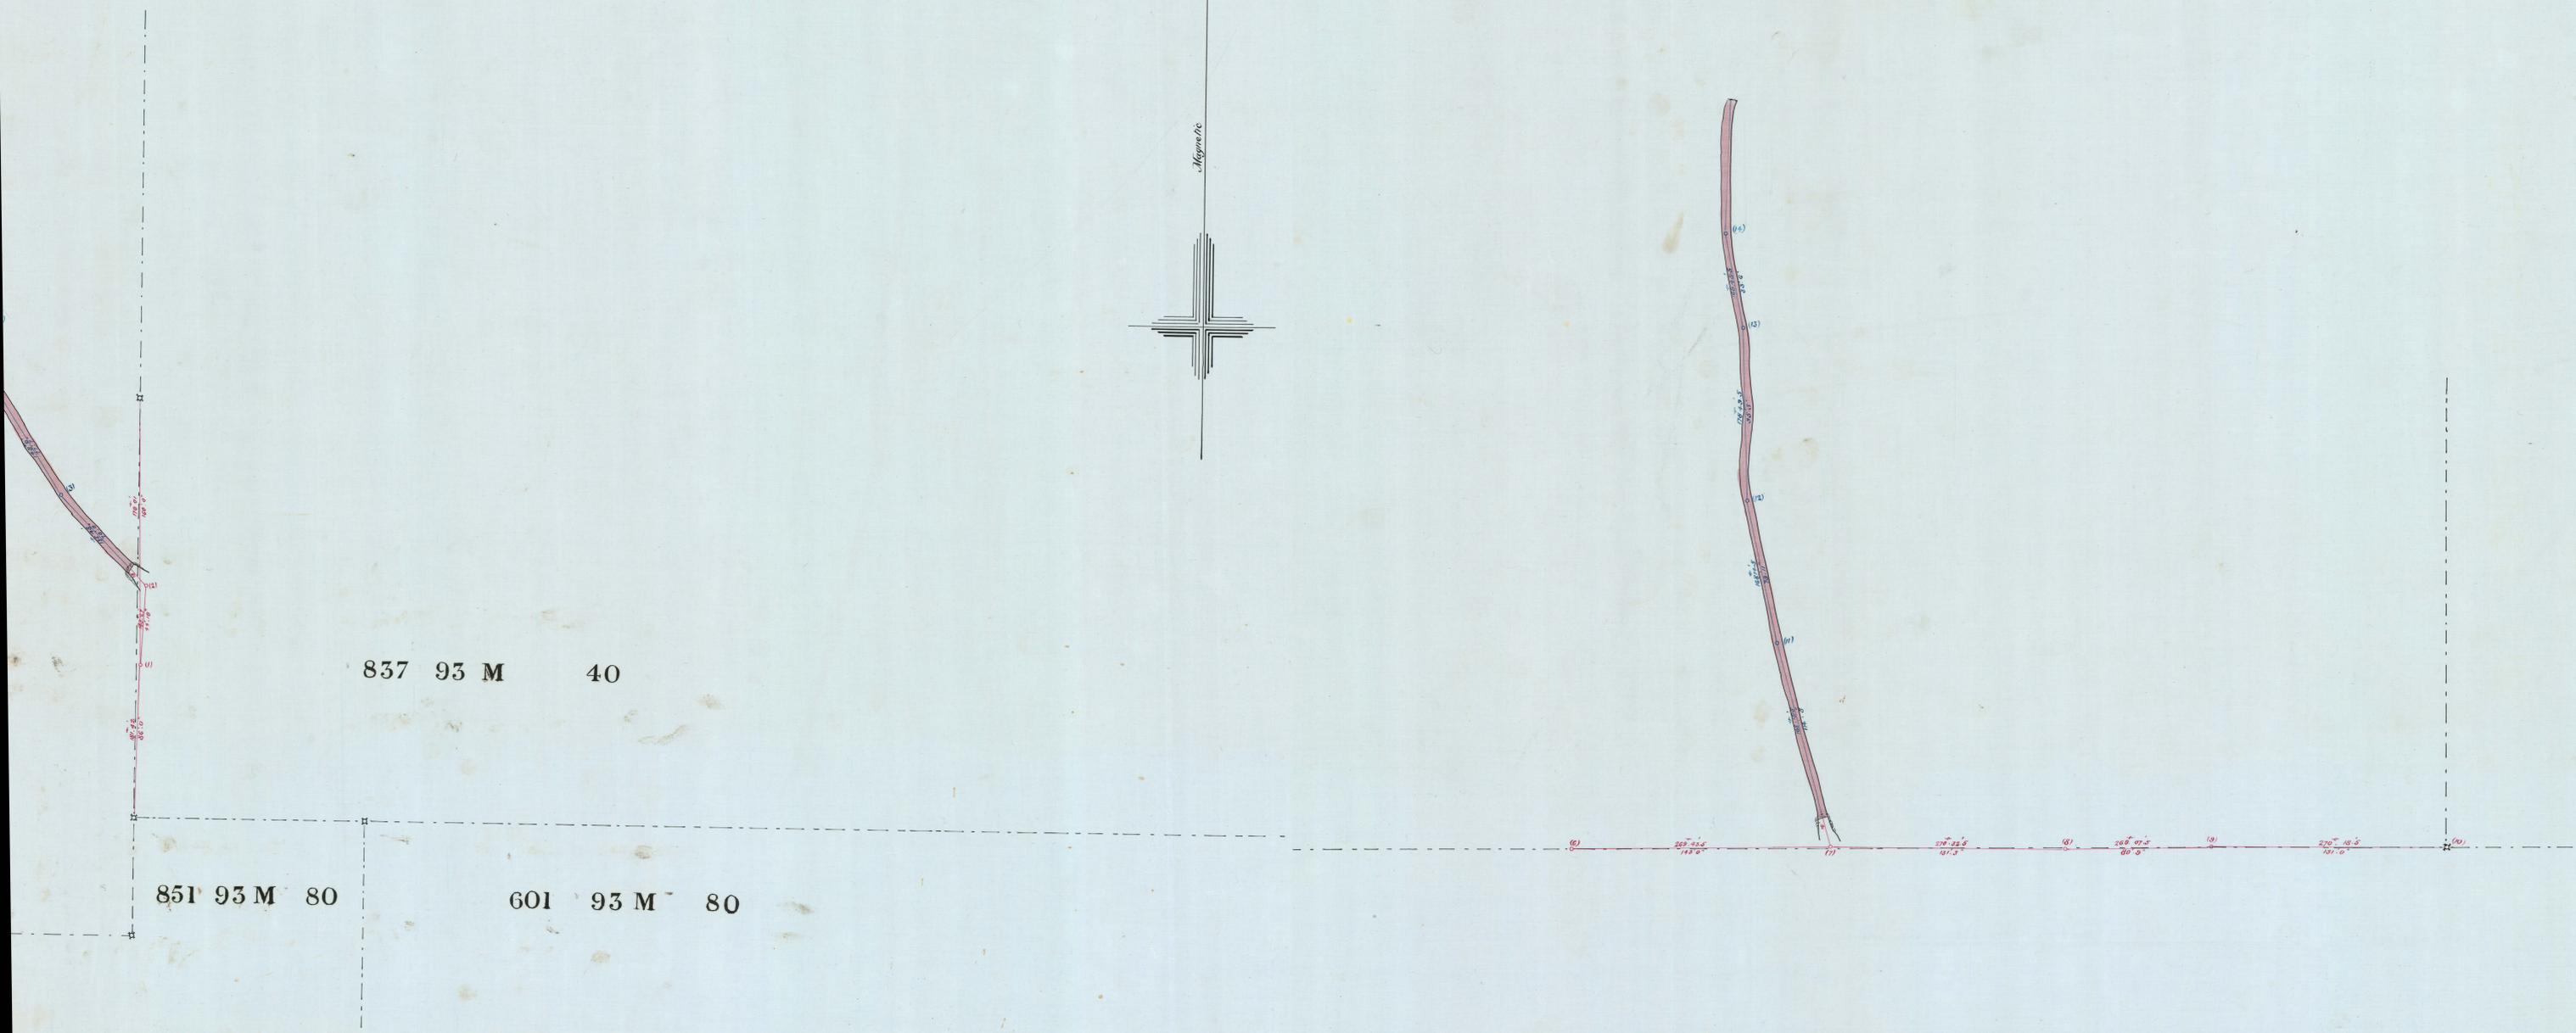

MOUNT LYELL PROPRIETARY MINES LIM

SCALE OF FEET

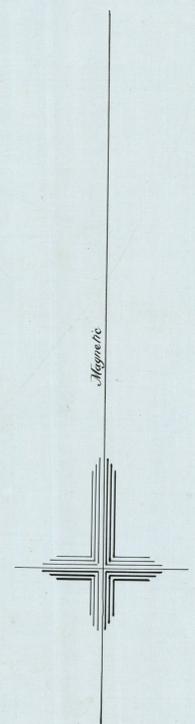

837 93 M 40

851 93 M 80

601 93 M 80

Proprietor
G. W. ...
Apr 1, 1911