
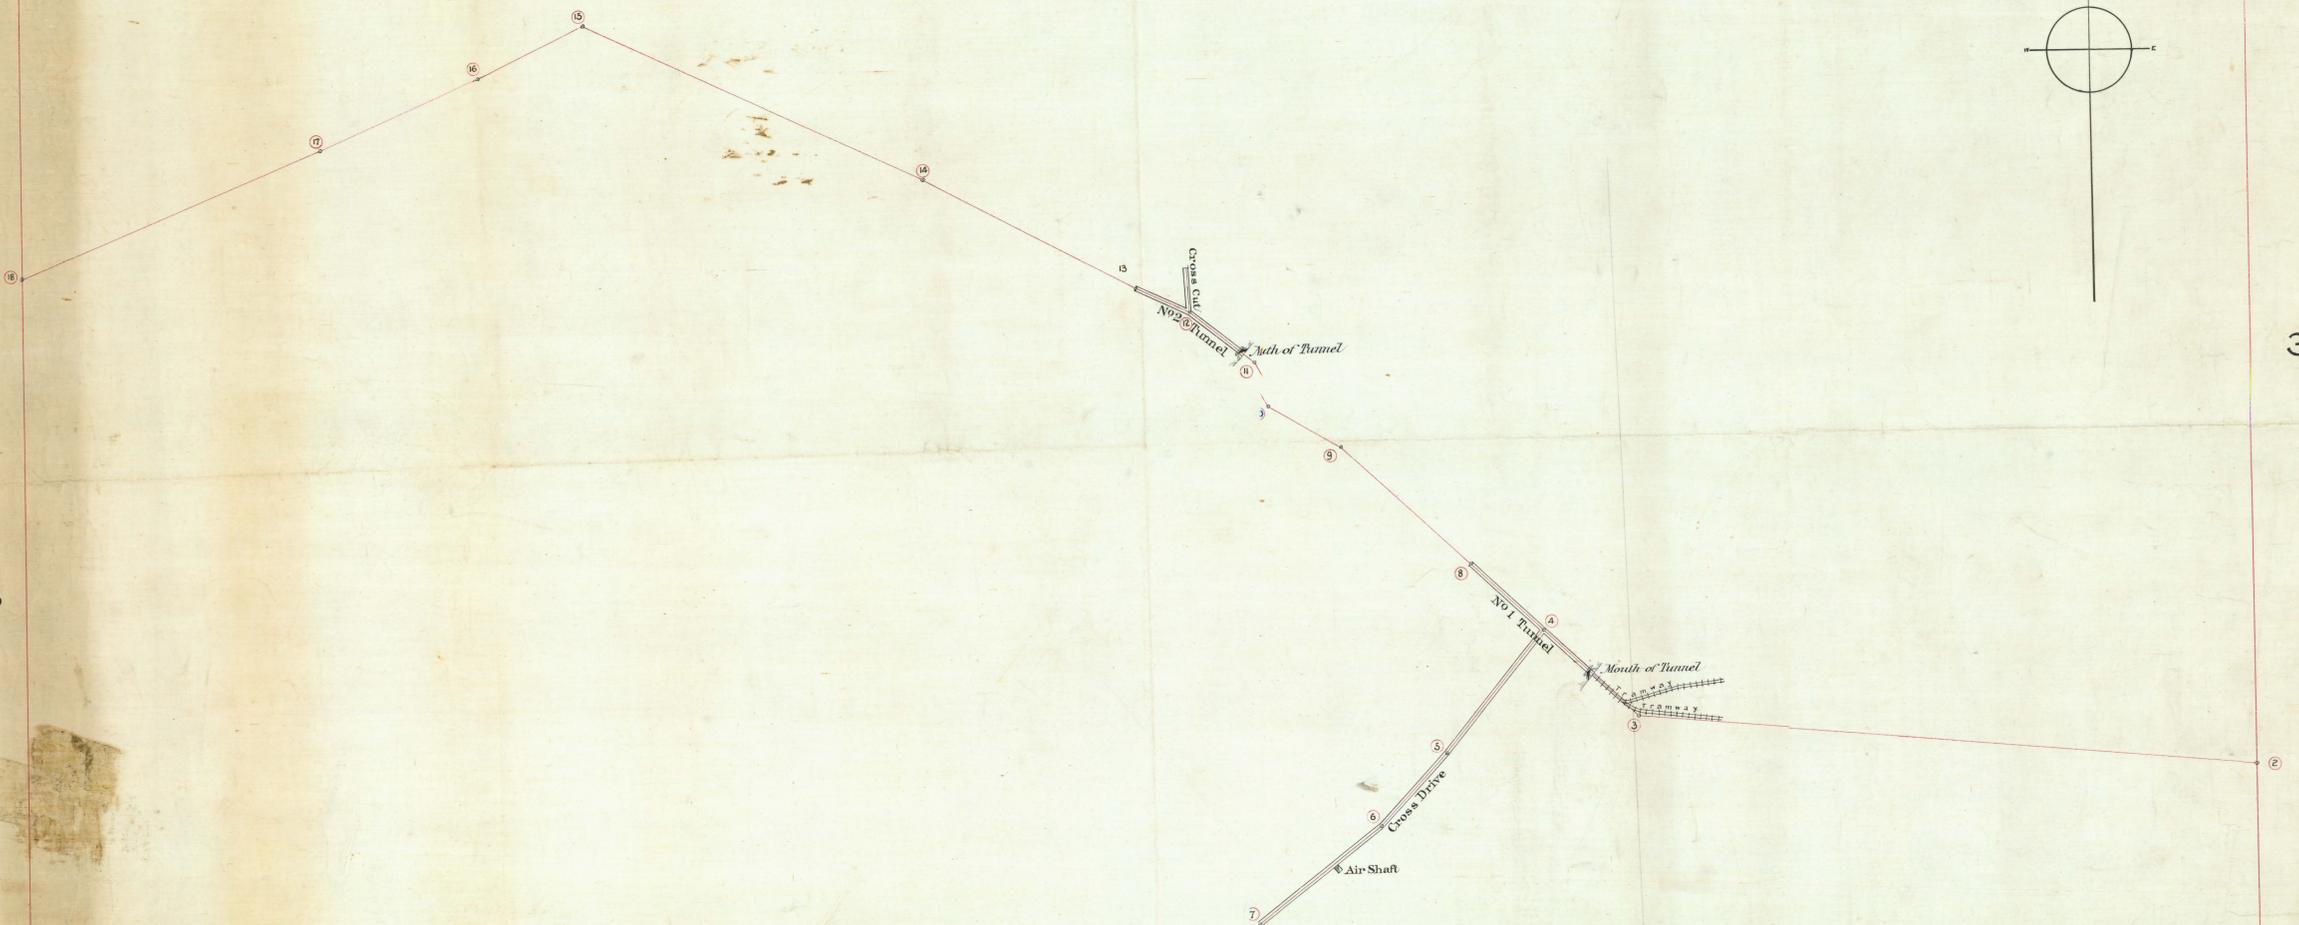


SEC: 2067
87M: 80A.

PLAN & SECTION


Of underground workings
ON THE
WASHINGTONS^R M^G C^O

Scale - Fifty feet to an inch.

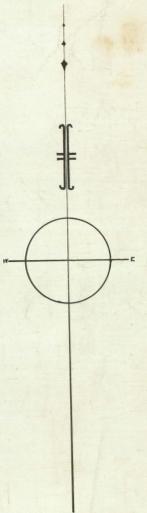

3351

2103

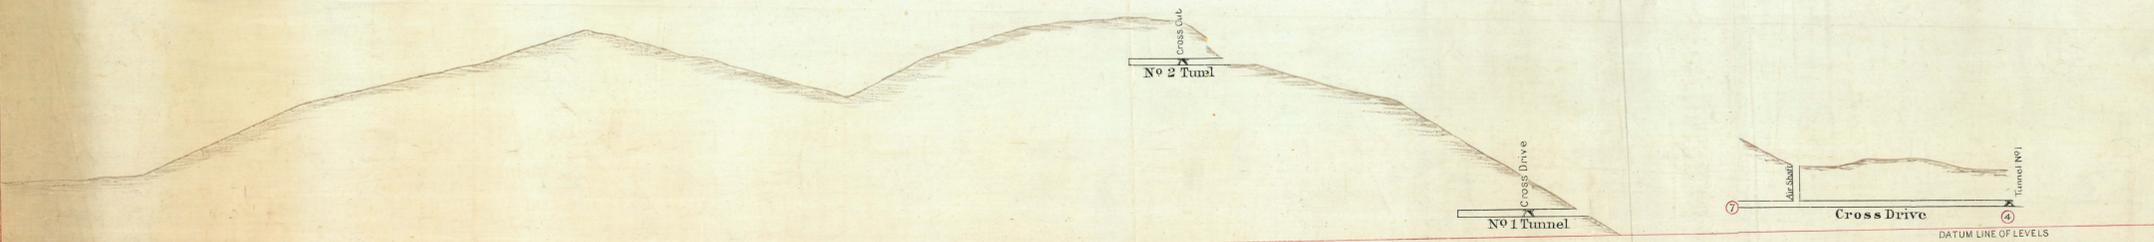

LONGITUDINAL SECTION

I David Jones of Maricopa do hereby declare that the above survey was effected with a four inch transit theodolite and that the surveys were true to correct for the purposes of the Mines Act of 1881.
David Jones
District Surveyor.