


Washington S. M. Company

Scale, fifty feet to an Inch

1893




160-01
700 4 1/2

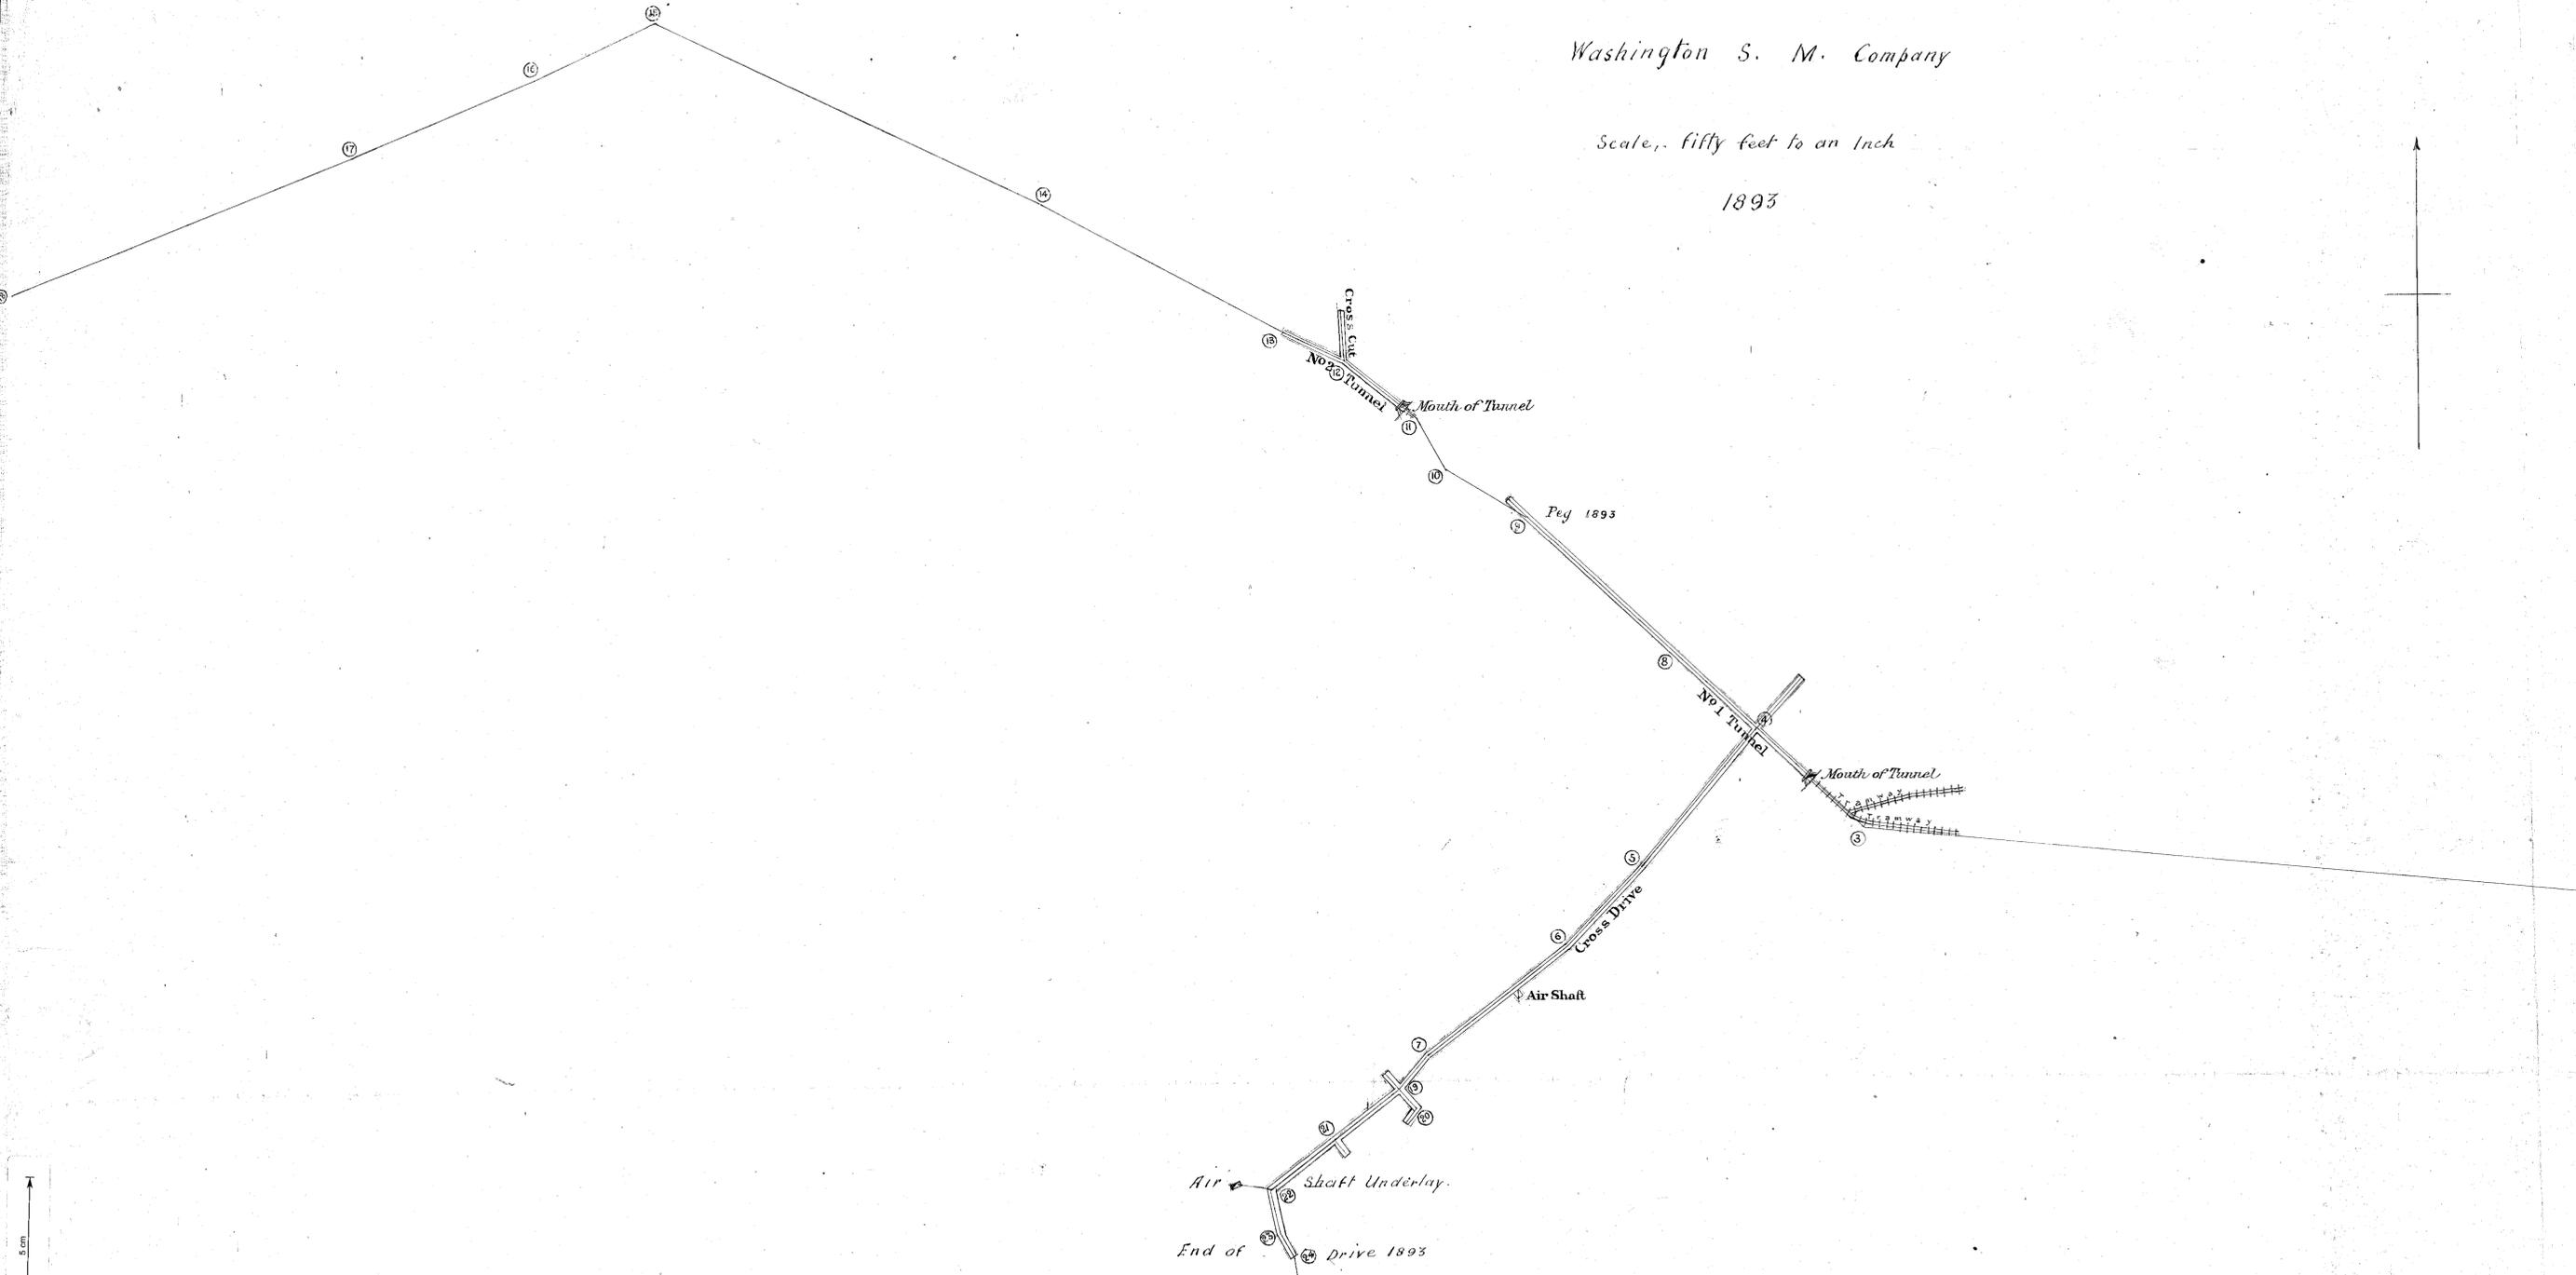

5 cm

160-02

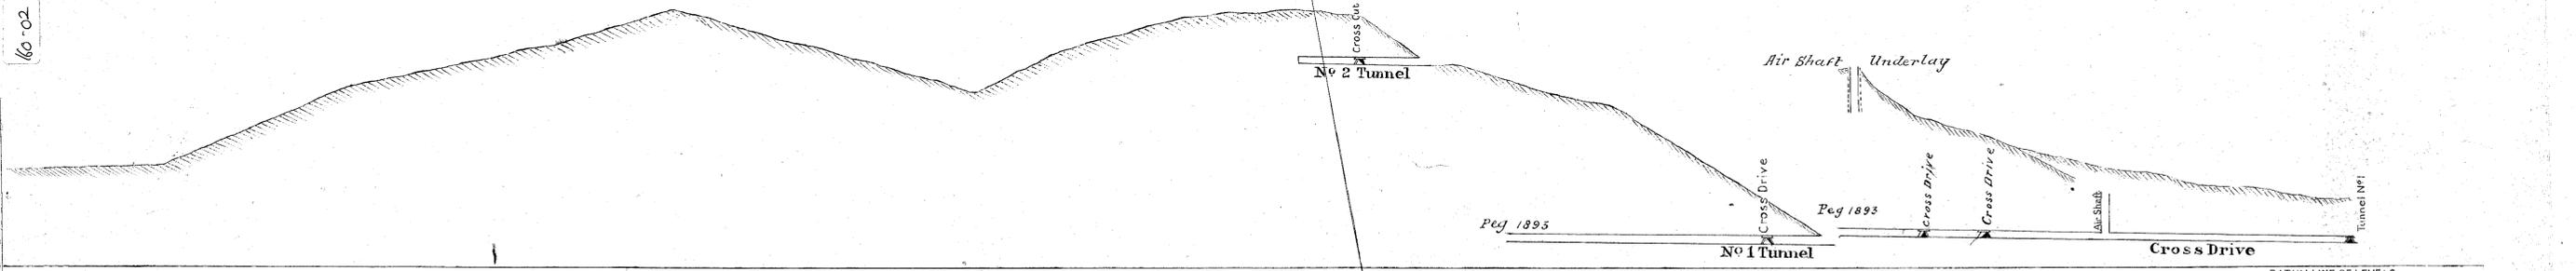

LONGITUDINAL SECTION

DATUM LINE OF LEVELS
Fluvio Jones, Surveyor
January 1893.