


5 cm

161-01

Mc Dowall 154

154

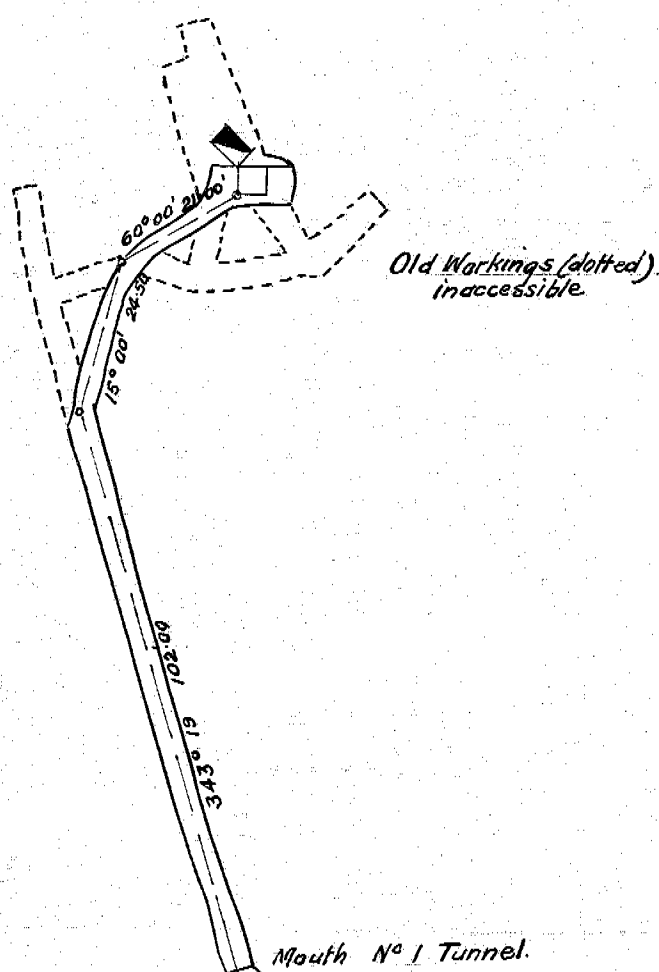

THE
Mc Dowall P.A.


PLAN

showing workings as at
31. 12. 17

Scale 30 ft = 1 in.

No 1 Level Stopping


Scale 15 ft to 1 inch.

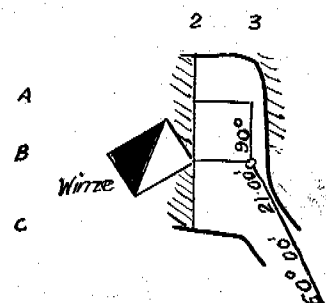


No 1 Level
Square Sets 4'9\"/>



1st floor 6'2\"/>

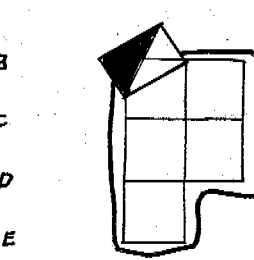

2nd floor 12'4\"/>

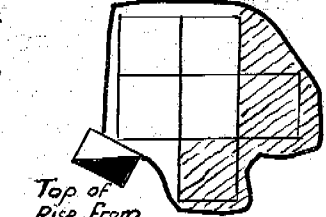

3rd floor 18'6\"/>

Top of
Rise From
No 2 Level.

1 2 3 4

1011
G

83'00"

C Peg

31. 12. 16

W. B. B.
Surveyor
17/5/16

